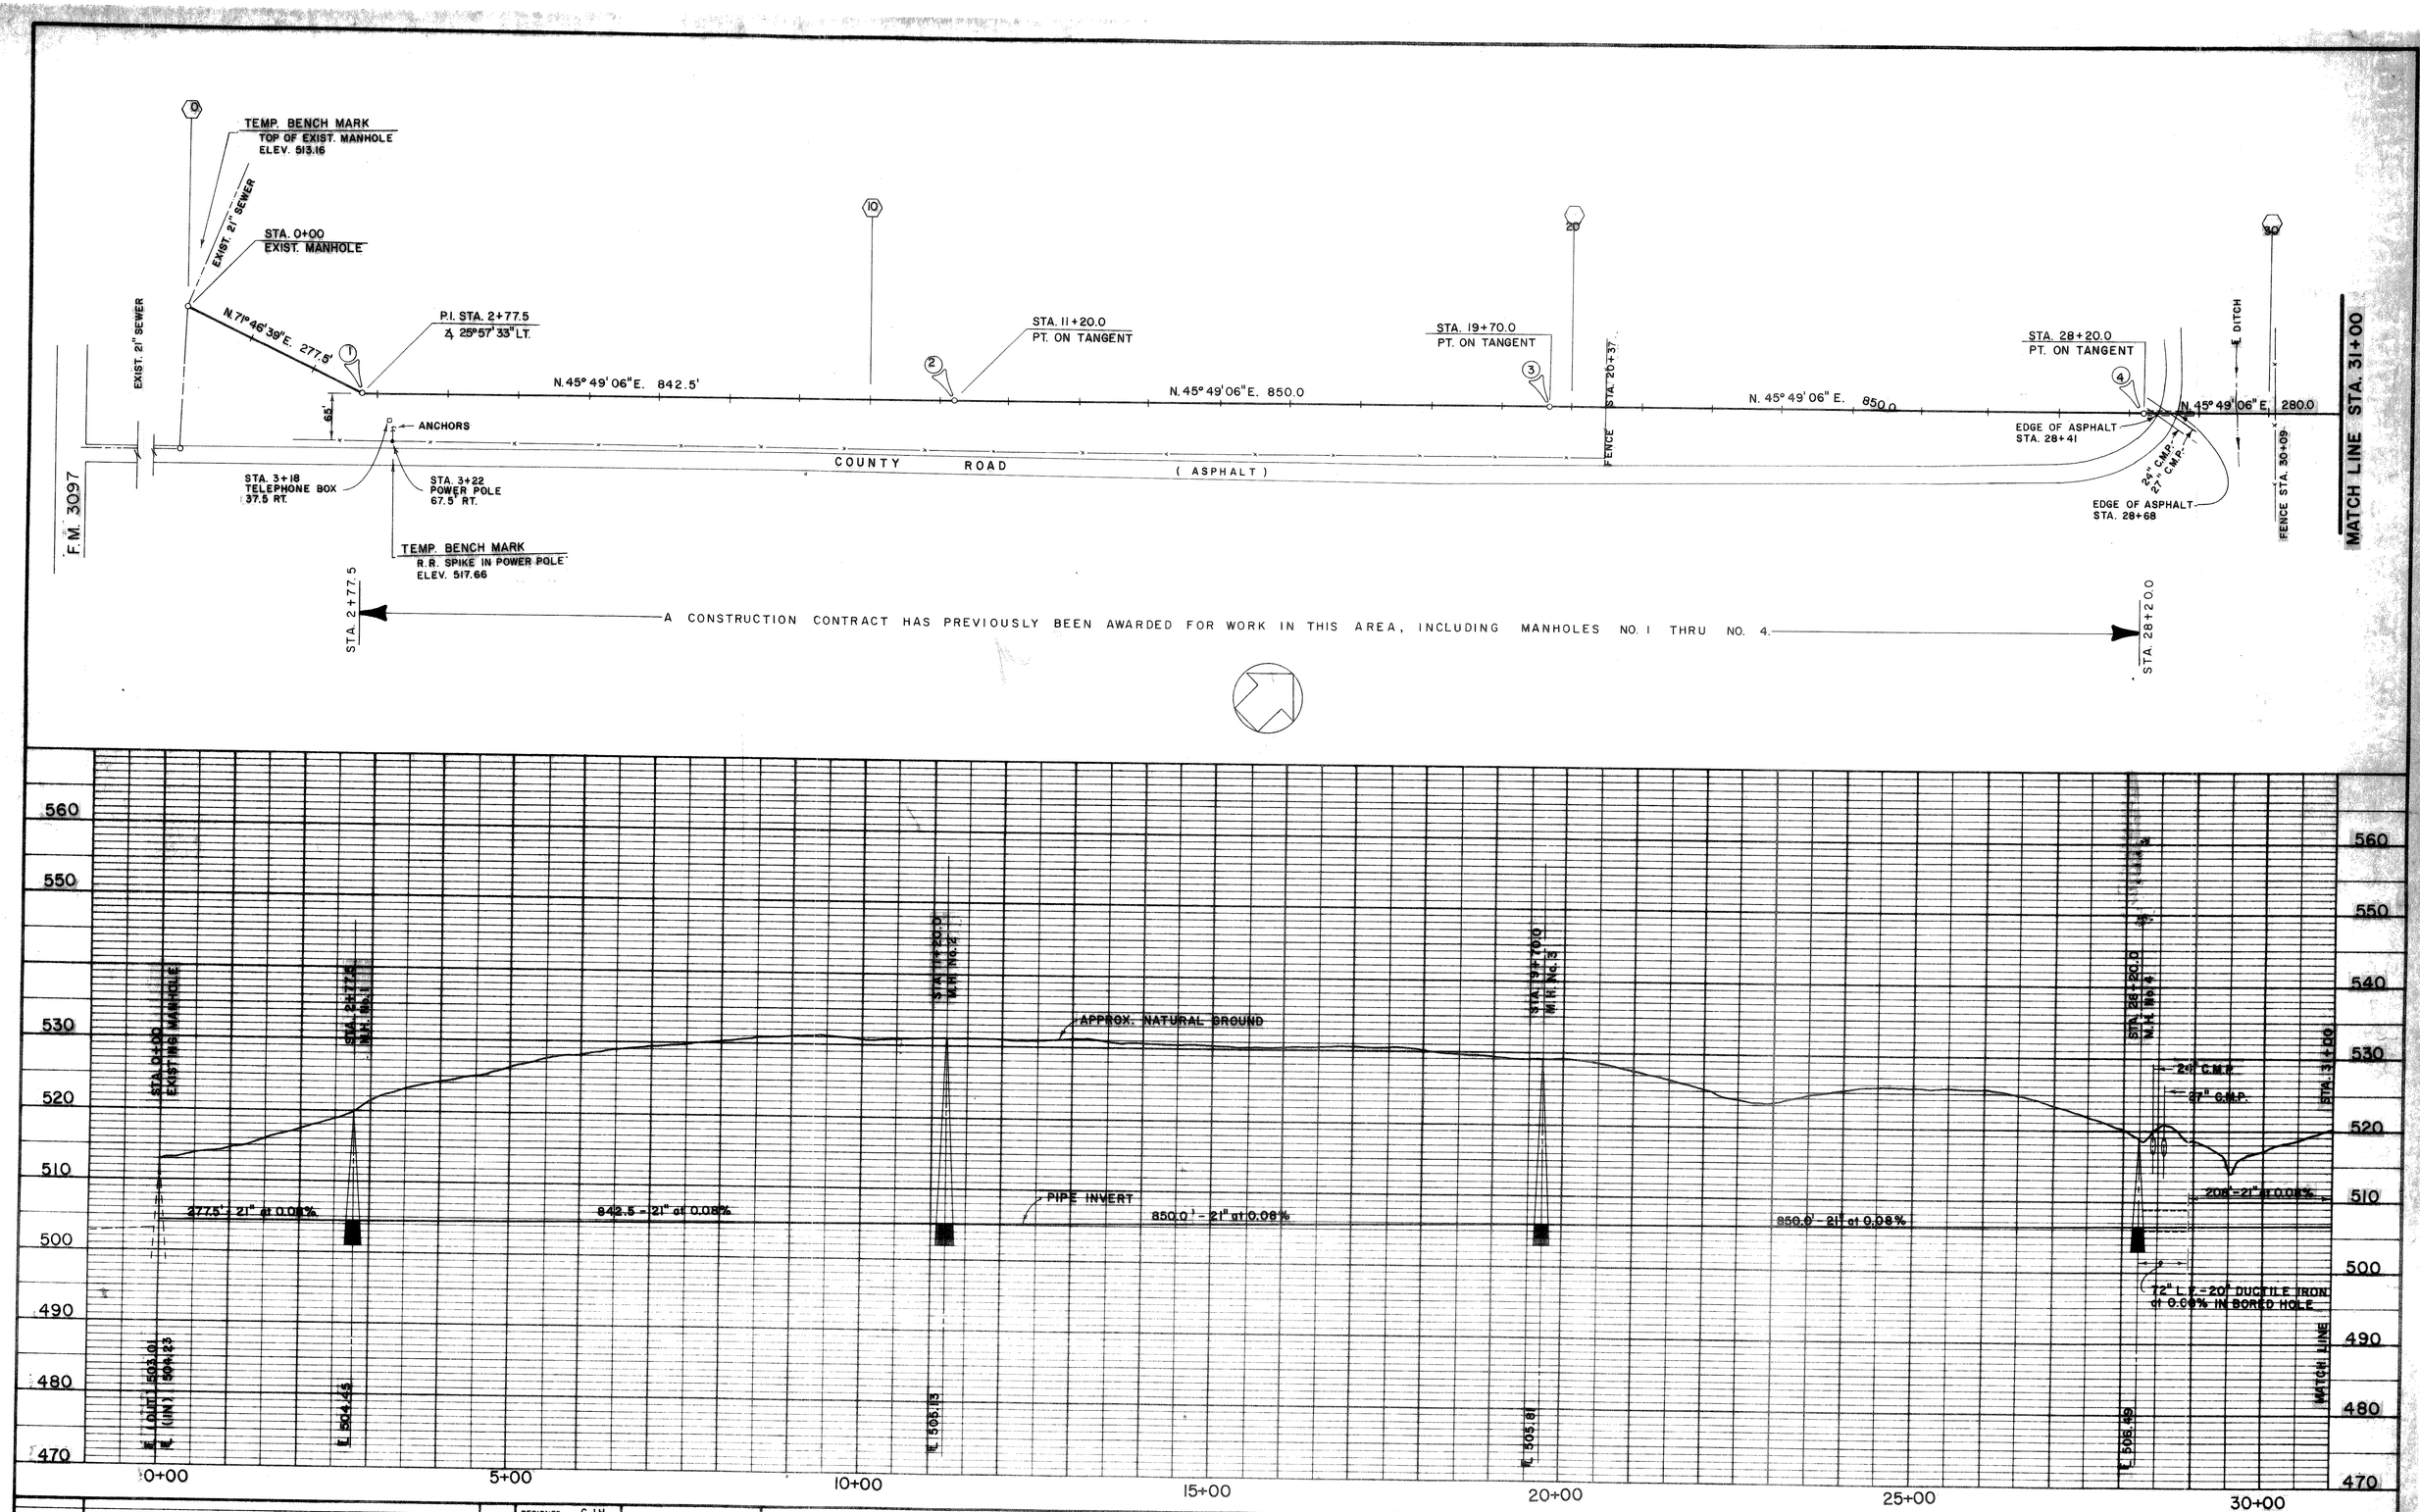

11-3-82 DATE	SECTION NO. 1 EXCLUDED FROM PROJECT. REVISION	C.J.H. BY	DESIGNED C.J.H. DRAWN TRACED C.C. CHECKED C.J.H.	JOB NO. ROK 81169 DATE JUNE 1982 SCALE 1"=100' Horiz. 1"=10' Vert	FREESE AND NICHOLS, INC. CONSULTING ENGINEERS FORT WORTH-AUSTIN, TEXAS	CITY OF ROCKWALL, TEXAS BUFFALO CREEK INTERCEPTOR SEWER

PLAN AND PROFILE - STA. 0+00 TO STA. 31+00

SHEET 2 OF 7