GRAPHIC SCALE

40 0 20 40 80 160

(IN FEET)
1 inch = 40 ft.
1 inch = 4 ft. vertical

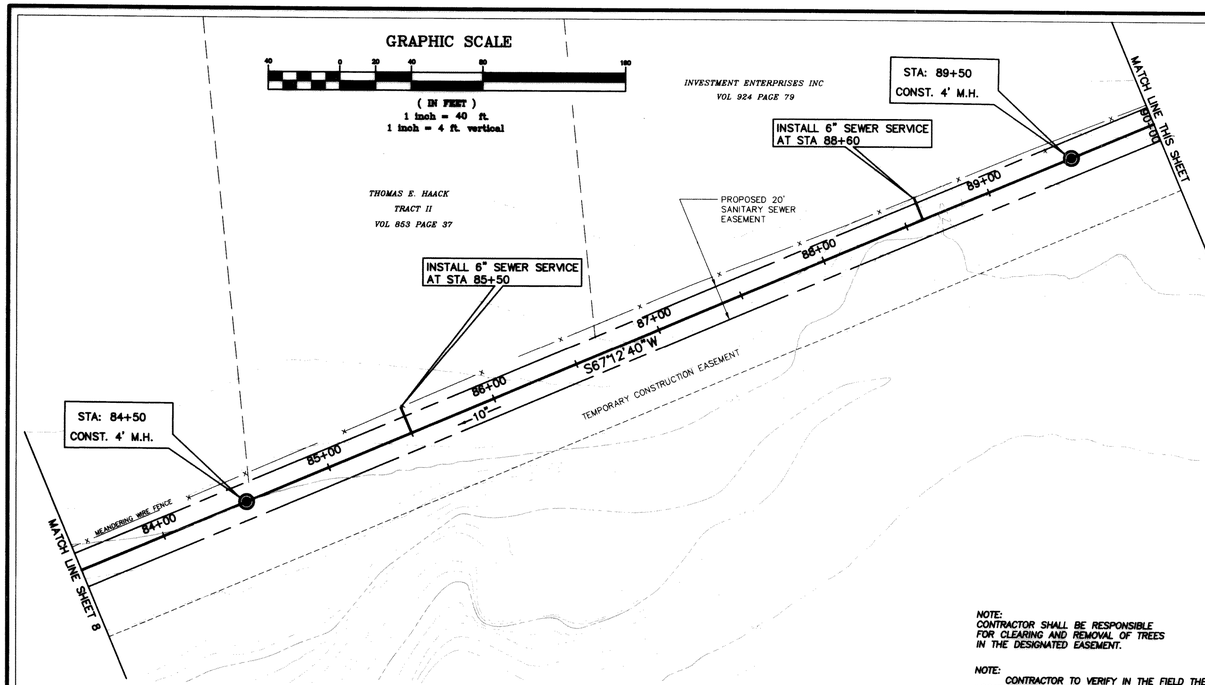

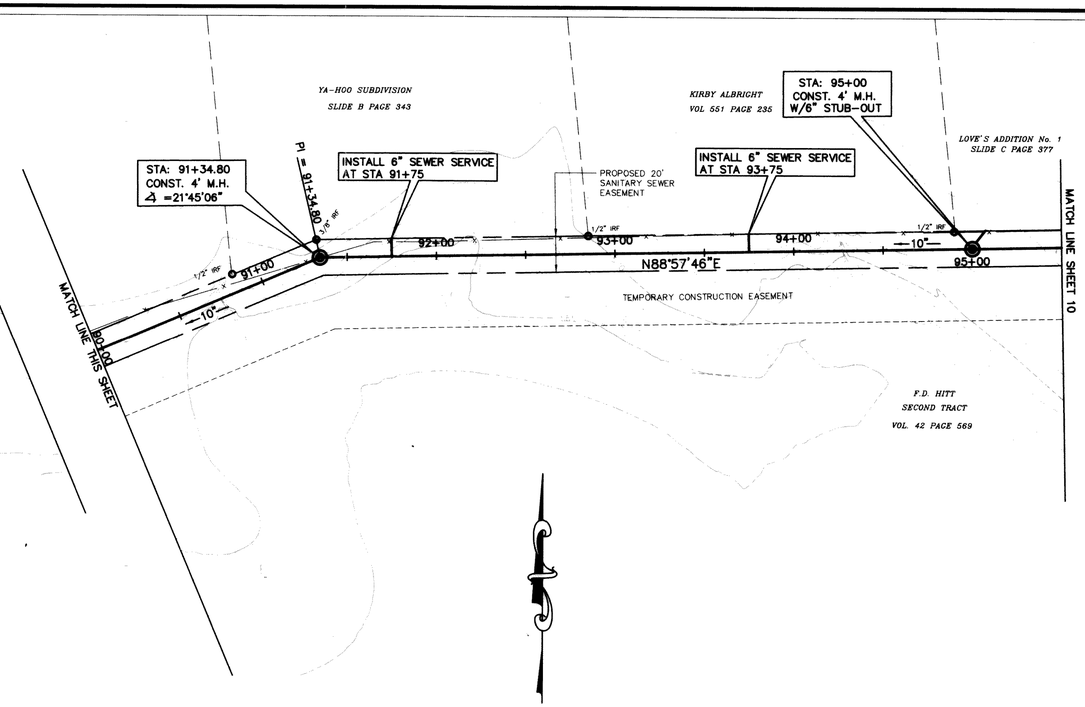

NOTE:
CONTRACTOR SHALL BE RESPONSIBLE FOR CLEARING AND REMOVAL OF TREES IN THE DESIGNATED EASEMENT.

NOTE:
CONTRACTOR TO VERIFY IN THE FIELD THE LOCATION OF ALL EXISTING UTILITIES PRIOR TO CONSTRUCTION. INFORMATION PROVIDED WITHIN THESE PLANS DOES NOT RELIEVE THE CONTRACTOR OF THE FULL AND TOTAL RESPONSIBILITY FOR THE PROTECTION OF EXISTING UTILITIES NOR ANY DAMAGES CAUSED BY SAID CONTRACTOR DURING CONSTRUCTION.

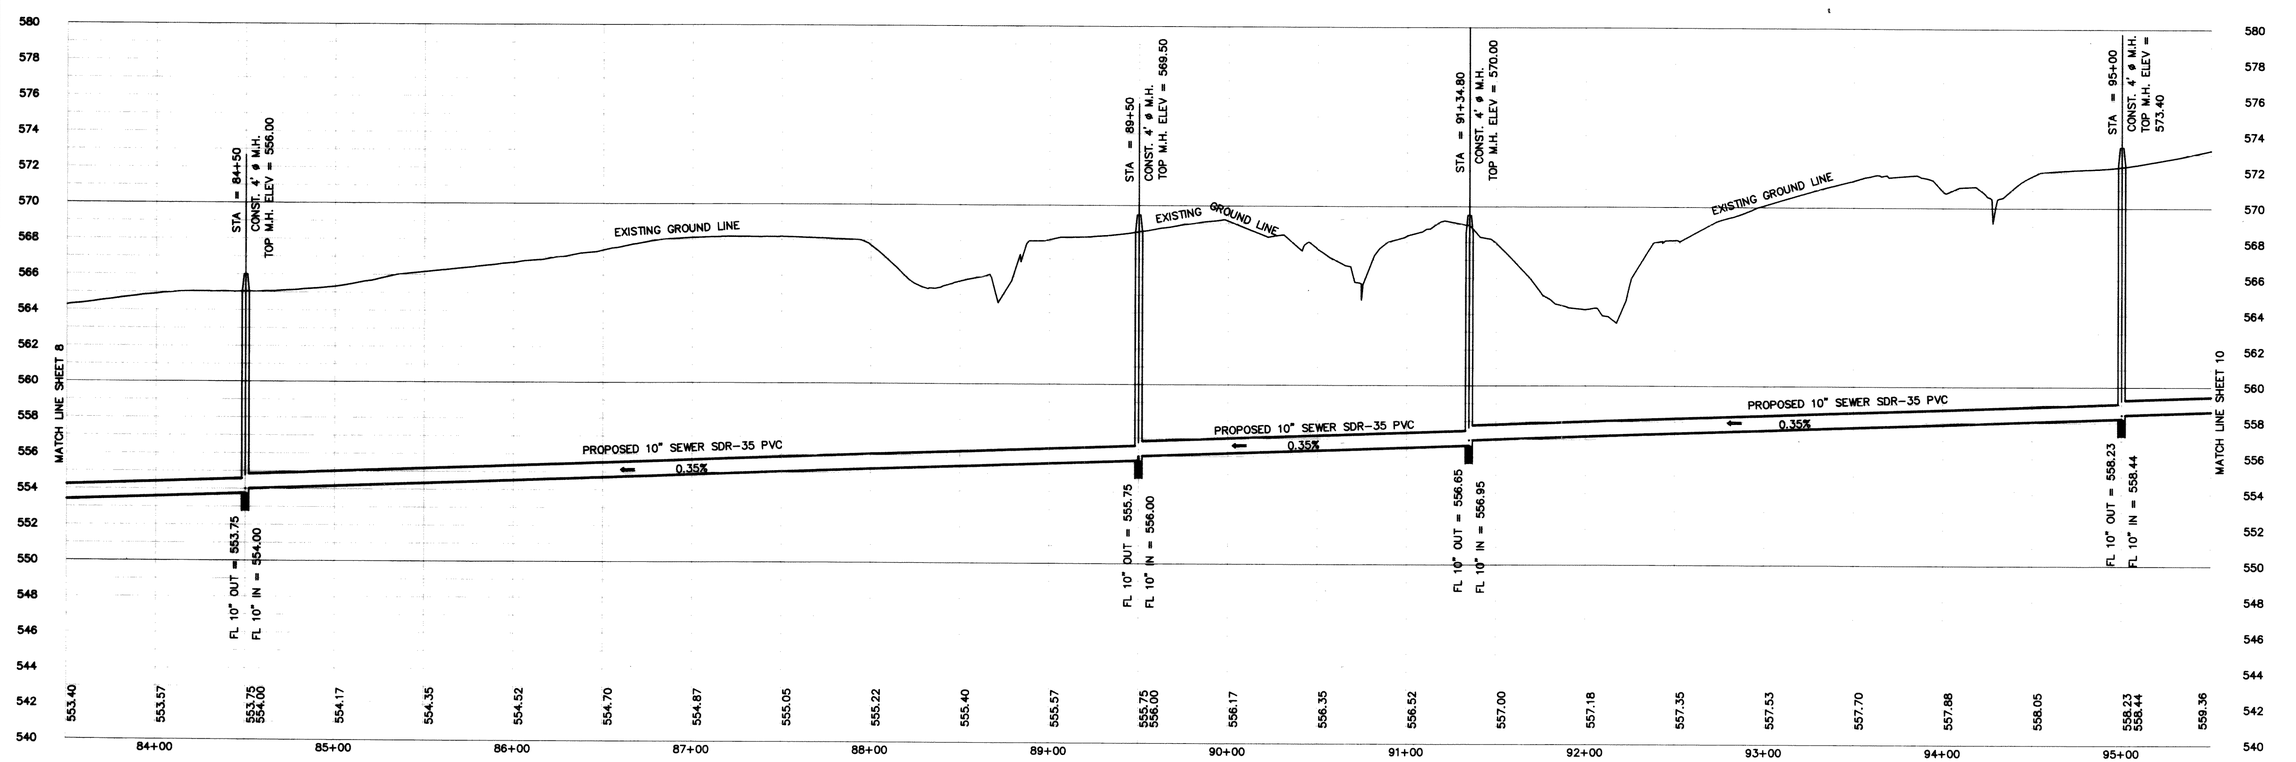

DOUPHRATE & ASSOCIATES
ENGINEERING - SURVEYING - CONSTRUCTION MANAGEMENT
P.O. BOX 1336 ROCKWALL, TEXAS 75087
PHONE: (972)771-9004 FAX: (972)771-9005

THE SEAL APPEARING ON THIS DOCUMENT WAS AUTHORIZED BY W.L. DOUPHRATE II TEXAS P.E. NO. 60102 ON 7/9/97

REGISTERED PROFESSIONAL ENGINEER
W. L. DOUPHRATE II
60102

BUFFALO CREEK
10" & 12" SANITARY SEWER EXTENSION
CITY OF ROCKWALL
ROCKWALL COUNTY, TEXAS

REVISION	
W.L.D.	CHECKED
K.E.B.	DRAWN
7/10/97	DATE
9606FP08	PROJECT
9	OF