LEGEND

B.	BOLLARD	CO	CLEANOUT
EM	ELECTRIC METER	MH	MANHOLE
PP	POWER POLE	TSC	TRAFFIC SIGNAL CONTROL
LS	LIGHT STANDARD	TSP	TRAFFIC SIGNAL POLE
WM	WATER METER	TELE	TELEPHONE BOX
WV	WATER VALVE	SIGN	TRAFFIC SIGN
ICV	IRRIGATION CONTROL VALVE		PROPERTY LINE
FH	FIRE HYDRANT		SAWCUT LINE
			PHASE 1 CONSTRUCTION NOT THIS CONTRACT

TXDOT CONCRETE REFERENCE TXDOT STANDARD DETAILS

PARKING, DRIVE LANES, & PLAZA AREAS 8" REINFORCED CONCRETE PAVEMENT (CLASS "C", 3600 PSI) MIN 6.5 SACK

STREETS & DUMPSTER PADS 6" REINFORCED CONCRETE PAVEMENT (CLASS "C", 3600 PSI) MIN 6.5 SACK

PROPOSED PLAZA AREA REFER TO ARCH PLANS FOR DETAILS

0 25 50 100 150
GRAPHIC SCALE IN FEET

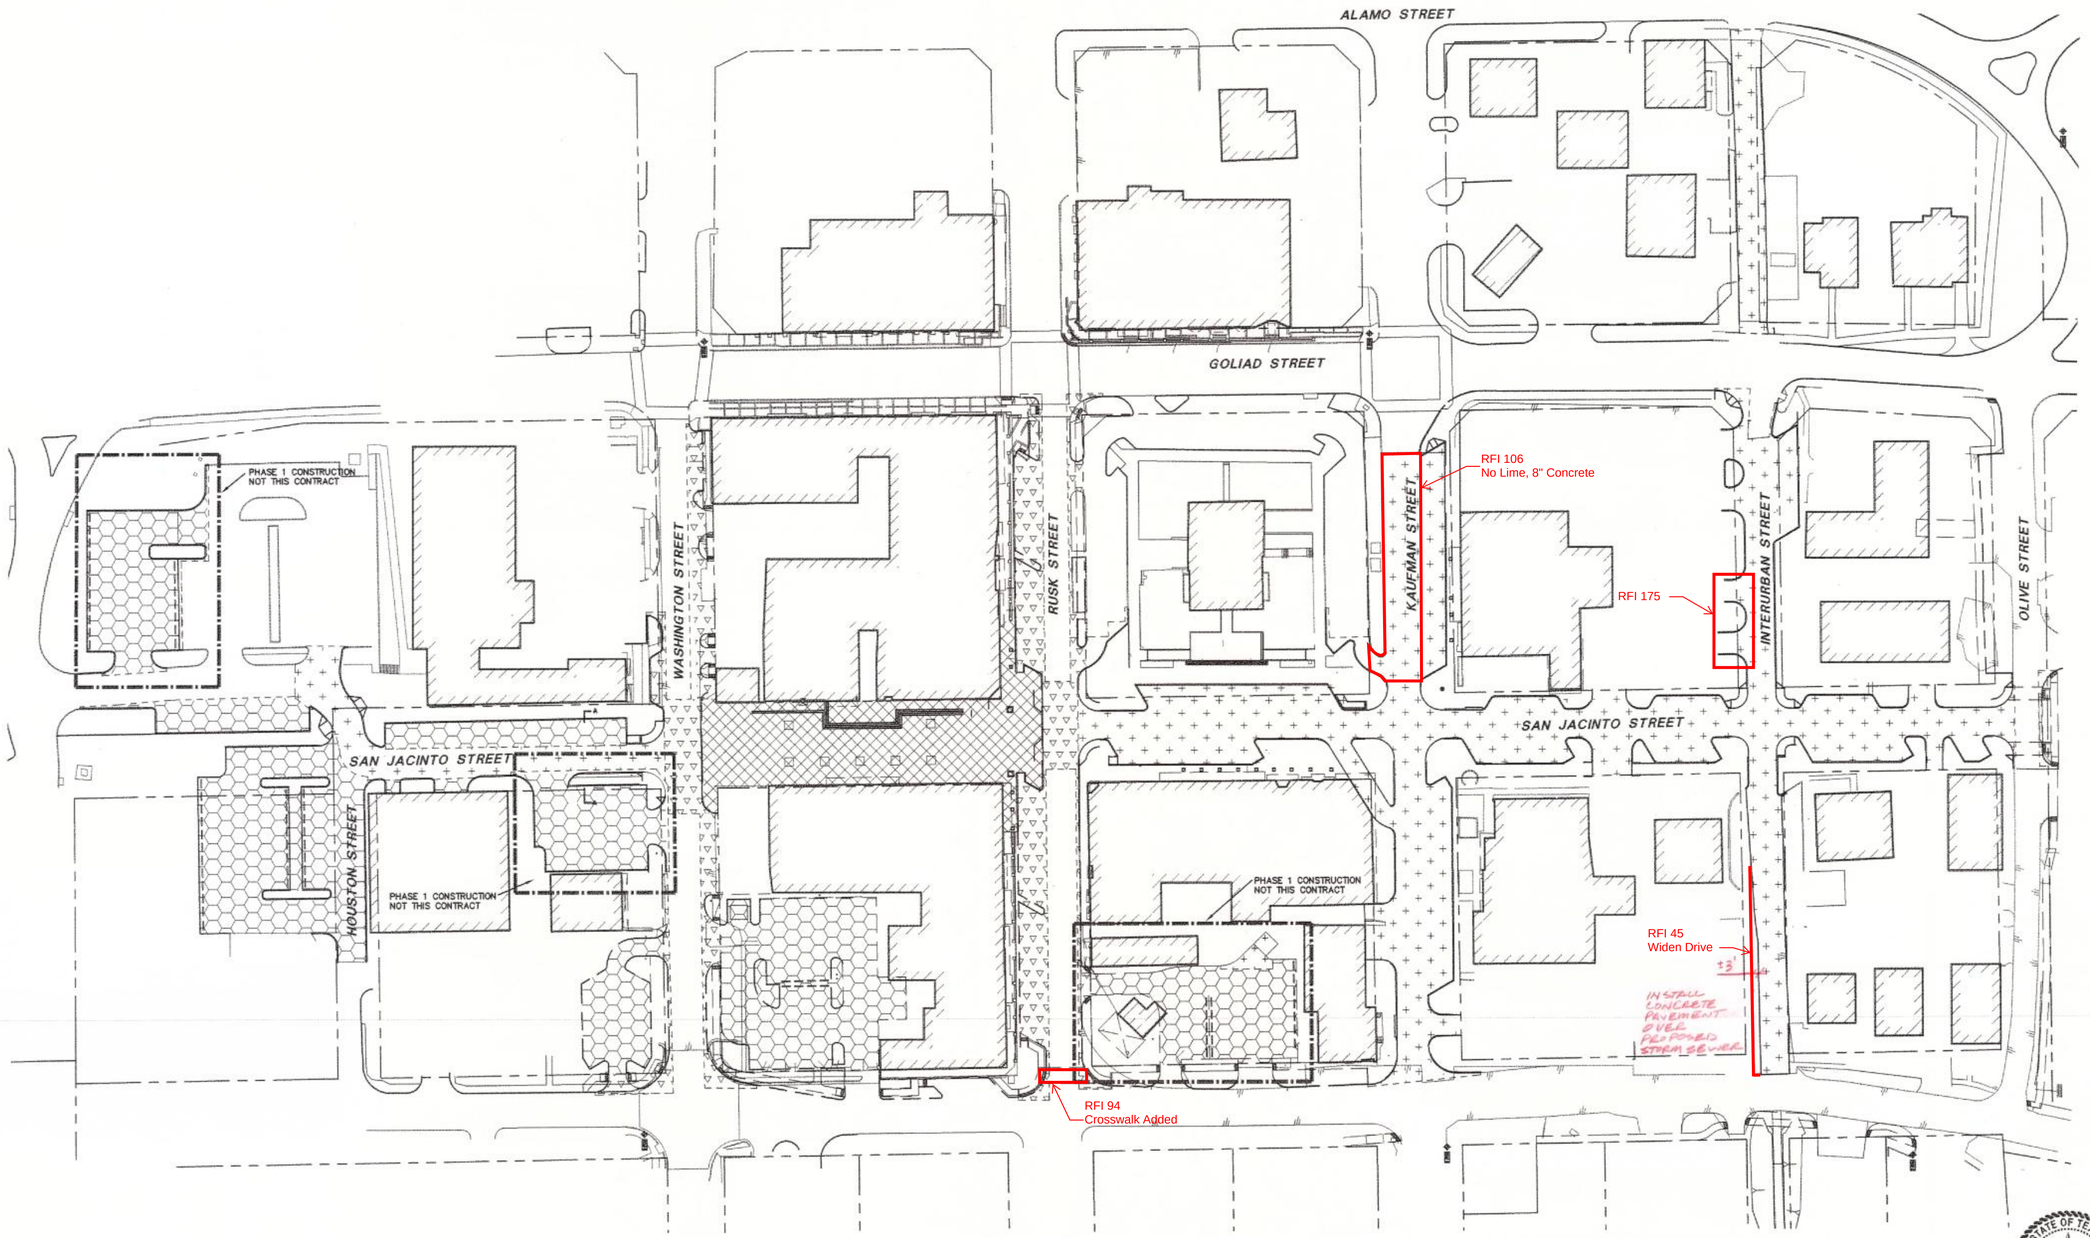

STATE OF TEXAS
CHRISTOPHER M. JONES
82681
REGISTERED PROFESSIONAL ENGINEER
2/26/14

THE SEAL APPEARING ON THIS DOCUMENT WAS AUTHORIZED BY CHRISTOPHER M. JONES, P.E. 82681 ON 02/26/2014. ALTERATION OF A SEALED DOCUMENT WITHOUT PROPER NOTIFICATION TO THE RESPONSIBLE ENGINEER IS AN OFFENSE UNDER THE TEXAS ENGINEERING PRACTICE ACT.

la terra studio
Pacheco Koch
DALLAS • FORT WORTH • HOUSTON
EA ENGINEERING ASSOCIATES

Downtown Rockwall

la terra studio Project #12024

streetscape improvements

PHASE 2

rockwall, texas

submittals / revisions

no.	date	detail

la terra studio, inc.

12024
lts project number

02.26.2014
date

JHB
drawn by

CMJ
checked by

registration

sheet title
Site Paving Plan

sheet number
C1-1

AS BUILT
03/07/2016

© 2012 la terra studio, inc. All Rights Reserved FILE: