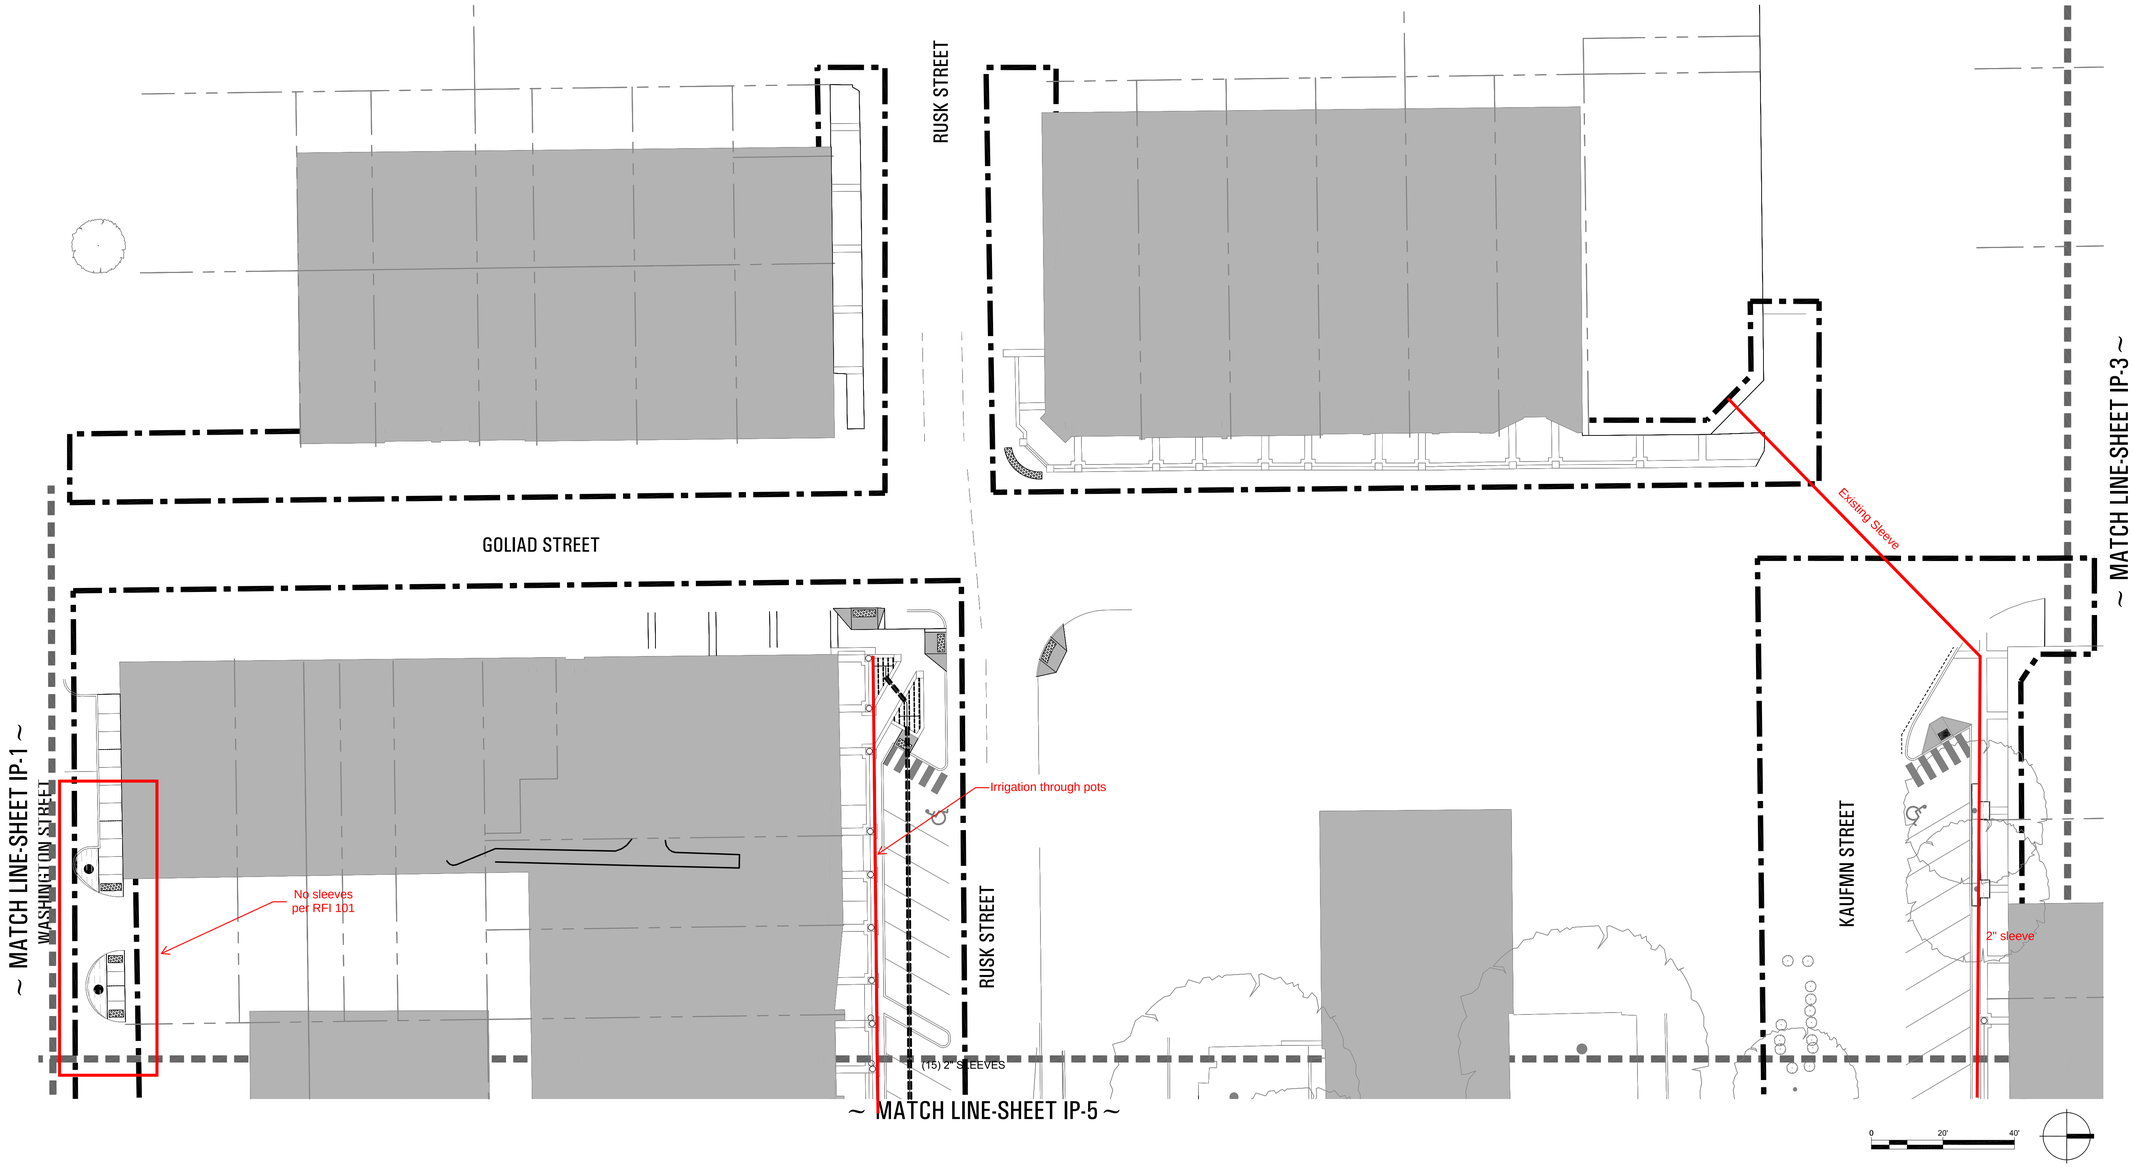


© 2012 la terra studio, inc. All Rights Reserved FILE:E:\100% CD's Revisions dated 2.26.14_Downtown Rockwall\Irrigation Plans.dwg

la terra studio sm

Pacheco Koch
DALLAS • FORT WORTH • HOUSTON

EA ENGINEERING ASSOCIATES

SETH HEIDMAN
IRRIGATION DESIGN & CONSULTING, LLC
6509 W. Parker Rd. #149-225, Plano, Texas 75093 Tel: 972-816-5141

Irrigation in Texas is regulated by the Texas Commission of Environmental Quality (TCEQ), MC-178, P.O. Box 13087, Austin, Texas, 78711-3087. TCEQ website is: www.tceq.state.tx.us

sheet location




# Downtown Rockwall

*Project #12024 ~ renovation ~*

## *streetscape improvements*

rockwall, texas

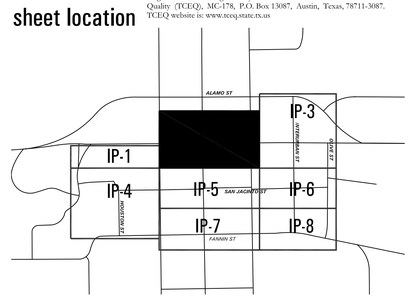submittals / revisions

| no. | date | detail |
|---|---|---|
| | | |
| | | |
| | | |
| | | |
| | | |
| | | |
| | | |
| | | |

la terra studio, inc.

12024
lts project number

02.26.2014
date

SAH
drawn by

SAH
checked by

registration

STATE OF TEXAS
SETH A. HEIDMAN
5881
LICENSED IRRIGATOR
2-26-14

sheet title

**Irrigation Plan**

sheet number

# IP-2

AS BUILT
03/07/2016