


## SITE PLAN LEGEND:

- EDGE OF PAVEMENT
- CONCRETE SIDEWALK PAVEMENT
- CONCRETE VEHICULAR PAVEMENT
- TYPICAL LIGHT FIXTURE

sheet location

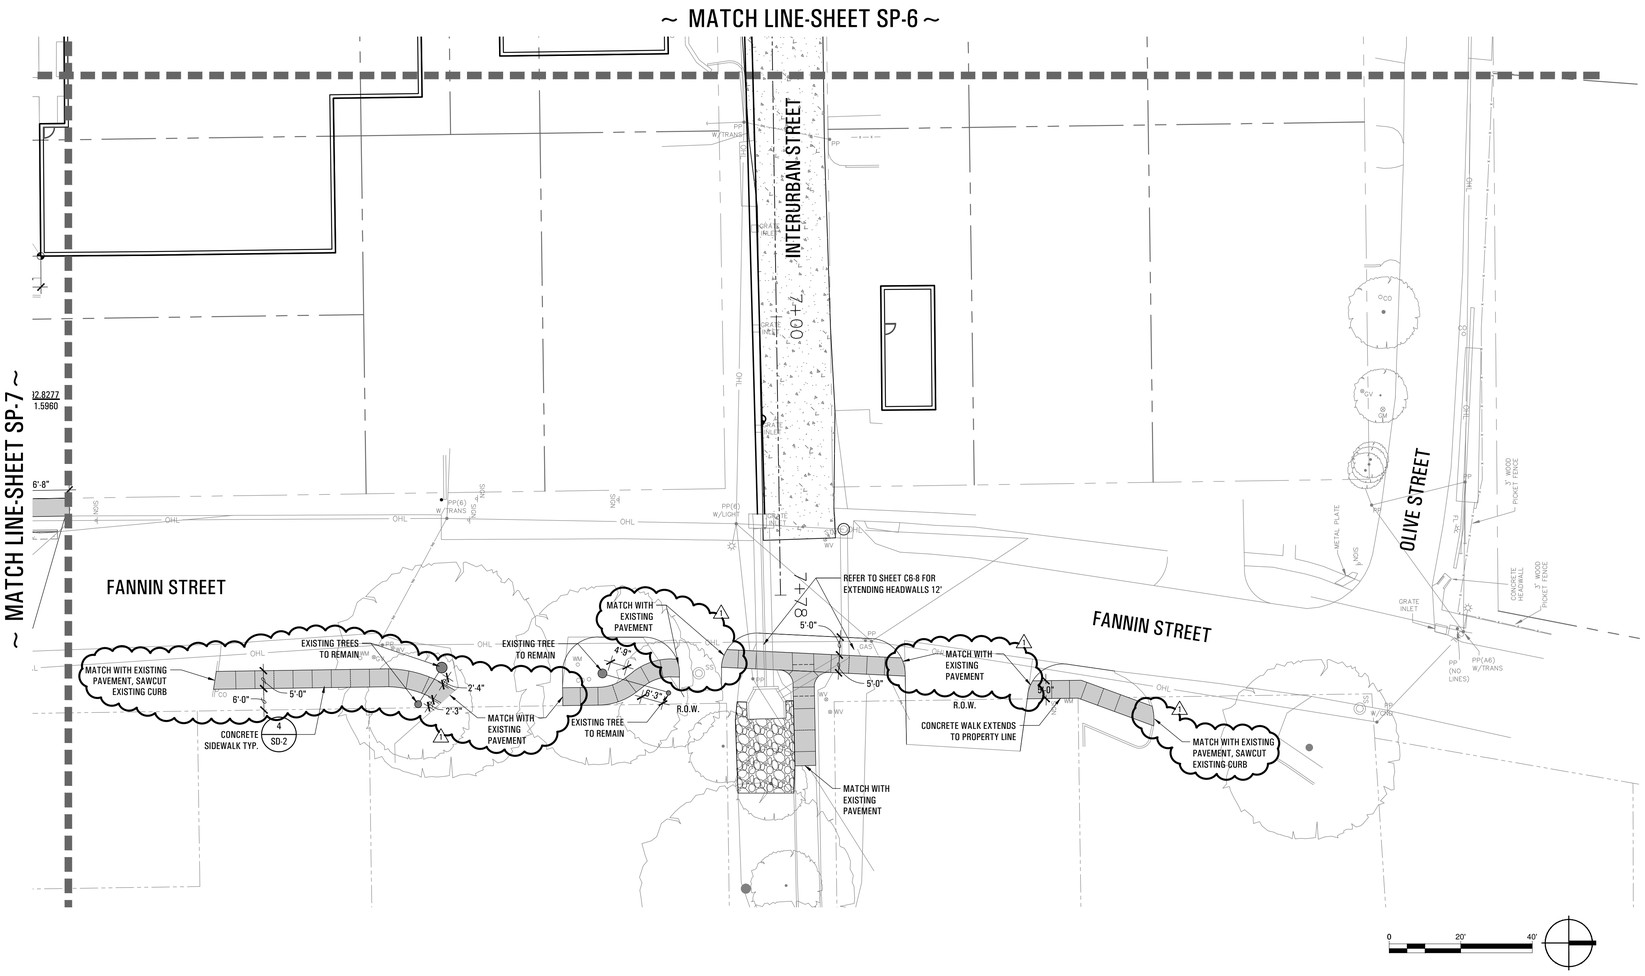


© 2013 la terra studio, inc. All Rights Reserved FILE: P:\12024-Downtown Rockwall PS&E - Rockwall\CAD\SHEETS\12024_SP1-7.dwg

la terra studio

Pacheco Koch
DALLAS + FORT WORTH + HOUSTON

ENGINEERING ASSOCIATES
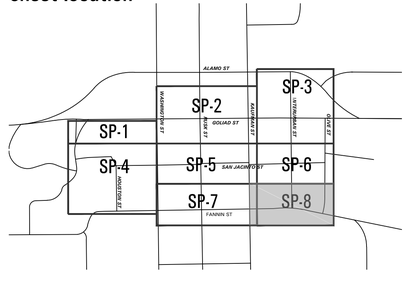
# Downtown Rockwall

*la terra studio Project #12024*

## *streetscape improvements*

PHASE 2

rockwall, texas

submittals / revisions

| no. | date | detail |
|---|---|---|
| 1 | 07/10/15 | LASI #21 |

la terra studio, inc.

12024
lts project number

02.26.2014
date

rac; bhm
drawn by

mtb
checked by

registration

REGISTERED LANDSCAPE ARCHITECT
MICHAEL T. BLACK
2202
STATE OF TEXAS

02.26.2014

sheet title

**Site Plan**

sheet number

# SP-8