


## GRADING PLAN LEGEND:

| | |
|---|---|
| 580 | EXISTING GRADE CONTOUR |
| 581 | FINISH GRADE CONTOUR |
| 587.25 | FINISH SPOT GRADE |
| 560.00 | SEE CIVIL FOR CROSS REFERENCE OF PROPOSED ELEVATION |
| TS | TOP STEP |
| BS | BOTTOM STEP |
| TW | TOP OF WALL |
| BW | BOTTOM OF WALL |
| TC | TOP OF CURB |
| G | GUTTER |
| FF | FINISH FLOOR |
| TCOL | TOP OF COLUMN |

## sheet location

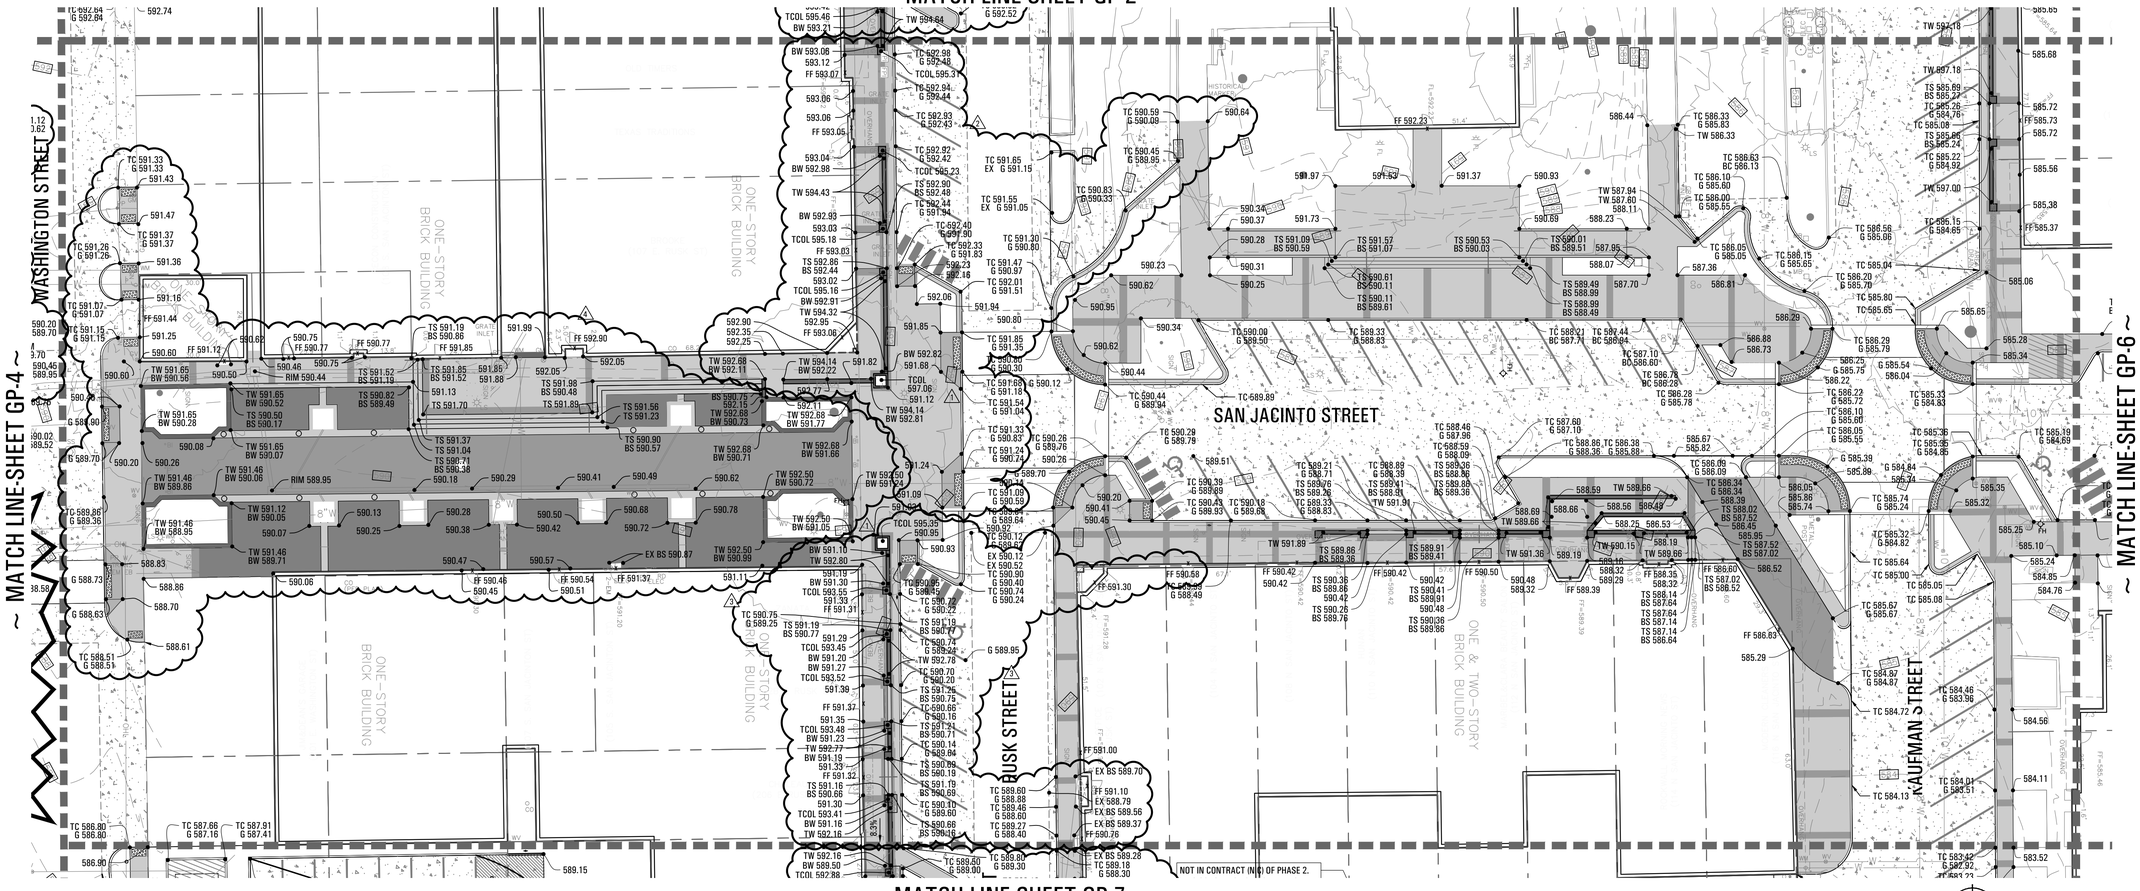


© 2013 la terra studio, inc. All Rights Reserved FILE:P:\12024-Downtown Rockwall PS&E - Rockwall\CAD\SHEETS\12024_GP1-7.dwg

la terra studio

Pacheco Koch
DALLAS FORT WORTH HOUSTON

ENGINEERING ASSOCIATES
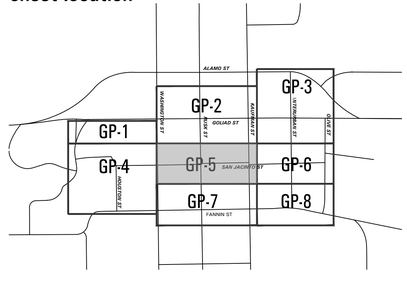
# Downtown Rockwall

*la terra studio Project #12024*

*streetscape improvements*

PHASE 2

rockwall, texas

ROCKWALL
An Official Main Street City

submittals / revisions

| no. | date | detail |
|---|---|---|
| 1 | 04/02/14 | RFI #29 |
| 2 | 05/02/14 | RFI #77 WEST RUSK GRADING |
| 3 | 05/08/14 | RFI #20, #42, #43, #54 |
| 4 | 05/12/14 | LASI #5 |

la terra studio, inc.

12024
lts project number

02.26.2014
date

rac; bhm
drawn by

mtb
checked by

registration

REGISTERED LANDSCAPE ARCHITECT
MICHAEL T BUTLER
2202
STATE OF TEXAS

02.26.2014

sheet title

**Grading Plan**

sheet number

GP-5