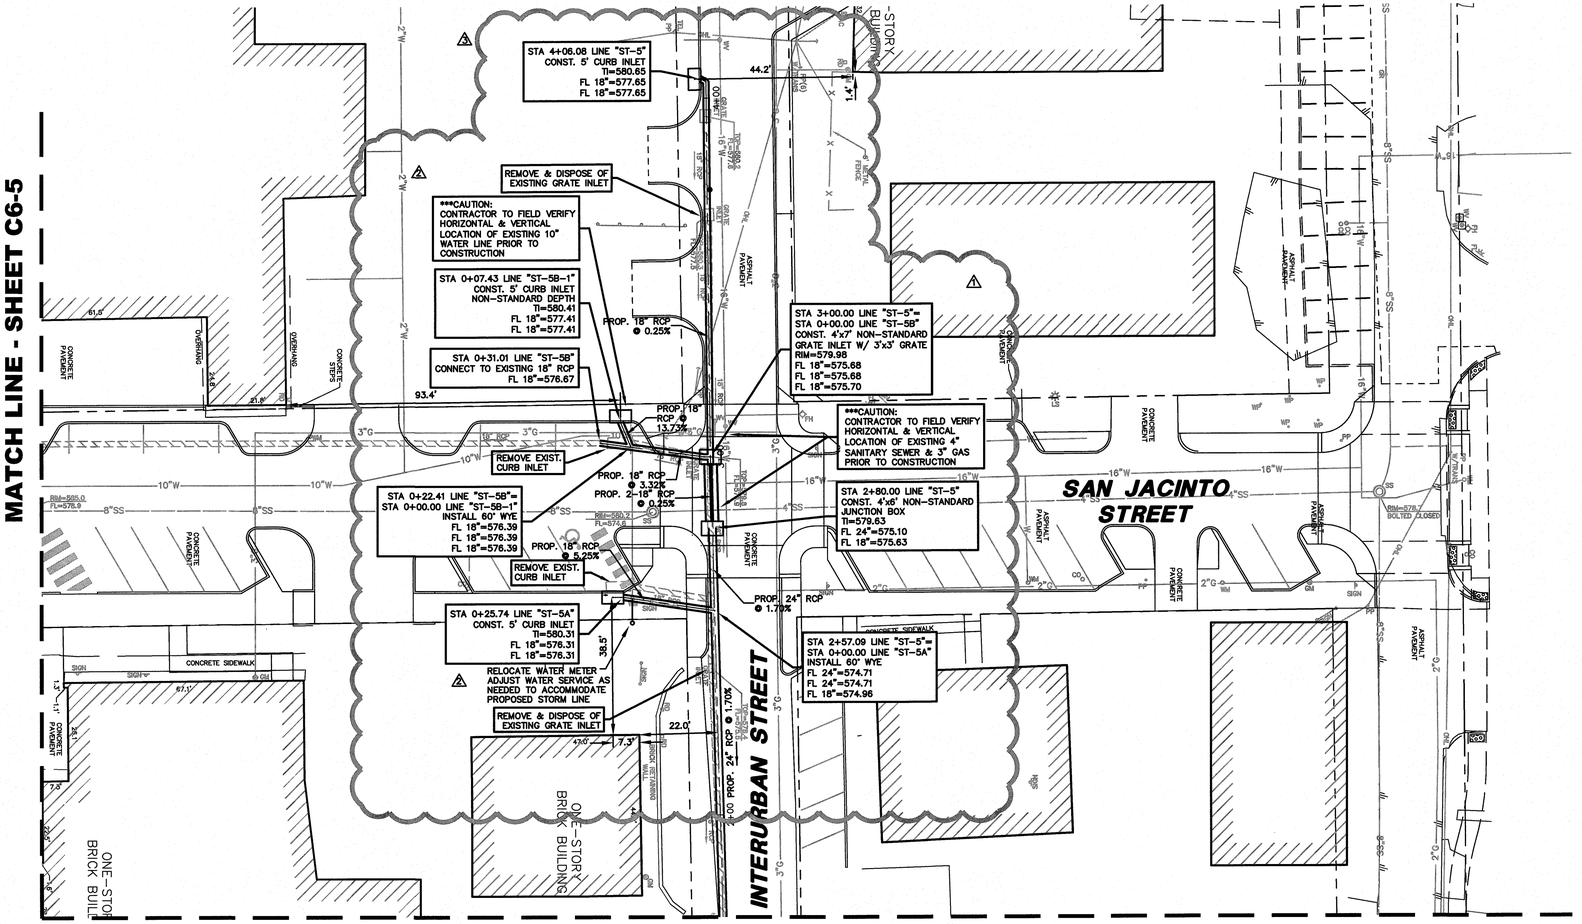

0 10 20 40 60
GRAPHIC SCALE IN FEET

LEGEND

B.	BOLLARD	FL	FLOOD LIGHT
EM	ELECTRIC METER	FP	FLAG POLE
PP	POWER POLE	SIGN	TRAFFIC SIGN
LS	LIGHT STANDARD	IRS	1/2"-INCH IRON ROD W/"PACHECO KOCH" CAP SET
WM	WATER METER	(C.M.)	CONTROLLING MONUMENT
WV	WATER VALVE		PROPERTY LINE
ICV	IRRIGATION CONTROL VALVE	-X-	FENCE
FH	FIRE HYDRANT	OHL	OVERHEAD UTILITY LINE
CO	CLEANOUT	E	UNDERGROUND ELECTRIC LINE
MH	MANHOLE	T	UNDERGROUND TELEPHONE LINE
TSC	TRAFFIC SIGNAL CONTROL	C	UNDERGROUND CABLE LINE
TSP	TRAFFIC SIGNAL POLE	6"W	UNDERGROUND WATER LINE
TELE	TELEPHONE BOX	6"SS	UNDERGROUND SANITARY SEWER LINE

BENCH MARK LIST

BM# 1	"+" SET IN BOX ON CURB INLET ON NORTHWEST CORNER OF ALAMO ST. AND GOLIAD ST. ELEV=574.54
BM# 2	"+" SET IN BOX ON BACK OF CURB ON SOUTH SIDE OF A CURB RETURN TO A PARKING LOTON EAST SIDE OF FANNIN ST. ±7 FEET SOUTH OF OLIVE ST. ELEV=573.63
BM# 3	"+" SET IN BOX ON SOUTH WEST CORNER OF GOLIAS ST. AND KAUFMAN ST. ±40 FEET WEST OF ℄ OF GOLIAD ST. AND ±25 FEET SOUTH OF ℄ OF KAUFMAN ELEV=587.41
BM# 4	"+" SET IN BOX ON NORTH EAST CORNER OF N. FANNIN ST. AND KAUFMAN ST. ±15 FEET NORTH OF ℄ OF KAUFMAN ST. AND ±30 FEET EAST FROM ℄ OF KAUFMAN ST. ELEV=578.80
BM# 5	"+" SET IN BOX ON NORTH WEST CORNER OF WASHINGTON ST. ON GOLIAD ST. ±40 FEET WEST OF ℄ OF GOLIAD ST. AND ±25 FEET NORTH OF ℄ OF WASHINGTON ST. ELEV=595.39
BM# 6	"+" SET IN BOX SOUTH EAST CORNER OF WASHINGTON ST. AND FANNIN ST ±22 FEET OF ℄ OF FANNIN ST. AND ±45 FEET SOUTH OF ℄ OF WASHINGTON ST. ELEV=580.69

STATE OF TEXAS
CHRISTOPHER M. JONES
82681
REGISTERED
PROFESSIONAL ENGINEER

THE SEAL APPEARING ON THIS DOCUMENT WAS AUTHORIZED BY CHRISTOPHER M. JONES, P.E. 82681 ON 05/12/14. ALTERATION OF A SEALED DOCUMENT WITHOUT PROPER NOTIFICATION TO THE RESPONSIBLE ENGINEER IS AN OFFENSE UNDER THE TEXAS ENGINEERING PRACTICE ACT.

sheet location
KEY MAP

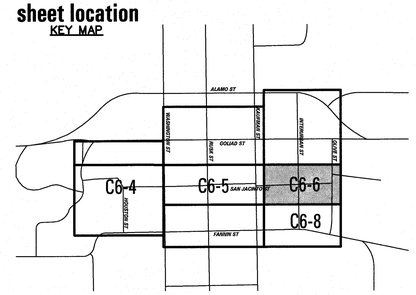

© 2012 la terra studio, inc. All Rights Reserved FILE:

la terra studio sm
Pacheco Koch
DALLAS • FORT WORTH • HOUSTON
ENGINEERING ASSOCIATES

Downtown Rockwall
la terra studio Project #12024
streetscape improvements
PHASE 2
rockwall, texas

submittals / revisions

no.	date	detail
1	12/11/13	ADDENDUM #2
2	12/11/13	ADDENDUM #3
3	7/11/14	LASI #7

la terra studio, inc.

12024
lts project number
02.26.2014
date
JHB
drawn by
CMJ
checked by
registration

sheet title
STORM DRAINAGE PLAN
sheet number
C6-6