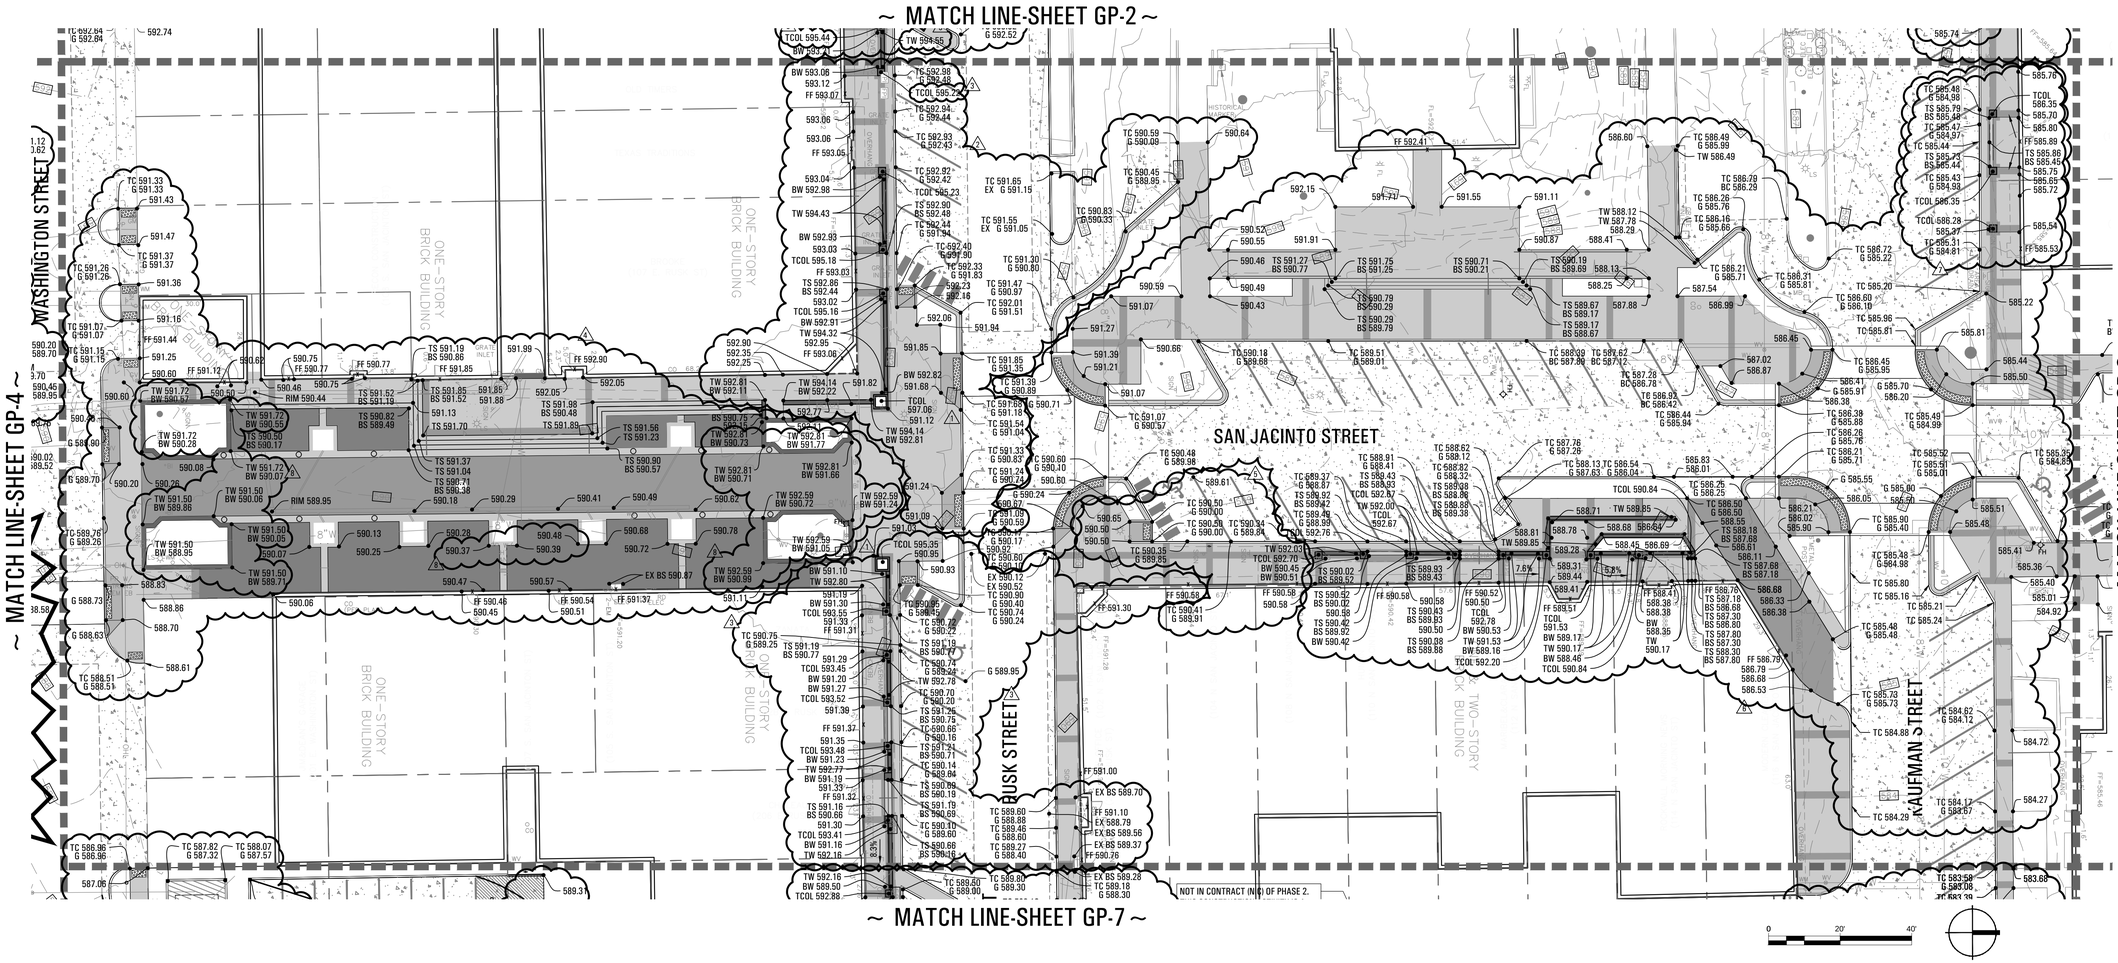

GRADING PLAN LEGEND:

580	EXISTING GRADE CONTOUR
581	FINISH GRADE CONTOUR
587.25	FINISH SPOT GRADE
560.00	SEE CIVIL FOR CROSS REFERENCE OF PROPOSED ELEVATION
TS	TOP STEP
BS	BOTTOM STEP
TW	TOP OF WALL
BW	BOTTOM OF WALL
TC	TOP OF CURB
G	GUTTER
FF	FINISH FLOOR
TCOL	TOP OF COLUMN

sheet location

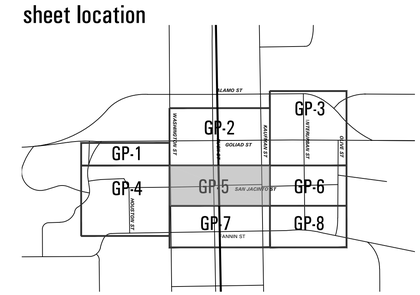

la terra studio

Pacheco Koch
DALLAS FORT WORTH HOUSTON

ENGINEERING ASSOCIATES

Downtown Rockwall

la terra studio Project #12024

streetscape improvements

PHASE 2

rockwall, texas

ROCKWALL
An Official Main Street City

submittals / revisions

no.	date	detail
1	04/02/14	RFI #29
2	05/02/14	RFI #77 WEST RUSK GRADING
3	05/08/14	RFI #20, #42, #43, #54
4	05/12/14	LASI #5
5	05/13/14	RFI #52
6	05/30/14	RFI #40
7	07/25/14	RFI #104
8	07/28/14	LASI #9

la terra studio, inc.

12024
lts project number

02.26.2014
date

rac; bhm
drawn by

mtb
checked by

registration

REGISTERED LANDSCAPE ARCHITECT
MICHAEL T BLACK
2202
STATE OF TEXAS

02.26.2014

sheet title

Grading Plan

sheet number

GP-5

© 2013 la terra studio, inc. All Rights Reserved FILE:P:\12024-Downtown Rockwall PS&E - Rockwall\CAD\SHEET\12024_GP1-7.dwg