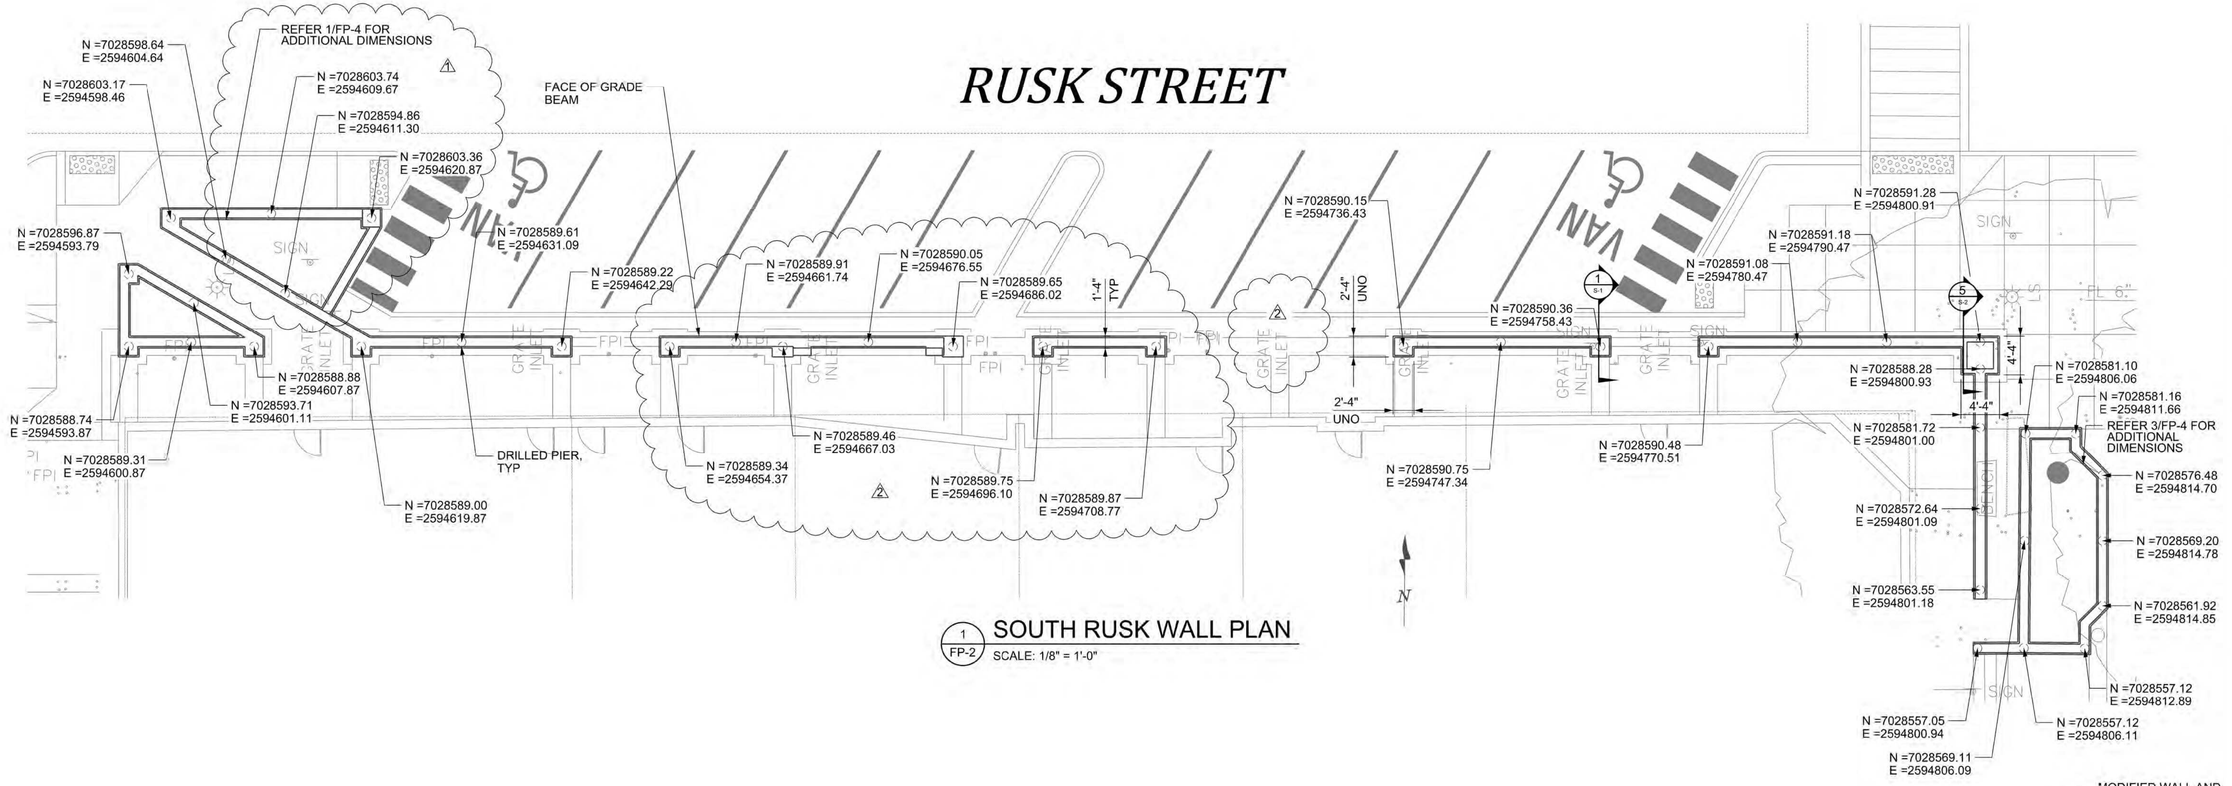

1 FP-2 SOUTH RUSK WALL PLAN
SCALE: 1/8" = 1'-0"

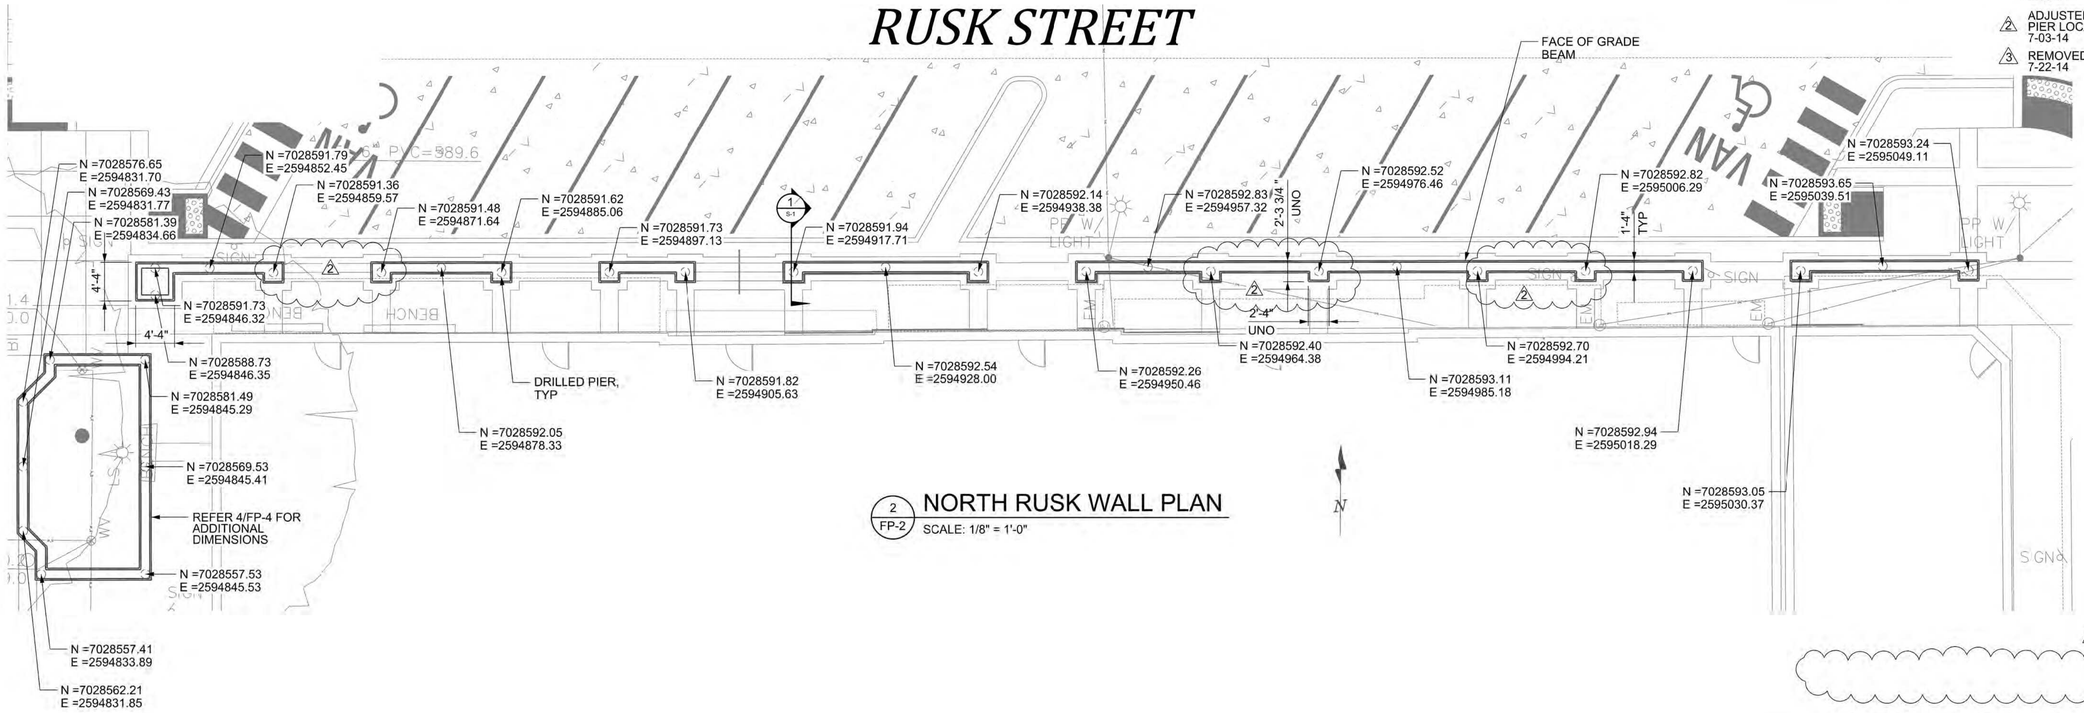

2 FP-2 NORTH RUSK WALL PLAN
SCALE: 1/8" = 1'-0"

1 MODIFIED WALL AND PIER LOCATIONS. 4-15-14

2 ADJUSTED WALLS AND PIER LOCATIONS 7-03-14

3 REMOVED NOTE 7-22-14

© 2012 la terra studio, inc. All Rights Reserved FILE:

la terra studio
Pacheco Koch
DALLAS FORT WORTH HOUSTON
ENGINEERING ASSOCIATES

Downtown Rockwall

Project #12024 ~renovation~

streetscape improvements

rockwall, texas

submittals / revisions

no.	date	detail
1	4-15-14	RFI #39
2	7-03-14	RFI #39
3	7-22-14	RFI #109

la terra studio, inc.

12024
its project number

4.15.2014
date

bgp
drawn by

bgp
checked by

registration

Brian G. Pierce
STATE OF TEXAS
BRIAN G. PIERCE
94837
LICENSED
PROFESSIONAL ENGINEER
7-23-14

sheet title
FOUNDATION PLAN

sheet number
FP-2

PIERCE ENGINEERING
STRUCTURAL ENGINEERING
BUS.: (940) 937-8600 132 N. MAIN STREET
FIRM REG #: F-9186 CHILDRESS, TX 79201