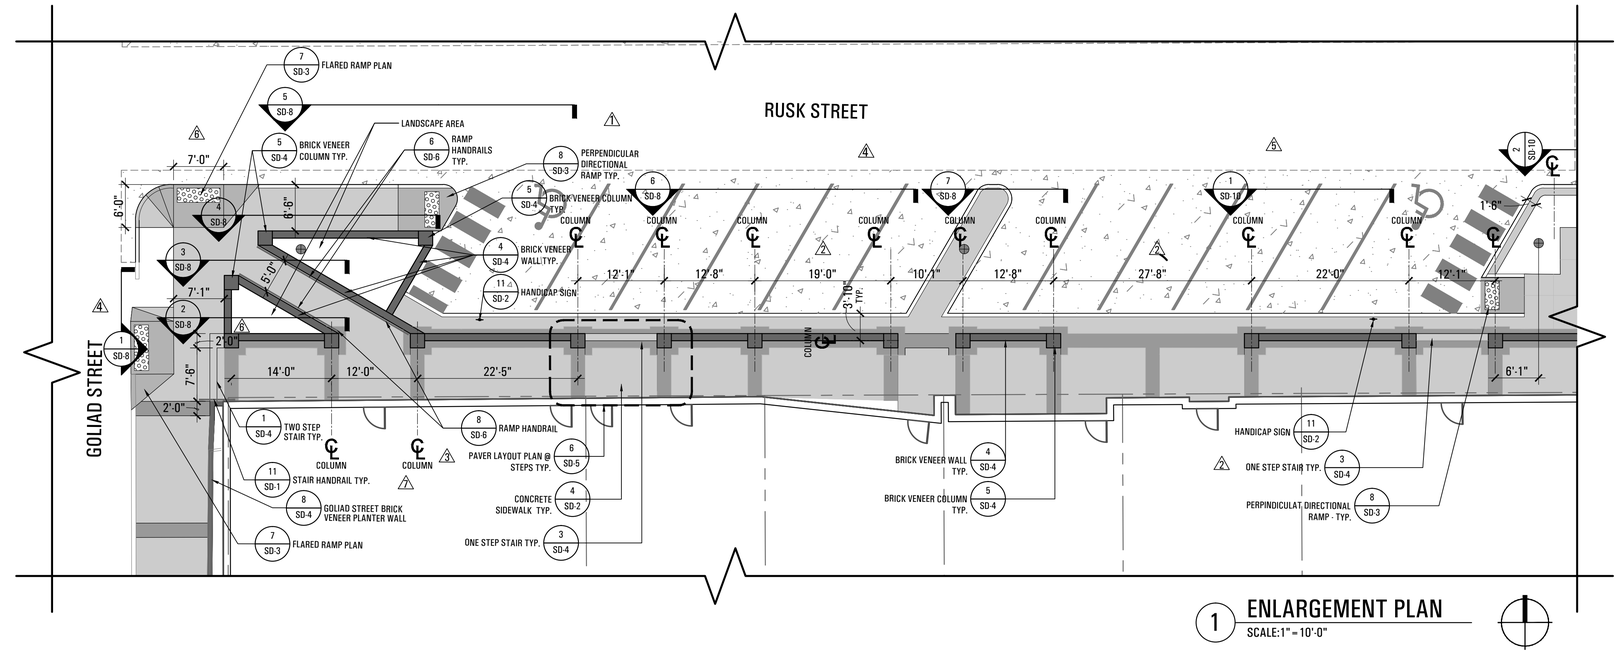

1 ENLARGEMENT PLAN
SCALE: 1" = 10'-0"

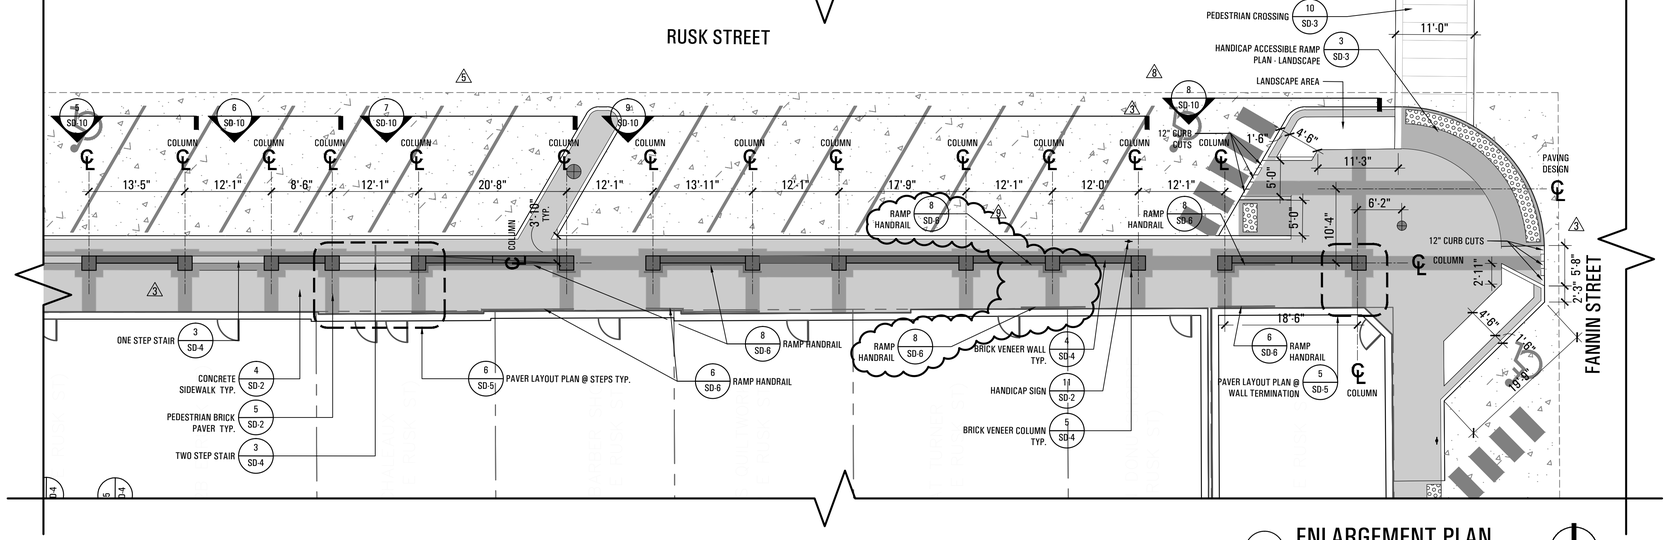

2 ENLARGEMENT PLAN
SCALE: 1" = 10'-0"

SITE PLAN LEGEND:

- EDGE OF PAVEMENT
- CONCRETE SIDEWALK PAVEMENT
- CONCRETE VEHICULAR PAVEMENT
- TYPICAL LIGHT FIXTURE

© 2013 la terra studio, inc. All Rights Reserved FILE:P:\12024-Downtown Rockwall PS&E - Rockwall\CAD\SHEET\12024_Enlargement_Plan_key.dwg

la terra studio

Pacheco Koch
DALLAS + FORT WORTH + HOUSTON

ENGINEERING ASSOCIATES

Downtown Rockwall
la terra studio Project #12024

streetscape improvements
PHASE 2
rockwall, texas

submittals / revisions

no.	date	detail
1	04/14/14	RFI #39
2	05/02/14	RFI #77 WEST RUSK GRADING
3	05/08/14	RFI #20, #38, #42, #43, #54
4	06/17/14	RFI #93
5	07/31/14	LASI #10
6	10/27/14	RFI #140
7	11/17/14	RFI #144
8	11/26/14	LASI #12
9	01/13/15	RFI #154

la terra studio, inc.

12024
lts project number

02.26.2014
date

rac; bhm
drawn by

mtb
checked by

registration

REGISTERED LANDSCAPE ARCHITECT MICHAEL T. BLACK 2202 STATE OF TEXAS

02.26.2014

sheet title

Enlargement Plan

sheet number

EP-3