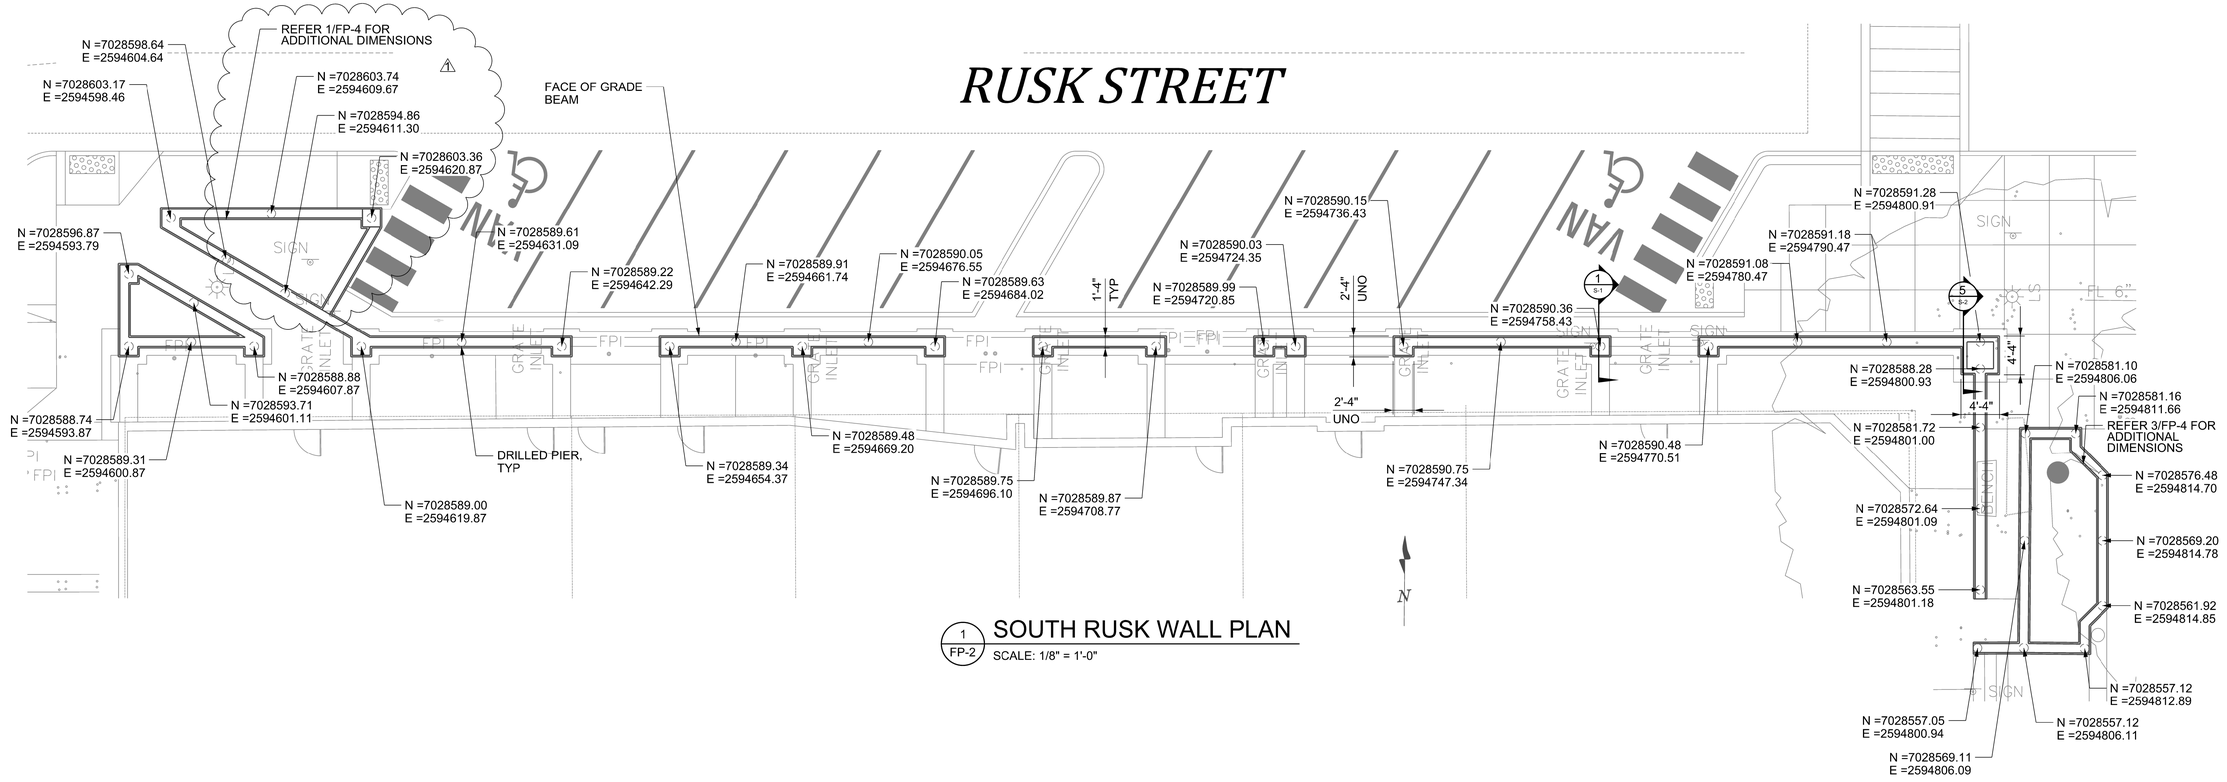

1 / FP-2 SOUTH RUSK WALL PLAN

SCALE: 1/8" = 1'-0"

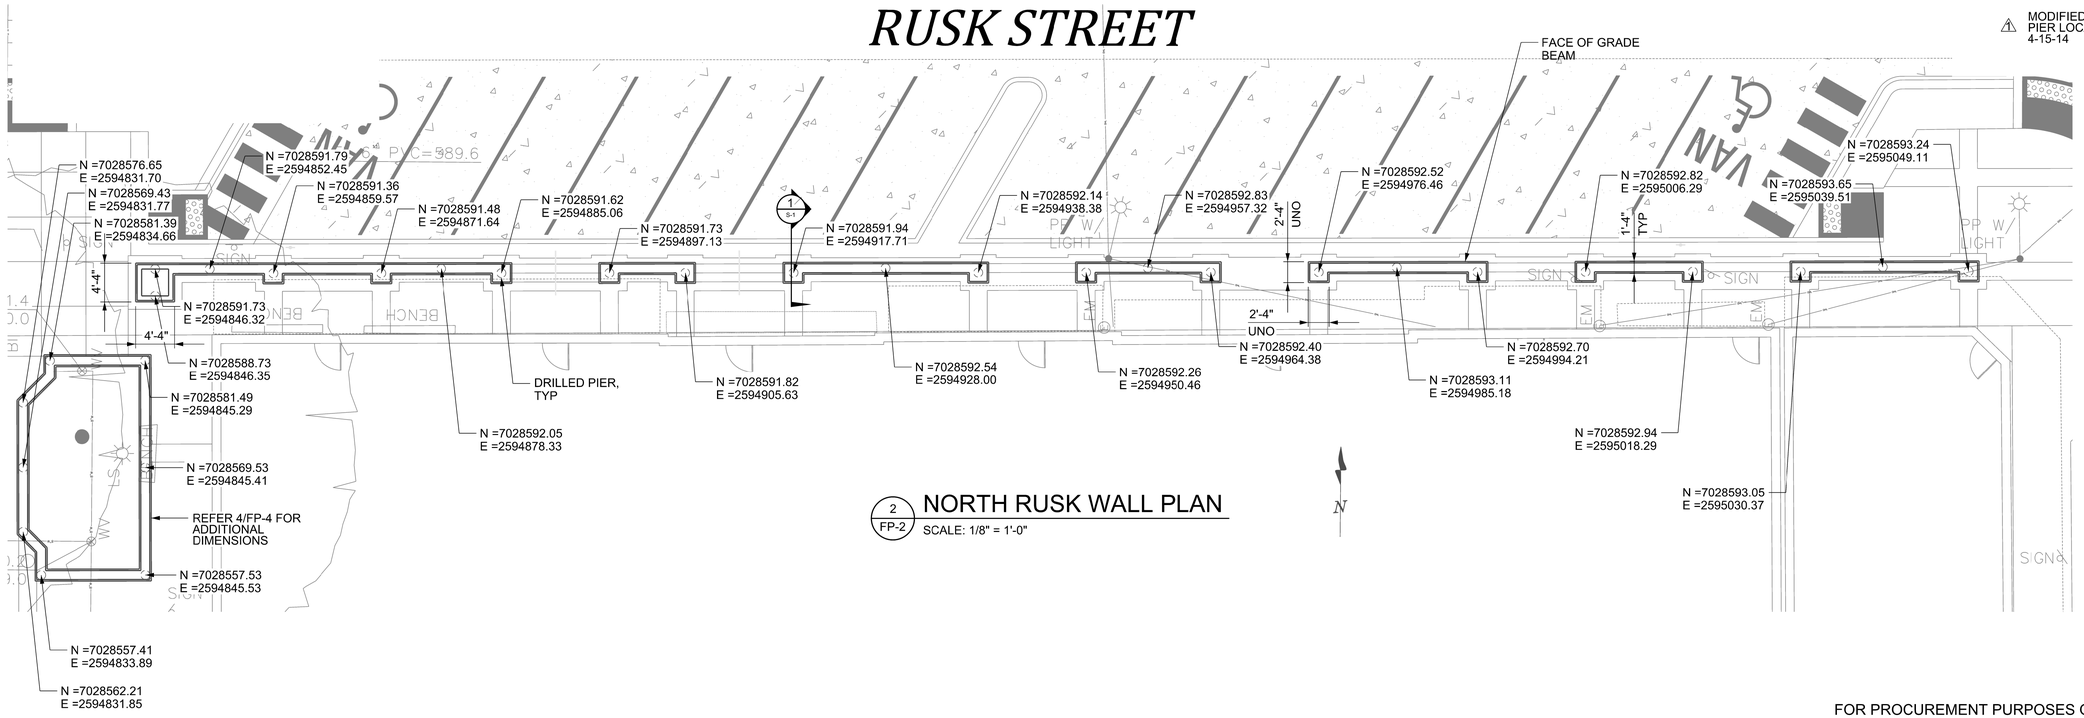

2 / FP-2 NORTH RUSK WALL PLAN

SCALE: 1/8" = 1'-0"

FOR PROCUREMENT PURPOSES ONLY

PIERCE ENGINEERING
STRUCTURAL ENGINEERING
BUS.: (940) 937-8600 132 N. MAIN STREET
FIRM REG #: F-9186 CHILDRESS, TX 79201

© 2012 la terra studio, inc. All Rights Reserved FILE:

la terra studio sm

Pacheco Koch DALLAS | FORT WORTH | HOUSTON

EA ENGINEERING ASSOCIATES

Downtown Rockwall

~ Project #12024 – renovation ~

streetscape improvements

rockwall, texas

submittals / revisions

no.	date	detail
1	4-15-14	RFI #39

la terra studio, inc.

12024
its project number

4.15.2014
date

bgp
drawn by

bgp
checked by

registration

Brian G. Pierce
STATE OF TEXAS
BRIAN G. PIERCE
94837
LICENSED
PROFESSIONAL ENGINEER

4-15-14

sheet title

FOUNDATION PLAN

sheet number

FP-2