

Downtown Rockwall
la terra studio Project #12024

streetscape improvements
rockwall, texas

PHASE 2



submittals / revisions		
no.	date	detail

la terra studio, inc

12024
Its project number

02.26.2014
date


JHB
drawn by

CMJ
checked b

_____ registration

_____ sheet title
**Site Paving
 Plan**
 _____ sheet number

C1-1

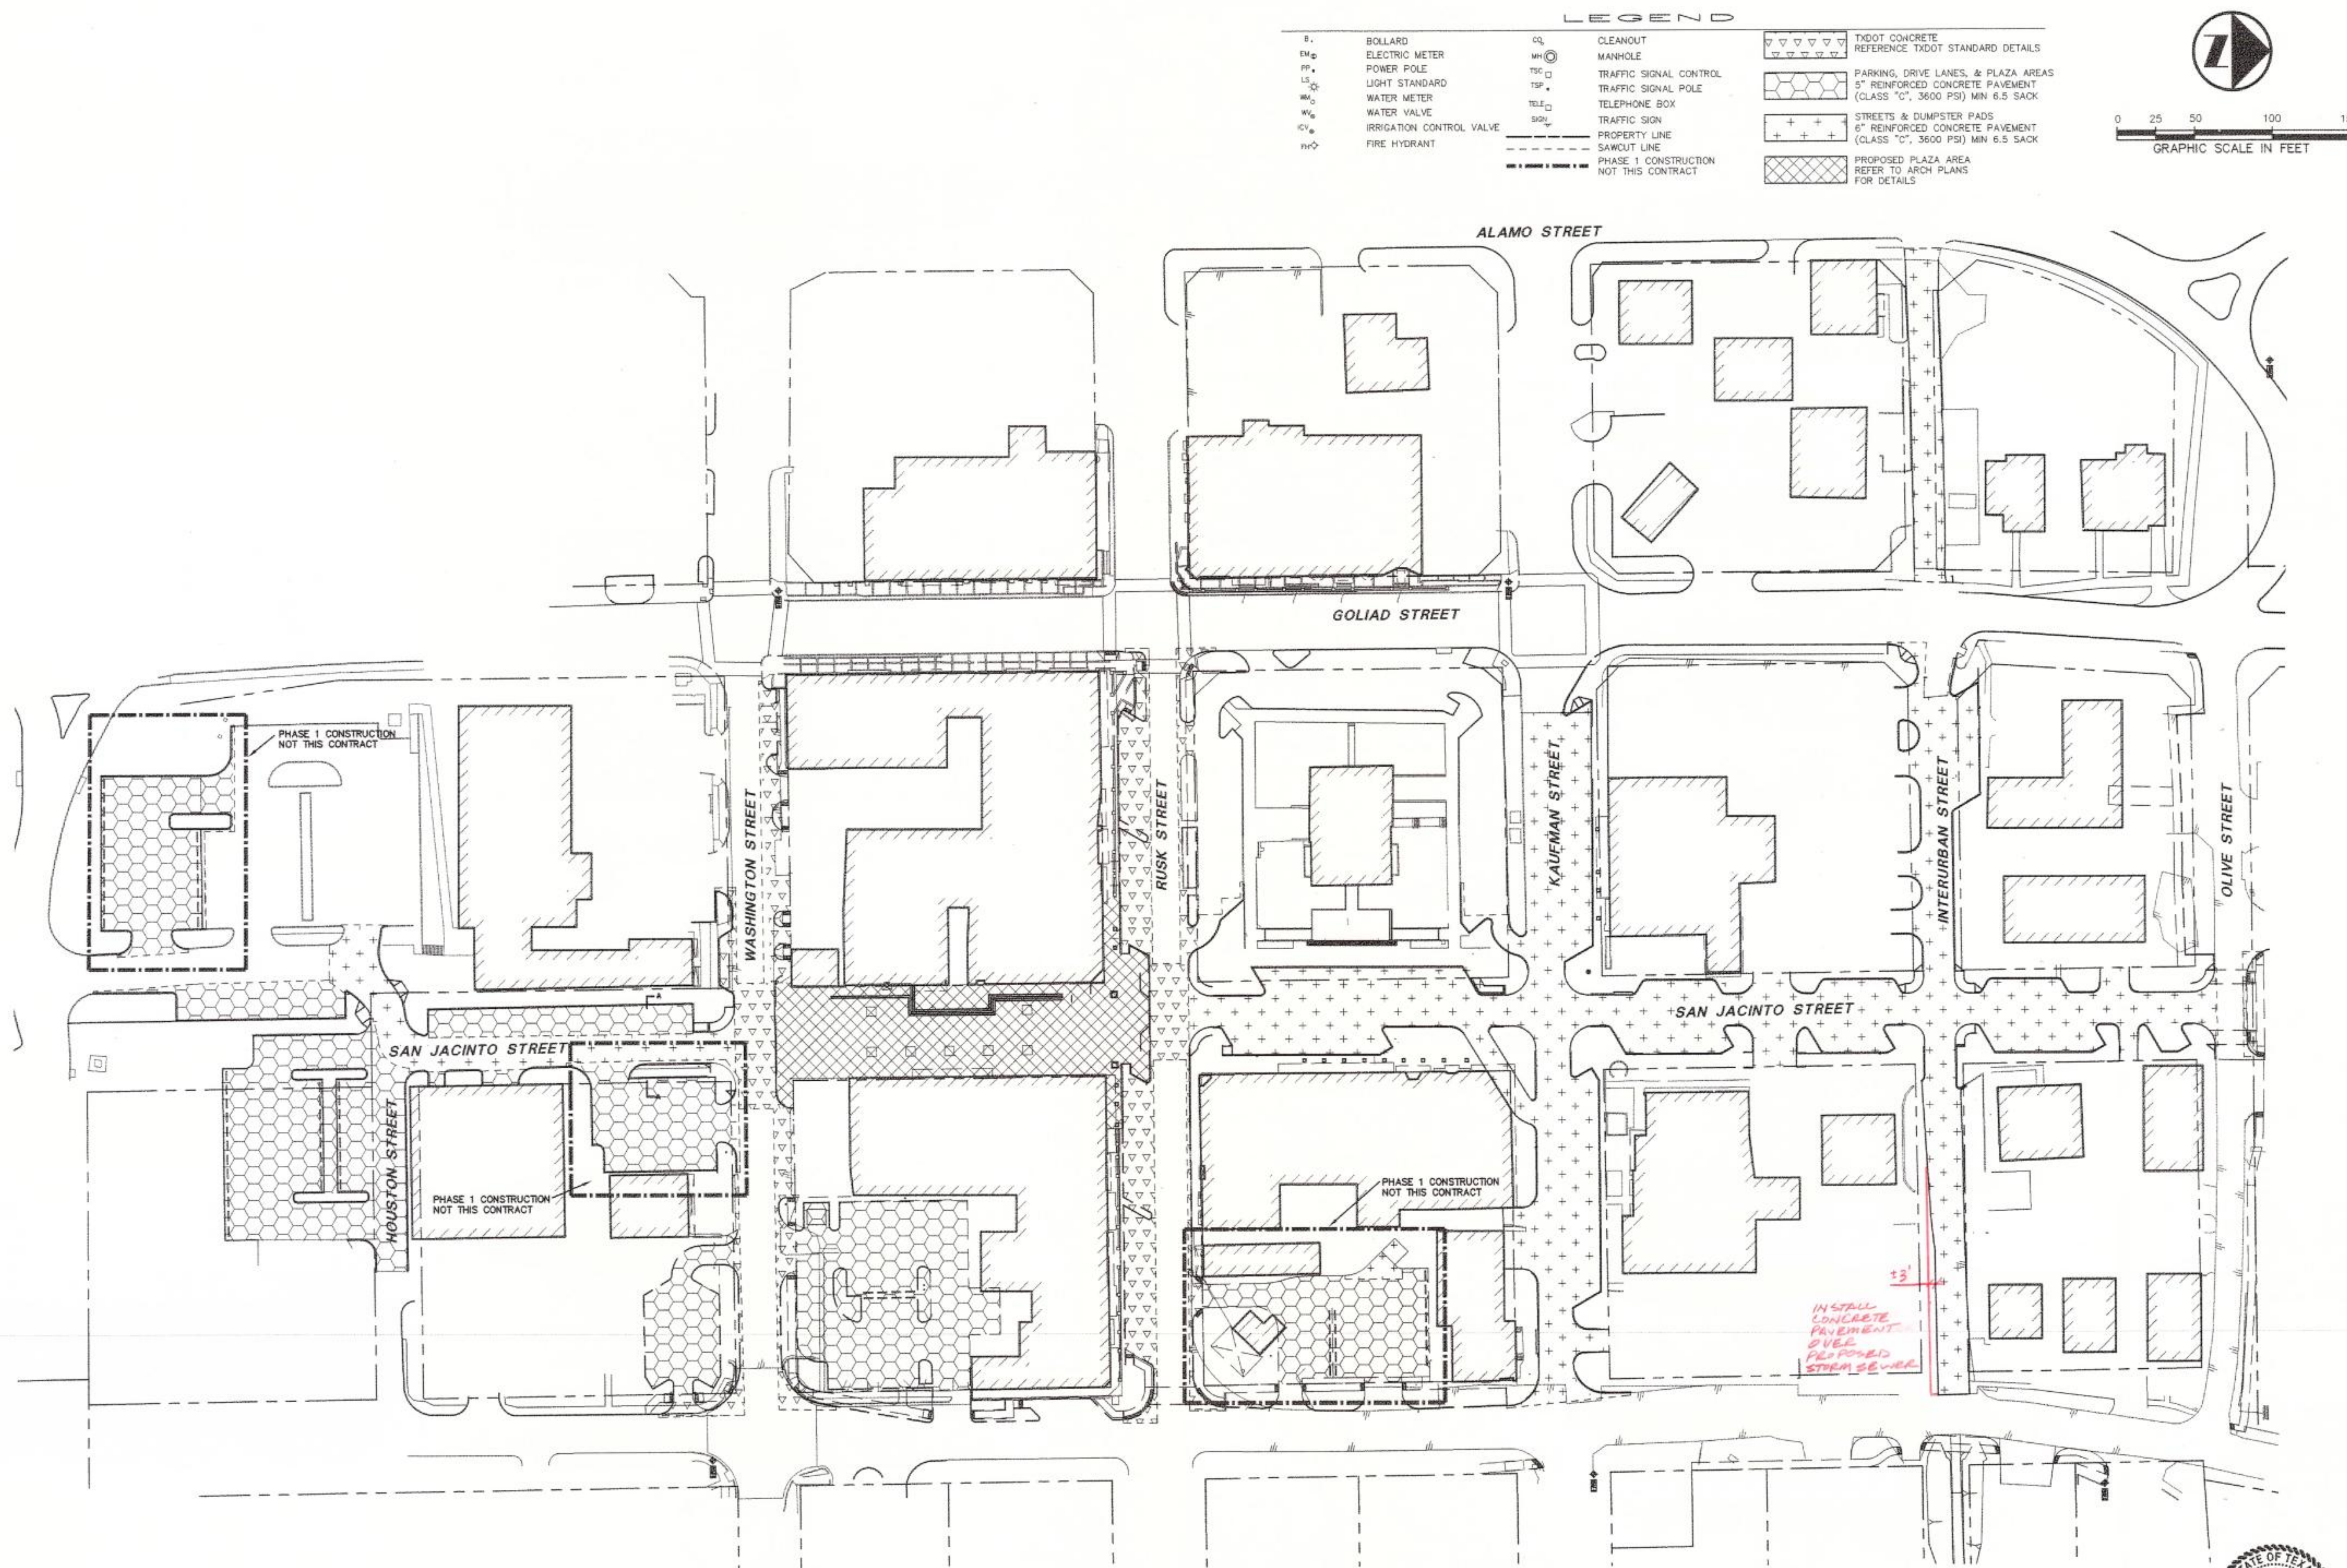

THE SEAL APPEARING ON THIS DOCUMENT WAS
AUTHORIZED BY CHRISTOPHER M. JONES, P.E. 82681 ON
02/26/2014. ALTERATION OF A SEALED DOCUMENT
WITHOUT PROPER NOTIFICATION TO THE RESPONSIBLE
ENGINEER IS AN OFFENSE UNDER THE TEXAS
ENGINEERING PRACTICE ACT.