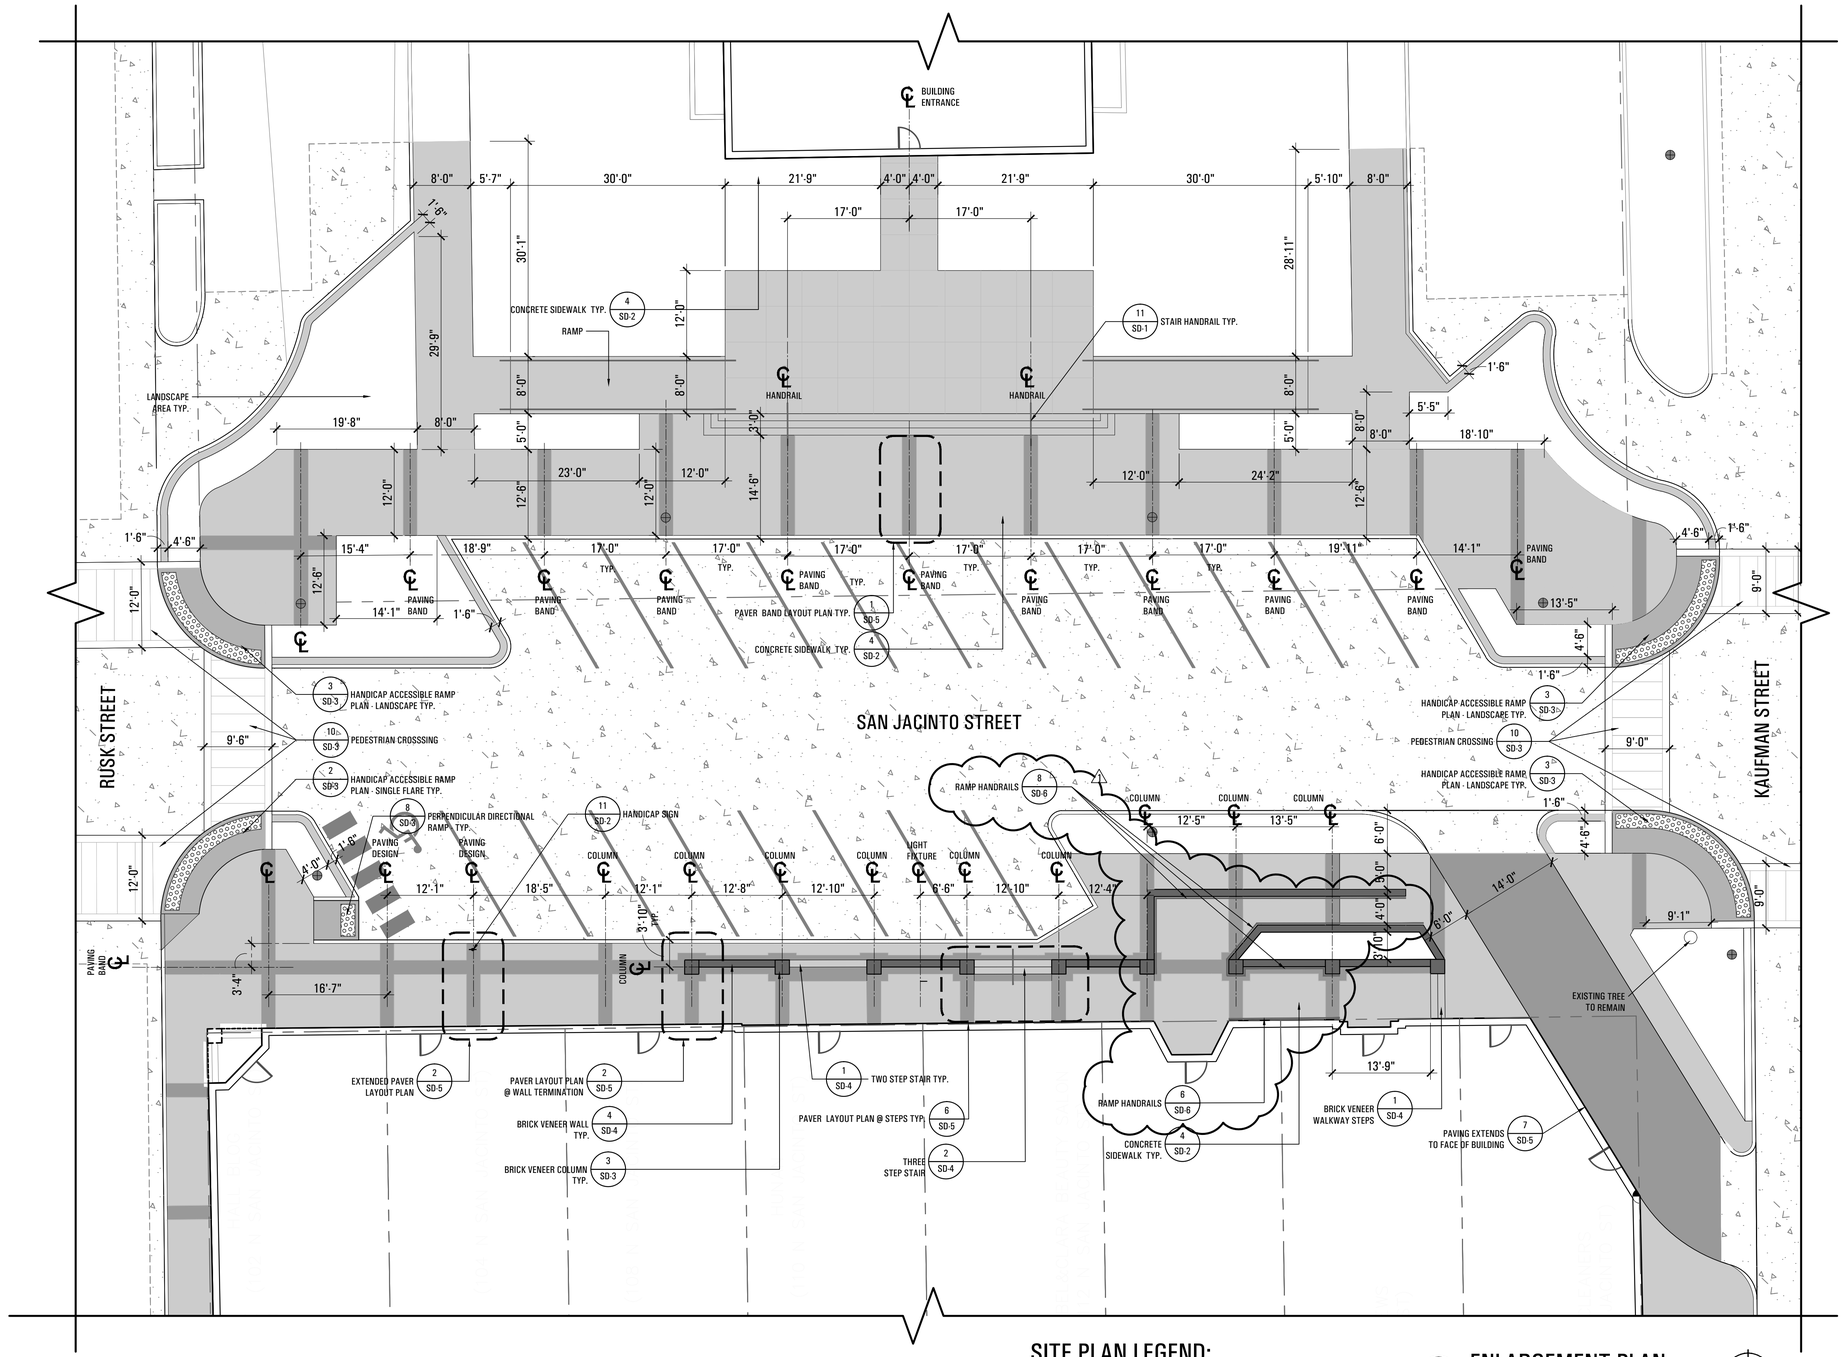

SITE PLAN LEGEND:

- EDGE OF PAVEMENT
- CONCRETE SIDEWALK PAVEMENT
- CONCRETE VEHICULAR PAVEMENT
- TYPICAL LIGHT FIXTURE

1 ENLARGEMENT PLAN

SCALE:1" = 10'-0"

© 2013 la terra studio, inc. All Rights Reserved FILE: P:\12024-Downtown Rockwall PS&E - Rockwall\CAD\SHEET\12024_Enlargement_Plan_key.dwg

la terra studio

Pacheco Koch
DALLAS + FORT WORTH + HOUSTON

ENGINEERING ASSOCIATES

Downtown Rockwall

la terra studio Project #12024

streetscape improvements

PHASE 2

rockwall, texas

ROCKWALL
the Official Main Street City

submittals / revisions

no.	date	detail
1	05/13/14	RFI #51

la terra studio, inc.

12024
lts project number

02.26.2014
date

rac; bhm
drawn by

mtb
checked by

registration

REGISTERED LANDSCAPE ARCHITECT
MICHAEL T. BLACK
2202
STATE OF TEXAS

02.26.2014

sheet title

Enlargement Plan

sheet number

EP-2