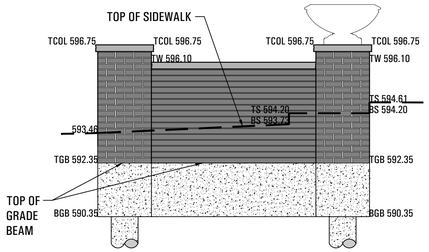

1 WEST WALL ELEVATION - 102 E. RUSK ST.
SCALE: 3/8" = 1'-0"

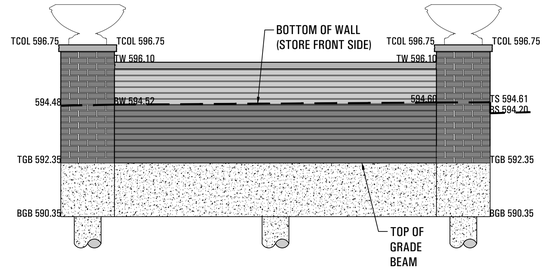

2 SOUTH WALL ELEVATION - 102 E. RUSK ST.
SCALE: 3/8" = 1'-0"

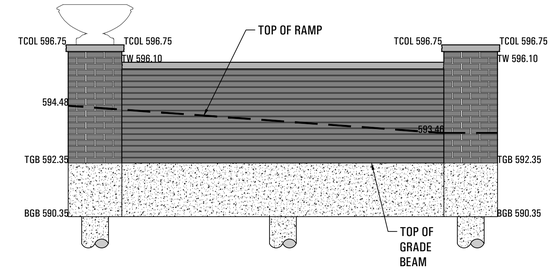

3 RAMP WALL ELEVATION - 102 E. RUSK ST.
SCALE: 3/8" = 1'-0"

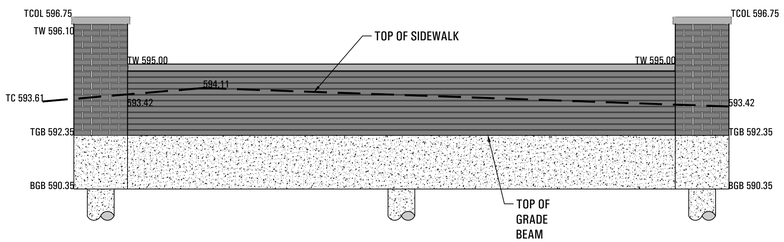

4 NORTH WALL ELEVATION - 102 E. RUSK ST.
SCALE: 3/8" = 1'-0"

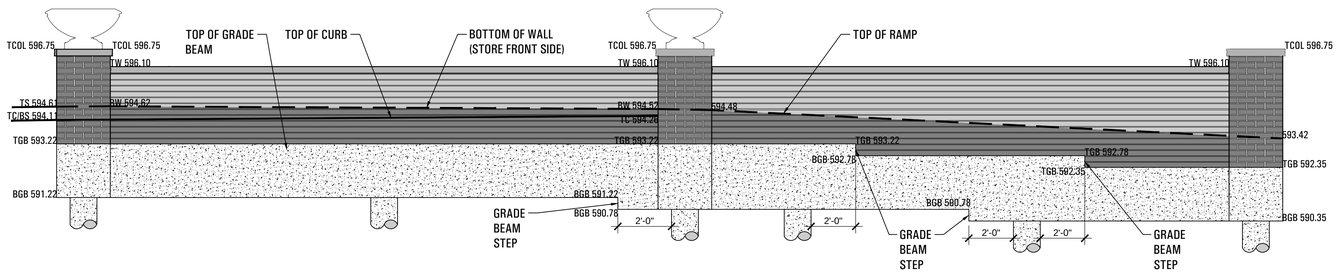

5 WALL ELEVATION - 104 E. RUSK ST.
SCALE: 3/8" = 1'-0"

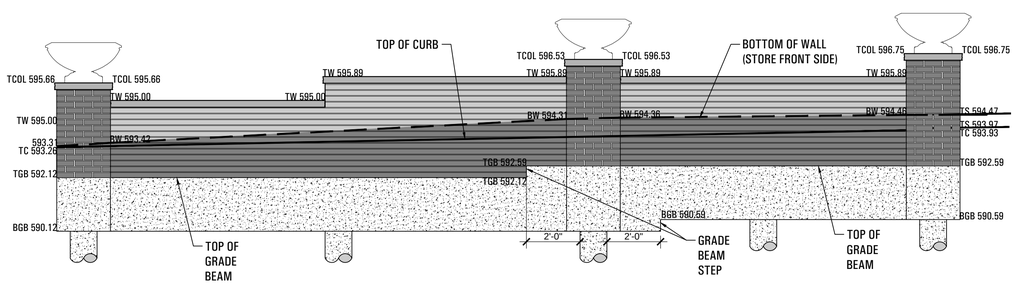

6 WALL ELEVATION - 106 - 110 E. RUSK ST.
SCALE: 3/8" = 1'-0"

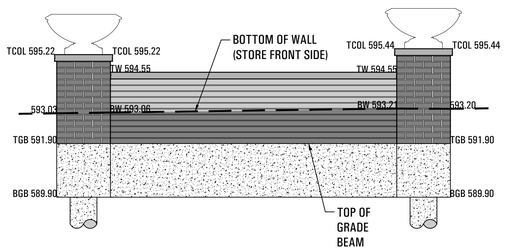

7 WALL ELEVATION - 112 E. RUSK ST.
SCALE: 3/8" = 1'-0"

© 2013 la terra studio, inc. All Rights Reserved FILE:P:\12024-Downtown Rockwall PS&E - Rockwall\CAD\SHEET\12024-Site Dastails_8.dwg

la terra studio
Pacheco Koch
DALLAS FORT WORTH HOUSTON
EA ENGINEERING ASSOCIATES

Downtown Rockwall
la terra studio Project #12024

streetscape improvements
PHASE 2
rockwall, texas

ROCKWALL
Historic Main Street City

submittals / revisions

no.	date	detail
1	06/17/14	RFI #93

la terra studio, inc.

12024
lts project number
02.26.2014
date
rac; bhm
drawn by
mtb
checked by

registration

REGISTERED LANDSCAPE ARCHITECT
MICHAEL T BLACK
2202
STATE OF TEXAS
02.26.2014

sheet title
Site Details
sheet number
SD-8