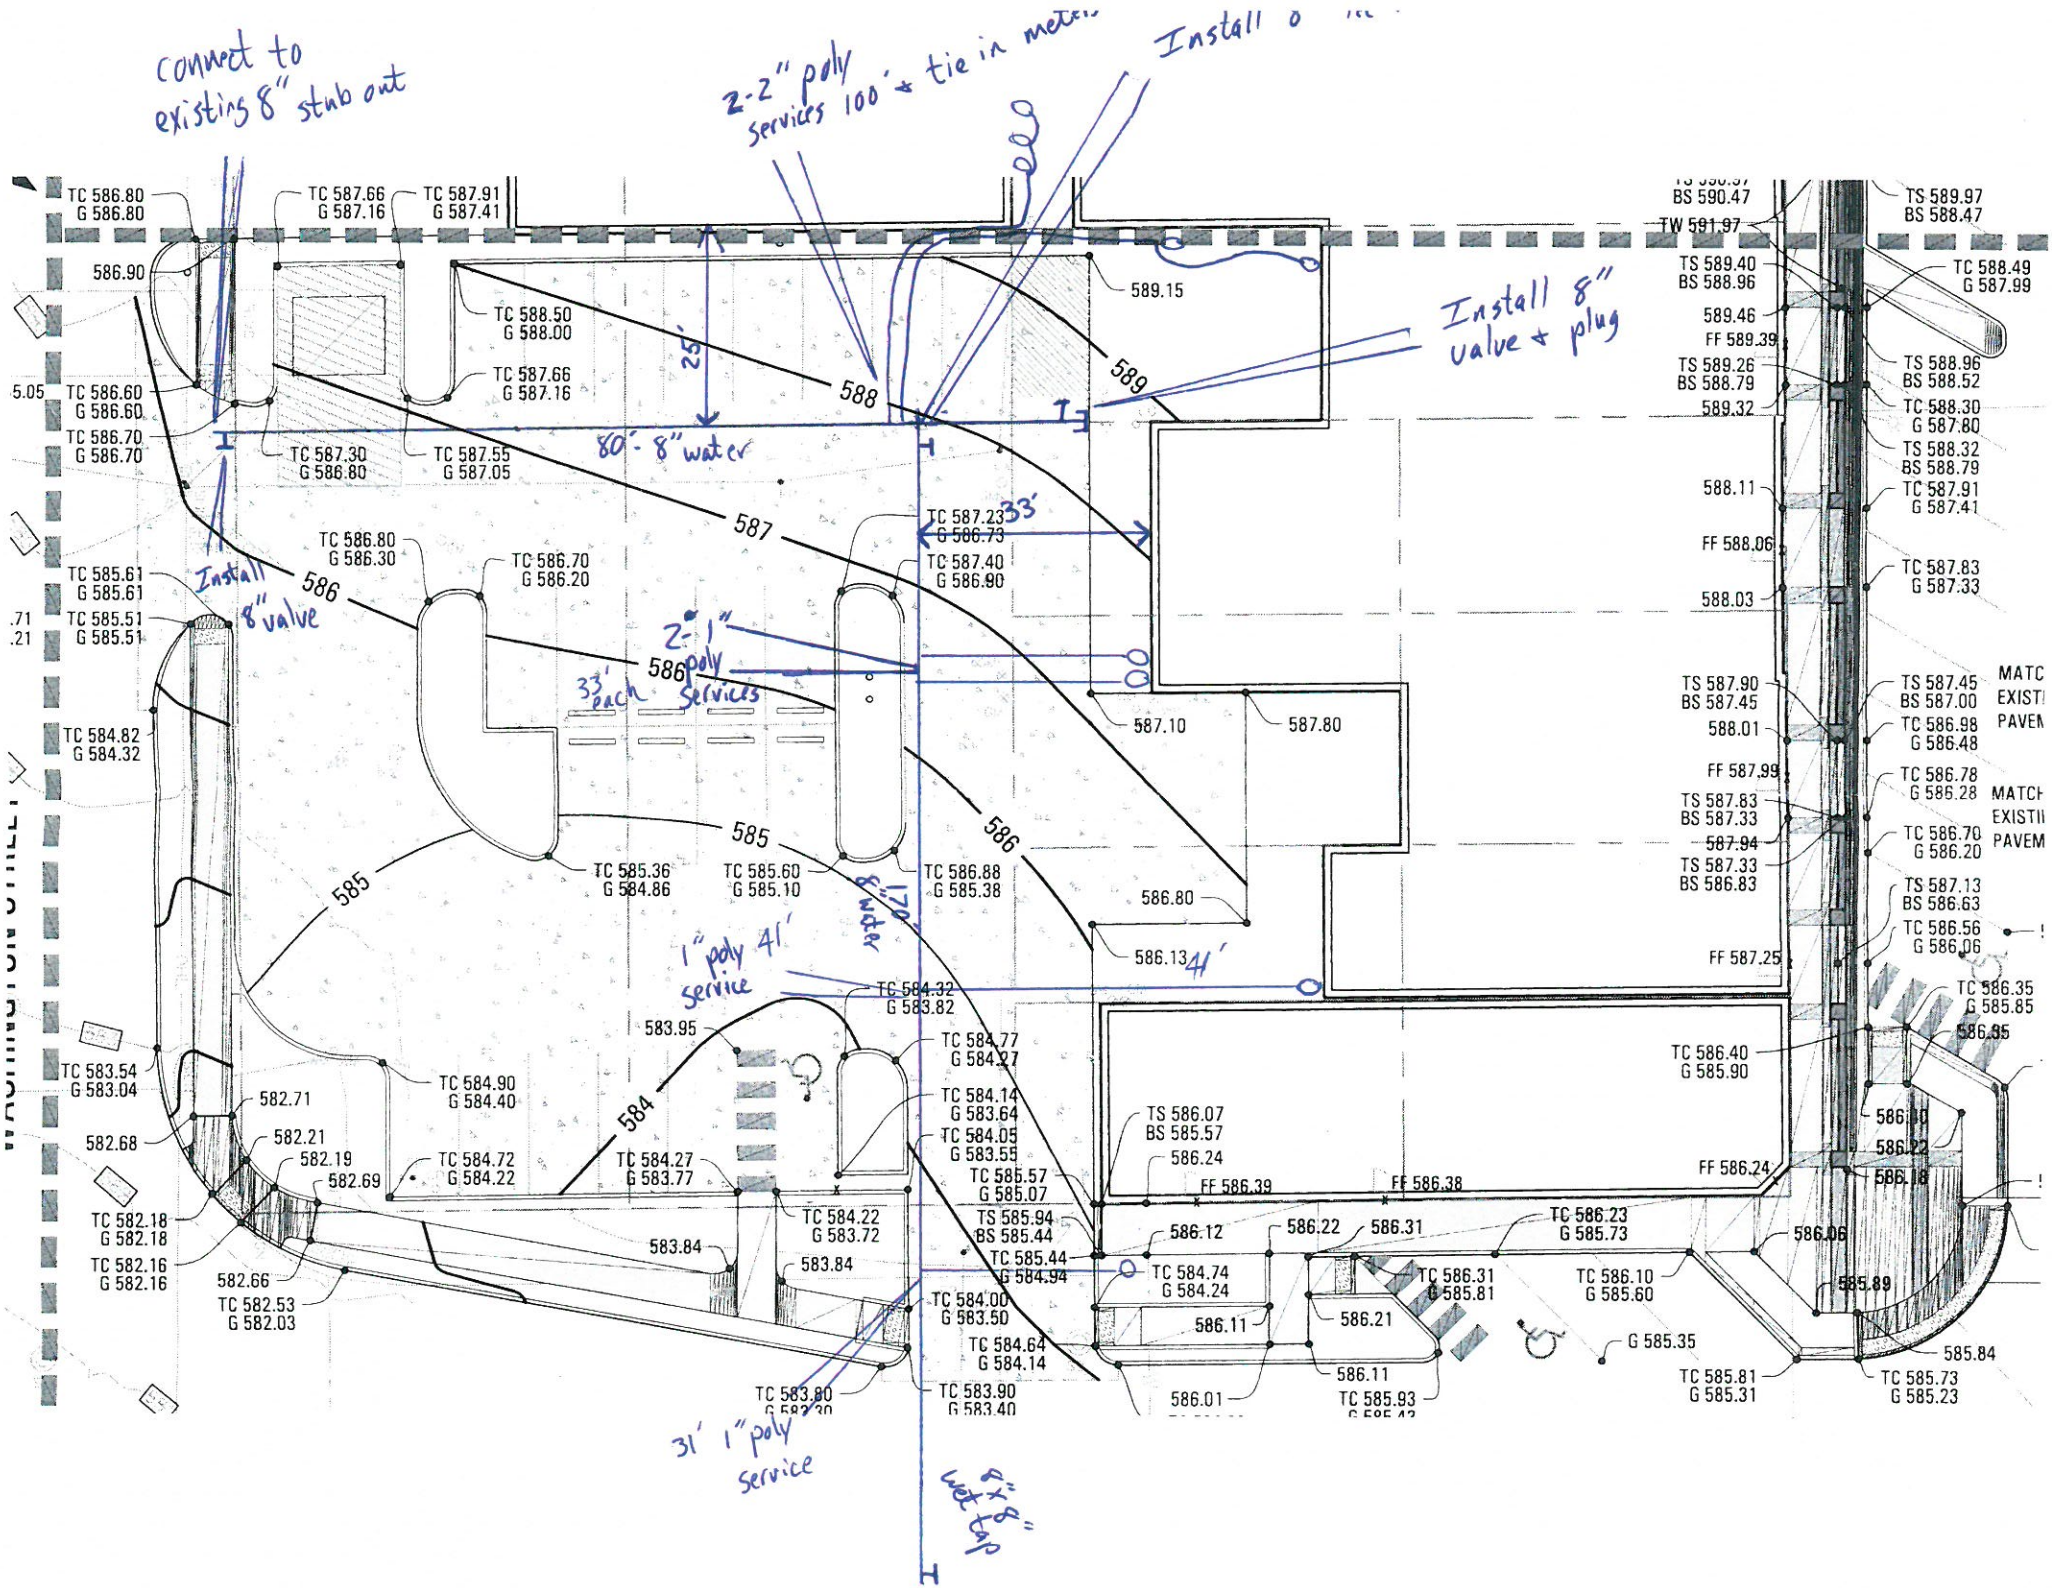
connect to existing 8" stub out
2-2" poly services 100' + tie in meter
Install 8" valve + plug
Install 8" valve
80' - 8" water
33'
33' each
2-1" poly services
1" poly 41'
1" poly service
31' 1" poly service
8" x 8" wet tap
TC 586.80 G 586.80
TC 587.66 G 587.16
TC 587.91 G 587.41
TC 588.50 G 588.00
TC 587.66 G 587.16
TC 586.60 G 586.60
TC 586.70 G 586.70
TC 587.30 G 586.80
TC 587.55 G 587.05
TC 587.23 G 586.73
TC 587.40 G 586.90
TC 586.80 G 586.30
TC 586.70 G 586.20
TC 585.61 G 585.61
TC 585.51 G 585.51
TC 584.82 G 584.32
TC 585.36 G 584.86
TC 585.60 G 585.10
TC 586.88 G 585.38
TC 584.32 G 583.82
TC 584.77 G 584.27
TC 584.14 G 583.64
TC 584.05 G 583.55
TC 585.57 G 585.07
TS 585.94 BS 585.44
TC 585.44 G 584.94
TC 584.74 G 584.24
TC 584.00 G 583.50
TC 584.64 G 584.14
TC 583.80 G 583.30
TC 583.90 G 583.40
TC 583.54 G 583.04
TC 584.90 G 584.40
TC 584.72 G 584.22
TC 584.27 G 583.77
TC 584.22 G 583.72
TC 582.18 G 582.18
TC 582.16 G 582.16
TC 582.53 G 582.03
TS 586.07 BS 585.57
TC 586.40 G 585.90
TC 586.23 G 585.73
TC 586.31 G 585.81
TC 586.10 G 585.60
TC 585.81 G 585.31
TC 585.73 G 585.23
TS 589.97 BS 588.47
TS 589.40 BS 588.96
TS 589.26 BS 588.79
TS 588.96 BS 588.52
TC 588.49 G 587.99
TC 588.30 G 587.80
TS 588.32 BS 588.79
TC 587.91 G 587.41
TC 587.83 G 587.33
TS 587.90 BS 587.45
TS 587.45 BS 587.00
TC 586.98 G 586.48
TC 586.78 G 586.28
TS 587.83 BS 587.33
TC 586.70 G 586.20
TS 587.33 BS 586.83
TS 587.13 BS 586.63
TC 586.56 G 586.06
TC 586.35 G 585.85
TC 585.35 G 585.31
TC 585.84 G 585.23
586.90
589.15
588
589
587
586
585
584
587.10
587.80
586.80
586.13
586.24
586.12
586.22
586.31
586.11
586.21
586.01
583.95
583.84
582.71
582.68
582.21
582.19
582.69
582.66
586.35
586.22
586.18
586.06
585.89
585.84
FF 589.39
589.46
589.32
588.11
FF 588.06
588.03
588.01
FF 587.99
587.94
FF 587.25
FF 586.39
FF 586.38
FF 586.24
TW 591.97
BS 590.47