8" Water Line "W-2"

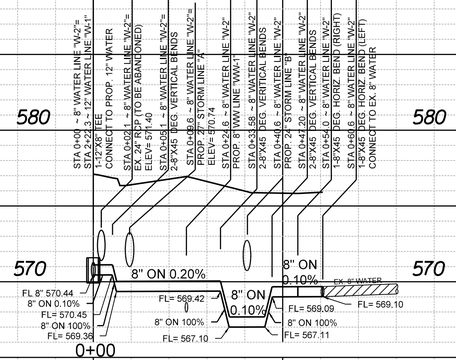

61 LF 8" PVC WATER PIPE
AWWA C900 PVC PIPE, DR-14 (PC-305)
CLASS "B-3" EMBEDMENT

8" Water Line "W-3"

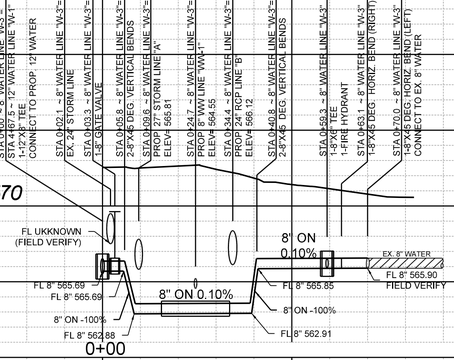

70 LF 8" PVC WATER PIPE
AWWA C900 PVC PIPE, DR-14 (PC-305)
CLASS "B-3" EMBEDMENT

8" Water Line "W-4"

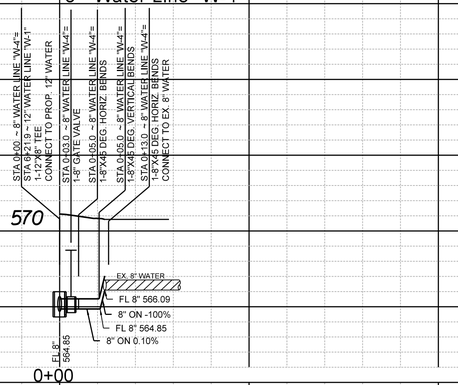

13 LF 8" PVC WATER PIPE
AWWA C900 PVC PIPE, DR-14 (PC-305)
CLASS "B-3" EMBEDMENT

8" Water Line "W-5"

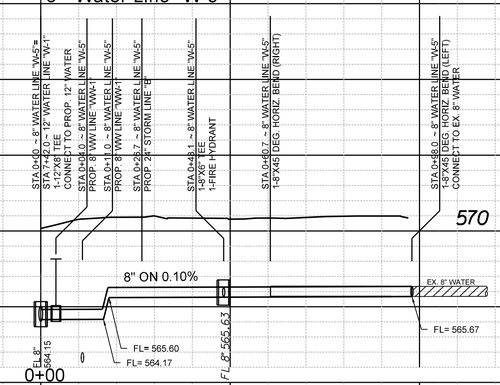

98 LF 8" PVC WATER PIPE
AWWA C900 PVC PIPE, DR-14 (PC-305)
CLASS "B-3" EMBEDMENT

8" Water Line "W-6"

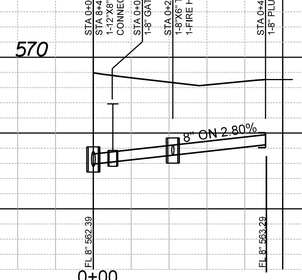

46 LF 8" PVC WATER PIPE
AWWA C900 PVC PIPE, DR-14 (PC-305)
CLASS "B-3" EMBEDMENT

8" Water Line "W-7"

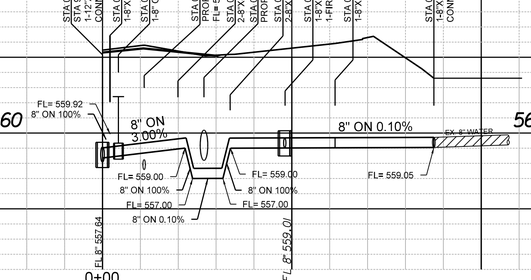

88 LF 8" PVC WATER PIPE
AWWA C900 PVC PIPE, DR-14 (PC-305)
CLASS "B-3" EMBEDMENT

8" Water Line "W-8"

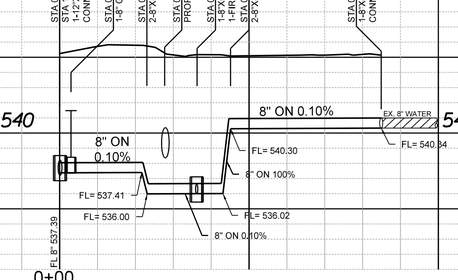

85 LF 8" PVC WATER PIPE
AWWA C900 PVC PIPE, DR-14 (PC-305)
CLASS "B-3" EMBEDMENT

8" WW Line "WW-2"

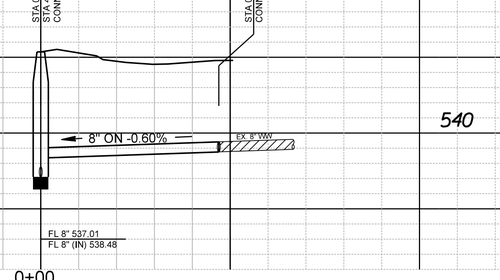

51 LF 8" PVC WASTEWATER PIPE
PRESSURE RATED WW PIPE
ASTM D 03034 (SDR 35)
CLASS "B-2" EMBEDMENT

STATE OF TEXAS
JASON A. PAYNE
101423
LICENSED
PROFESSIONAL ENGINEER

RECORD DRAWING
THIS DRAWING IS A COMPILATION OF A COPY OF THE SEALED ENGINEETING DRAWING FOR THIS PROJECT, MODIFIED BY ADDENDA, CHANGE ORDERS AND INFORMATION FURNISHED BY THE CONTRACTOR. THE INFORMATION SHOWN ON THE RECORD DRAWING THAT WAS PROVIDED BY THE CONTRACTOR OR OTHERS NOT ASSOCIATED WITH THE DESIGN ENGINEER CANNOT BE VERIFIED FOR ACCUACY OR COMPLETENESS. THE ORIGINAL SEALED DWAWINGS ARE ON FILE AT THE OFFICE OF EJES, INC., TBPE FIRM REGISTRATION No. 2488

James Allen, P.E., TX License No. 65929 — JULY 26, 2019 Date

EJES INCORPORATED
12655 N Central Expy, Suite # 500, Dallas, Texas 75243.
Tel # 214-343-1210, Fax # 214-343-3885
FIRM REGISTRATION No: F-2488

WATER & WASTEWATER PROFILE

E. BOYDSTUN AVE.

FROM S. GOLIAD ST TO S. CLARK ST

PUBLIC WORKS DEPARTMENT

CITY OF ROCKWALL, TEXAS

DESIGN	DRAWN	DATE	SCALE	NOTES	FILE	NO.
EJES	EJES	APRIL 2016	1"=20' H 1"= 5' V			66