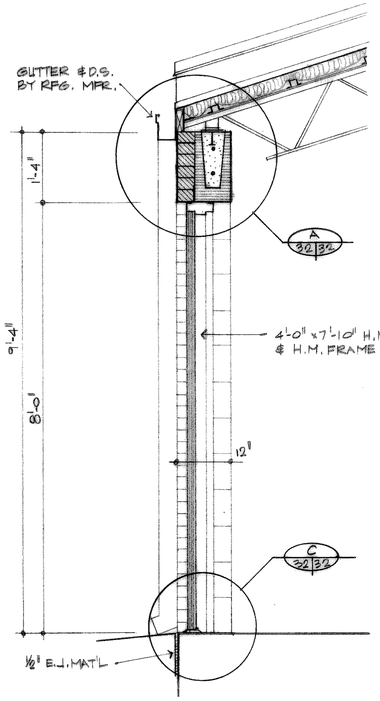

WALL SECTION 1 — 3/4"=1'-0" — SC — 31|32

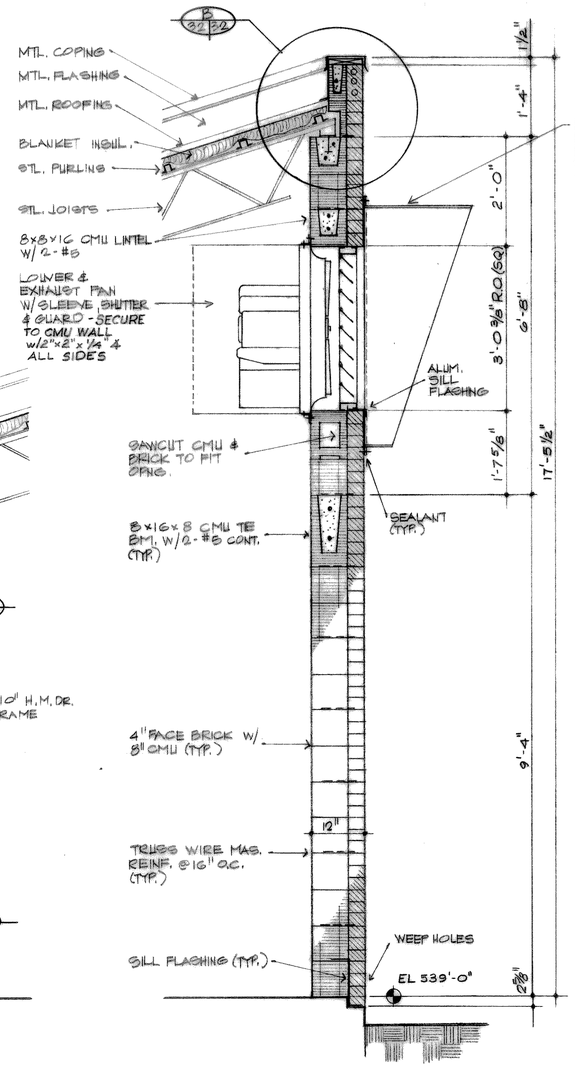

WALL SECTION 2 — 3/4"=1'-0" — SC — 31|32

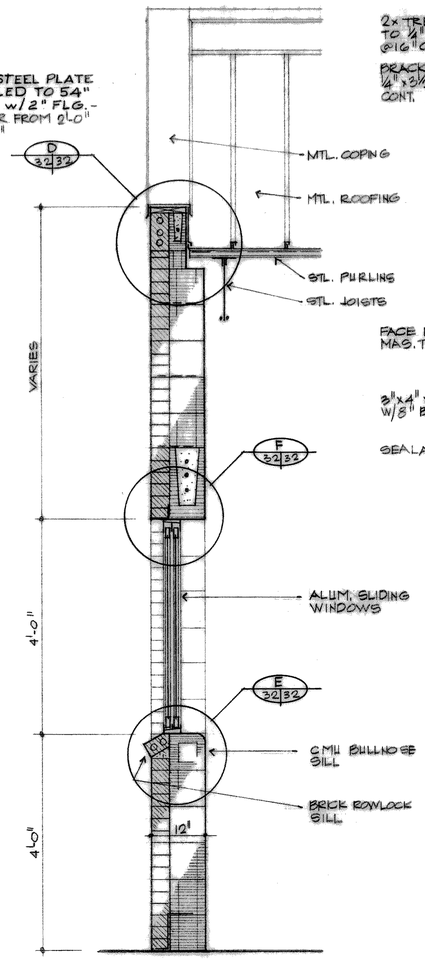

WALL SECTION 3 — 3/4"=1'-0" — SC — 31|32

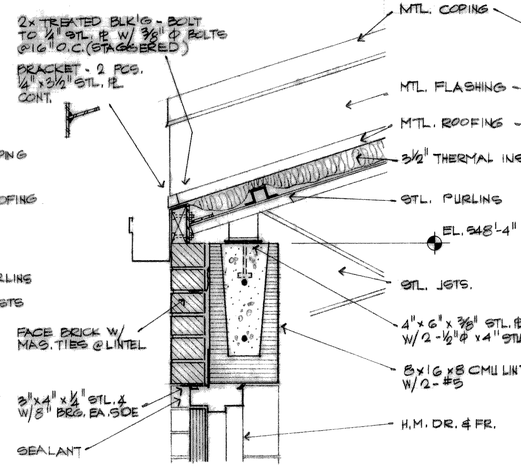

ROOFING DTL. — SC — 1½"=1'-0" — A — 31|32

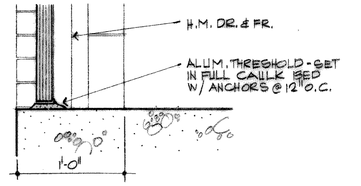

SILL — SC — 1½"=1'-0" — C — 32|32

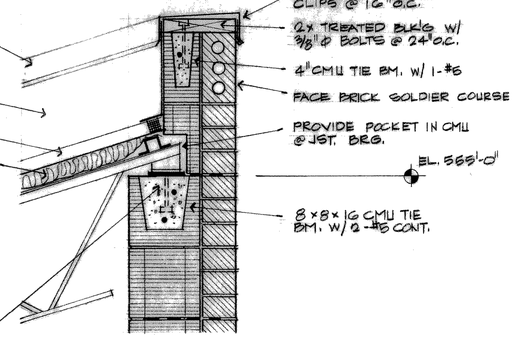

PARAPET DTL. — SC — 1½"=1'-0" — B — 31|32

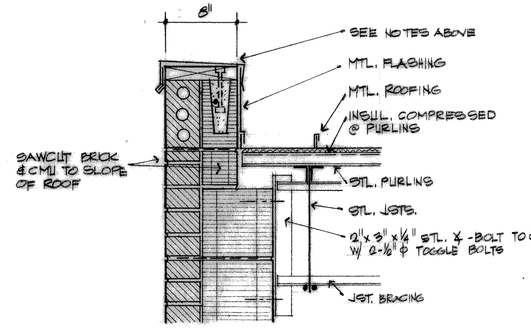

PARAPET DTL. — SC — 1½"=1'-0" — D — 31|32

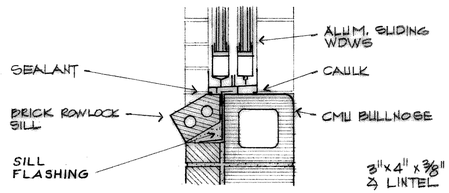

WINDOW SILL — SC — 1½"=1'-0" — E — 32|32

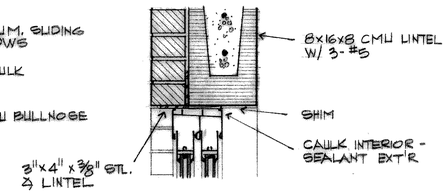

WINDOW HEAD — SC — 1½"=1'-0" — F — 32|32

RECORD DRAWING
BASED ON INFORMATION FURNISHED BY THE CONTRACTOR
10-2-92

REGISTERED ARCHITECT — STATE OF TEXAS — 2032
DEC 2, 1990

DESIGNED LB / DRAWN LB / TRACED / CHECKED LB	JOB NO. ROK 89005 / DATE 10/90 / SCALE NOTED	FREESE AND NICHOLS, INC. CONSULTING ENGINEERS FORT WORTH-ARLINGTON-AUSTIN, TEXAS	CITY OF ROCKWALL, TEXAS EASTSIDE PUMP STATION	ARCHITECTURAL PUMP STATION WALL SECTIONS & DETAILS	SHEET 32 OF 39

DATE | REVISION | BY

TELEPHONE (817) 336-5741