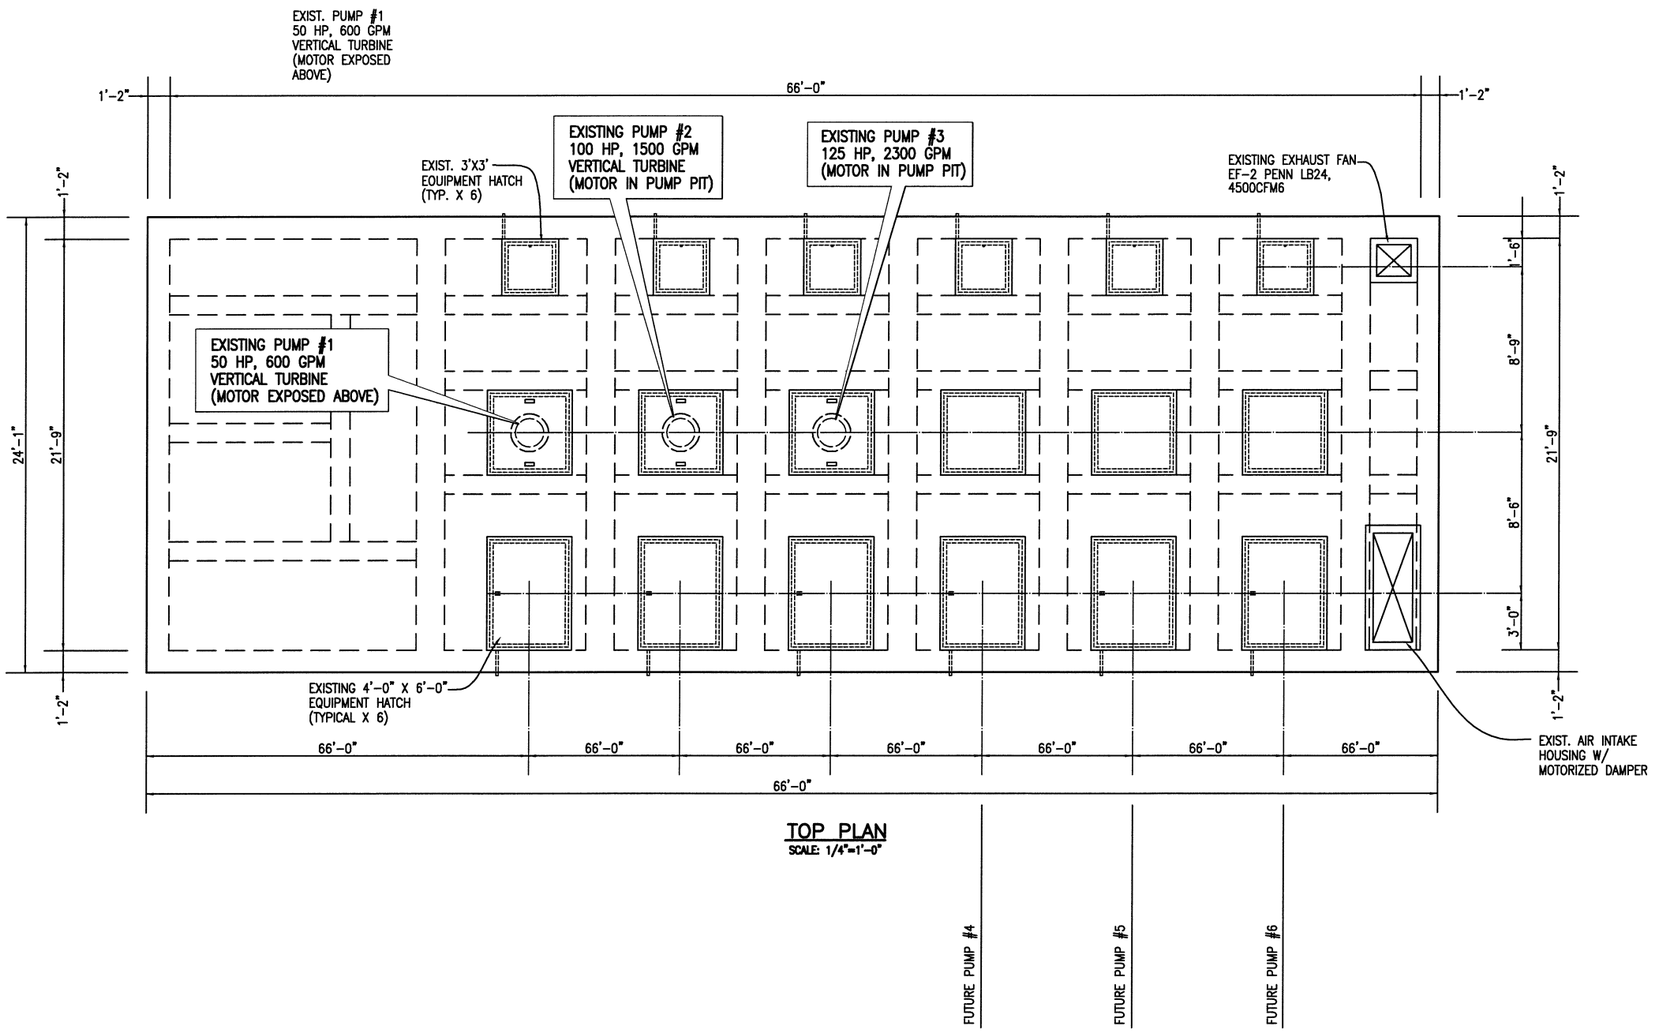

TOP PLAN
SCALE: 1/4"=1'-0"

This record drawing is a compilation of the sealed engineering drawing for this project; modified by addenda, change orders and information furnished by the contractor. The information shown on the record drawings that was provided by the contractor or others not associated with the design engineer cannot be verified for accuracy or completeness. This original sealed drawings are on file at the offices of Birkhoff, Hendricks & Conway, L.L.P.

BY G.C.H. DATE 05/06/09

04/06/1999

STATE OF TEXAS
GARY C. HENDRICKS
65228
REGISTERED
PROFESSIONAL ENGINEER

These plans and related specifications were prepared for construction of this specific project only. Reuse of these documents is not permitted without written authorization of Shimek, Jacobs & Finklea.

CITY OF ROCKWALL, TEXAS

EASTSIDE PUMP STATION
EXIST. ROOF PLAN

SHIMEK, JACOBS & FINKLEA, L.L.P.
CONSULTING ENGINEERS
Dallas, Texas

DESIGNED BY: G.C.H.	PROJECT: 98 192	SHEET NO. 2
DRAWN BY: S.J. & F.	DATE: APRIL 1999	OF 12 SHEETS

4/06/99 JLY SCALE: 1-48 H:\PROJECTS\ROCKWALL\98192\SHEETS\98192-02.DWG