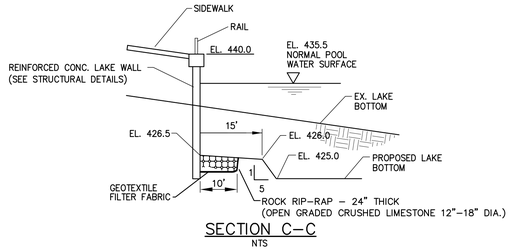

SECTION C-C
NTS

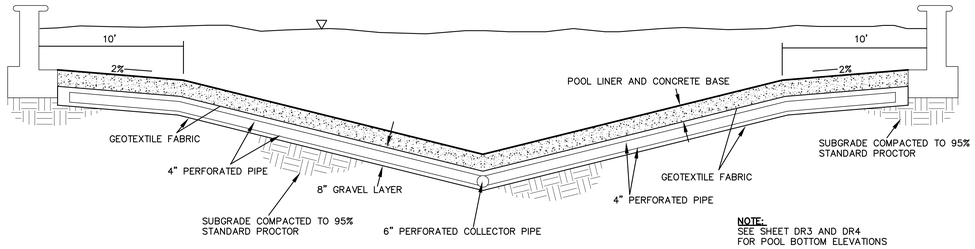

TYPICAL UNDER POOL DRAINAGE SYSTEM
NTS

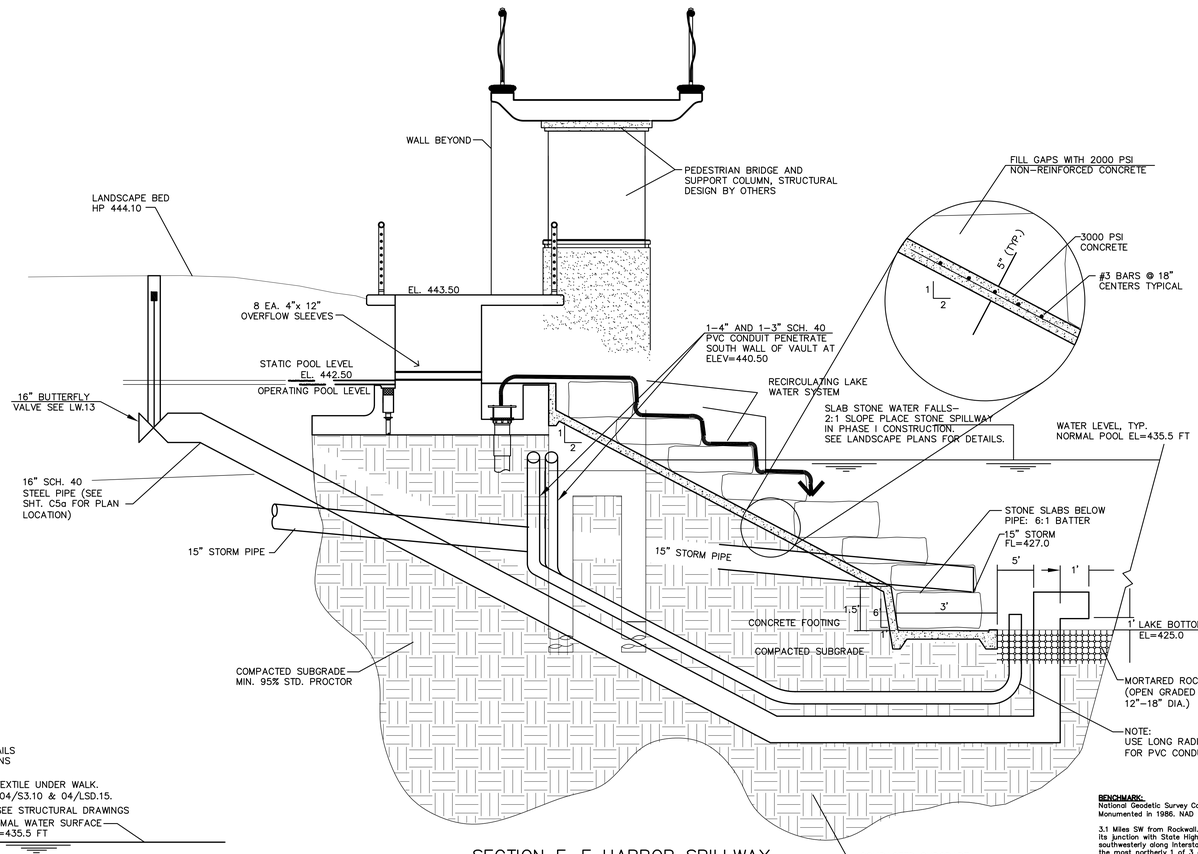

SECTION E-E HARBOR SPILLWAY
NTS

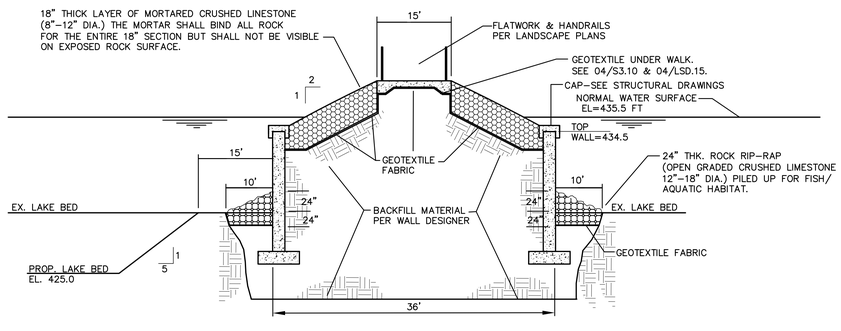

JETTY SECTION F-F
NTS

©Copyright 2005 Brockette/Davis/Drake, Inc. All Rights Reserved.
This drawing is the property of Brockette/Davis/Drake, Inc. and is not to be used in any way.
Any modification or use of this drawing without the express
written authorization of Brockette/Davis/Drake, Inc. is prohibited

BENCHMARK:
National Geodetic Survey Control. Designation: Q 1498, PID: CS2517, Monumented in 1986. NAD 83: 32 53 24 (N) / 096 29 22 (W).

3.1 Miles SW from Rockwall. 1.7 Miles southerly along State Highway 205 from its junction with State Highway 66 in Rockwall, Thence 1.45 Miles southwesterly along Interstate Highway 30, set vertically in the north face of the most northerly 1 of 3 columns of the first pier east of the west abutment of the southwest bound highway overpass of Farm Road 740 (exit 67), and 20.7 feet west of the center of the Farm Road. The Mark is 1.4 meters above the Farm Road.

ELEVATION = 445.31 feet (NAVD 88)

RECORD DRAWING

NOTE:
THESE PLANS HAVE BEEN REVISED TO CONFORM WITH CONSTRUCTION RECORDS PROVIDED BY THE CONTRACTOR.

DETAILS

ROCKWALL WATERFRONT PARK PACKAGE 2

ROCKWALL, TEXAS

BROCKETTE • DAVIS • DRAKE, INC.
consulting engineers
Civil & Structural Engineering · Surveying
4144 North Central Expressway, Suite 1100 · Dallas, Texas 75204
(214) 824-3647 · fax (214) 824-7064

DESIGNED	DRAWN	DATE	SCALE	NOTES	FILE	NO.
TNA	BDD	10/2005	NTS	BDD	C03360	DT1

TBG PARTNERS
Landscape Architects · Planners
302 North Market, Suite 450
Dallas, Texas 75202
214/744-0757 Fax: 214/744-6785
Austin · Dallas · Houston · McAllen

Project:
City of Rockwall

The Harbor
Phase I
Public Improvements

Rockwall, Texas

Project Number:
D03991

BROCKETTE • DAVIS • DRAKE, INC.
consulting engineers
Civil & Structural Engineering · Surveying
4144 North Central Expressway, Suite 1100 · Dallas, Texas 75204
(214) 824-3647 · fax (214) 824-7064

Designed:

Drawn:

Reviewed:

Date Issued:
13 July 2005

Revisions:

Sheet Title:
DETAILS

Sheet Number:
DT1

M:\Data\Civil\2003\C03360 - ROCKWALL WATERFRONT PARK\CD\PHASE II\PACKAGE 2\DT1-DETAILS-RWP.dwg, 1/11/2010 1:09:13 PM