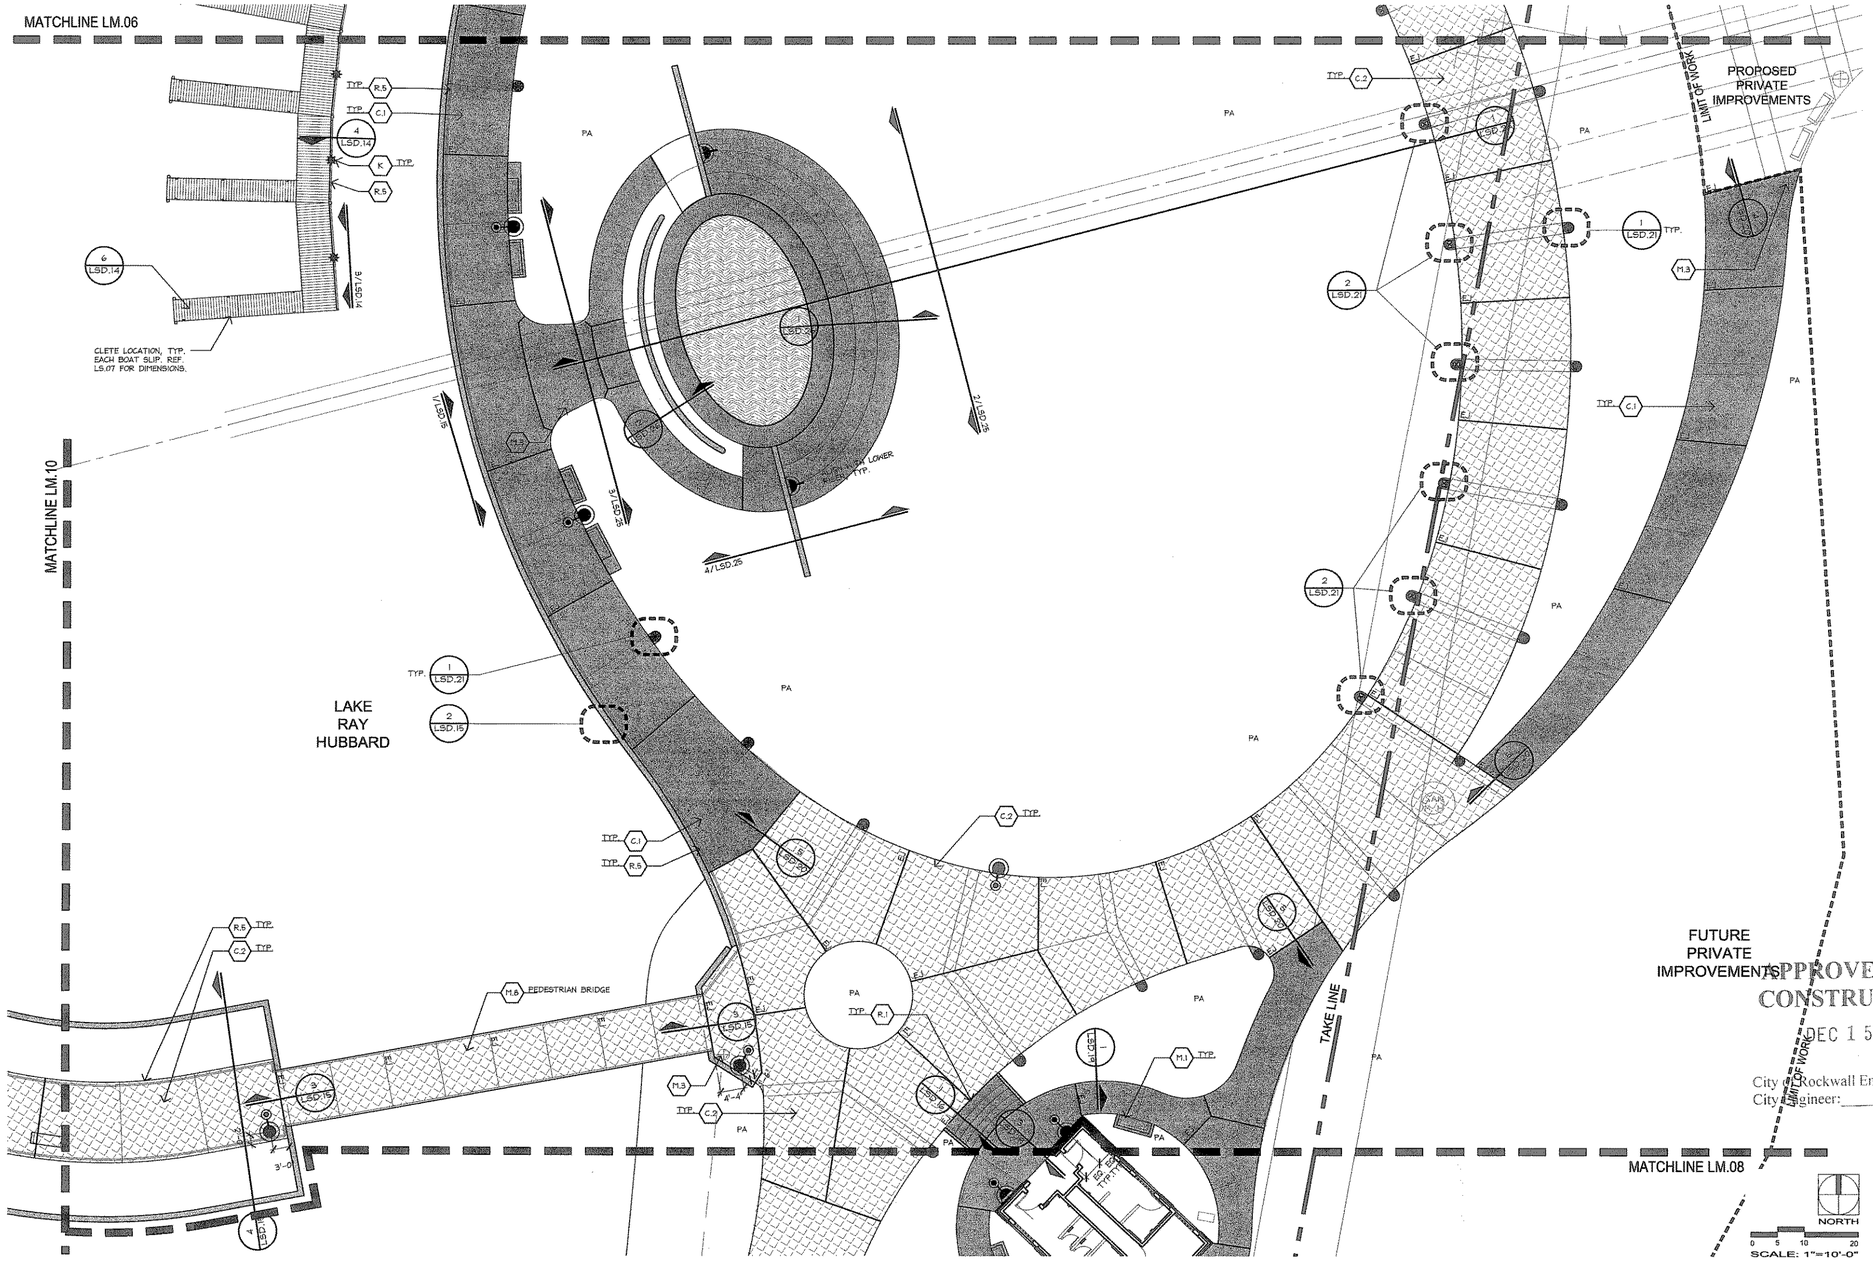

LIGHTING LEGEND

A	POLE TOP - 1 LUMINAIRE (SIDE MOUNT)	H	POLE TOP - WALL MOUNT
B	WALL LIGHT	I	IN-GRADE PATH LIGHT
C	STEP LIGHT	J	BOLLARD
D	TREE UP-LIGHT	K	BOLLARD - LUMINAIRE ONLY
E	WALL LIGHT	L	IN-GRADE JUNCTION BOX
F	POLE TOP - 1 LUMINAIRE	M	POLE
G	POLE LIGHT - 2 LUMINAIRES	124.00 TL	PROPOSED TOP OF LIGHT ELEVATION

Key Map

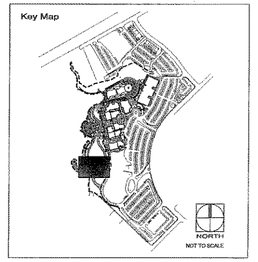

APPROVED FOR CONSTRUCTION
DEC 15 2005
City of Rockwall Engineering Dept.
City Engineer:

TBG PARTNERS

REGISTERED LANDSCAPE ARCHITECT JAMES A. MANNEY STATE OF TEXAS
7/13/05

Landscape Architects · Planners
302 North Market, Suite 450
Dallas, Texas 75202
214/744-0757 Fax: 214/744-6785
Austin · Dallas · Houston · McAllen

Project:

City of Rockwall

The Harbor
Phase I
Public Improvements

Rockwall, Texas

Project Number:
D03991

Designed: tbg
Drawn: bb
Reviewed: jm, kh

Date Issued:
13 July 2005

Revisions:

Sheet Title:
Landscape Materials-South Amphitheater

Sheet Number:
LM. 07