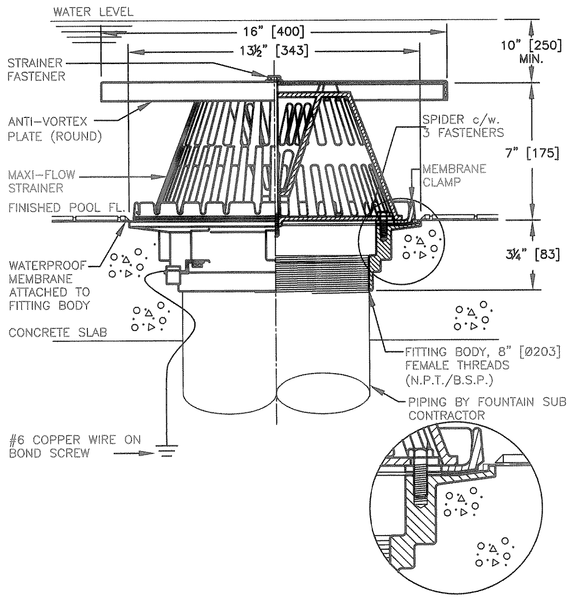

A DSA-800L MAIN BASIN DRAIN FITTING

DETAIL SCALE : N.T.S.

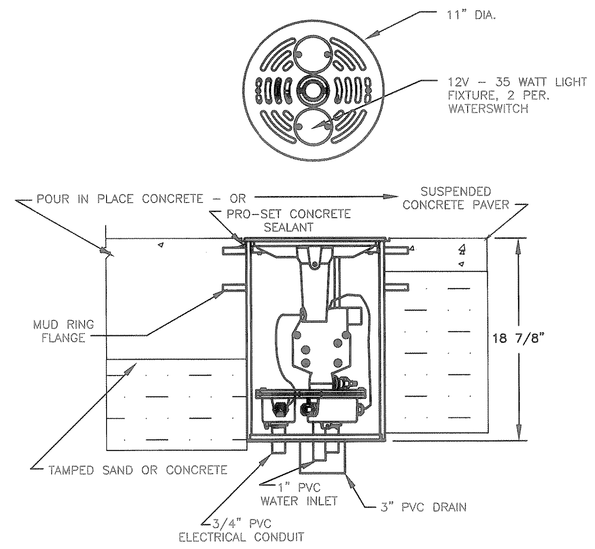

B NWS-133 PLAZA DECK NOZZLE/LIGHT

DETAIL SCALE : N.T.S.

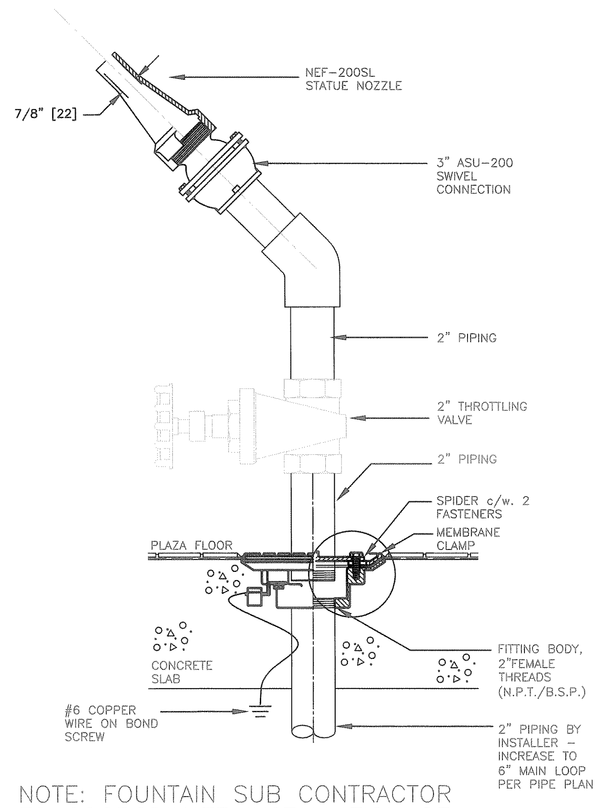

NOTE: FOUNTAIN SUB CONTRACTOR TO COORODINATE INSTALLATION OF STATUE NOZZLES WITH ARCHITECT AND STATUE ARTIST

C NEF-200SL STATUE NOZZLE ASSEMBLY

DETAIL SCALE : N.T.S.

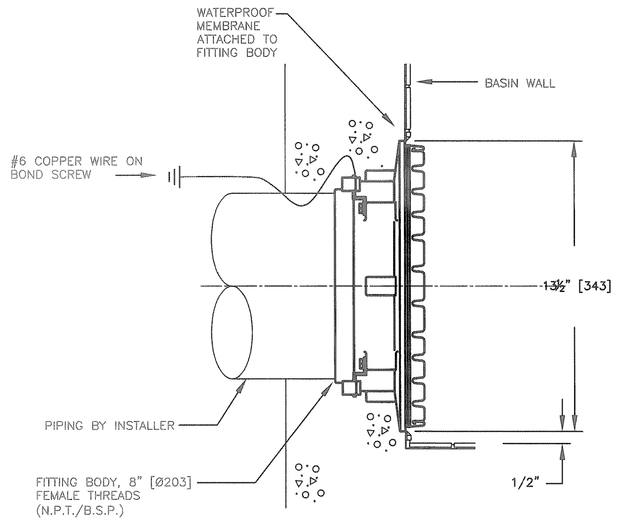

D DUS-800 DRAIN PIPE TO TROUGH SLEEVE

DETAIL SCALE : N.T.S.

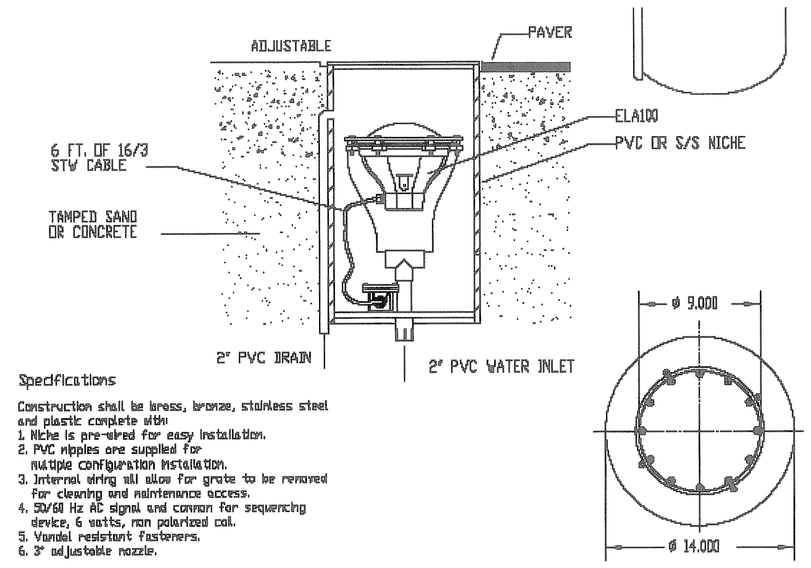

Specifications

Construction shall be brass, bronze, stainless steel and plastic complete with:
1. Niche is pre-wired for easy installation.
2. PVC nipples are supplied for multiple configuration installation.
3. Internal wiring will allow for grate to be removed for cleaning and maintenance access.
4. 50/60 Hz AC signal and common for sequencing device, 6 watts, non polarized coil.
5. Vandal resistant fasteners.
6. 3" adjustable nozzle.

E CUSTOM DECK MOUNT 300 WATT LIGHT

DETAIL SCALE : N.T.S.

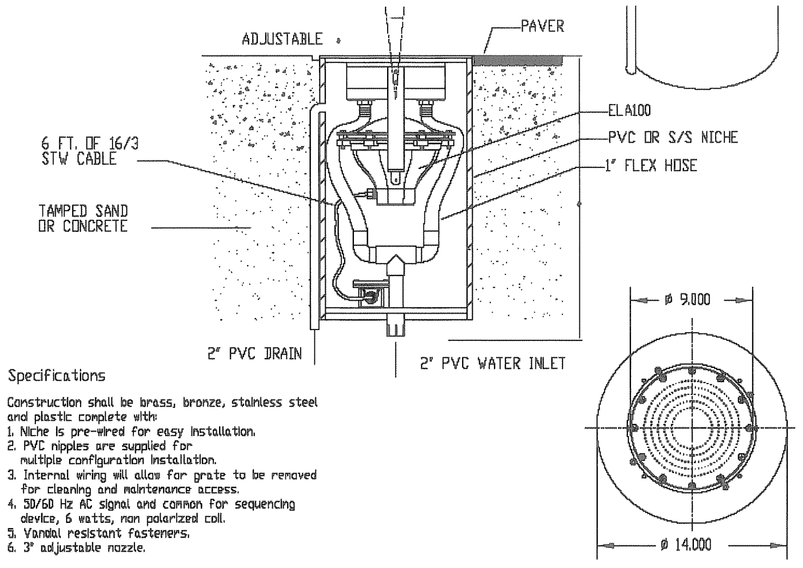

Specifications

Construction shall be brass, bronze, stainless steel and plastic complete with:
1. Niche is pre-wired for easy installation.
2. PVC nipples are supplied for multiple configuration installation.
3. Internal wiring will allow for grate to be removed for cleaning and maintenance access.
4. 50/60 Hz AC signal and common for sequencing device, 6 watts, non polarized coil.
5. Vandal resistant fasteners.
6. 3" adjustable nozzle.

F CUSTOM DECK MOUNT CENTER NOZZLE/LIGHT ASSEMBLY

DETAIL SCALE : N.T.S.

TBG
PARTNERS
Landscape Architects · Planners
302 North Market, Suite 450
Dallas, Texas 75202
214/744-0757 Fax: 214/744-6785
Austin · Dallas · Houston · McAllen

Greenscape Pump Services, Inc.
• DESIGN • CONSULTING • CONTRACTING •
• SALES • SERVICE •
Headquarters
1425 Whitlock, Suite 108
Carrollton, Texas 75006
Ph: 972-446-0037 Fax: 972-446-0313

© 2006 GREENSCAPE PUMP SERVICES, INC.

THE HARBOR
ROCKWALL, TEXAS

REGISTRATION

No.	ISSUE/REVISIONS	DATE
1	POST-BID ADDENDUM	01/17/06
2	AS BUILT	11/10/06

SHEET TITLE

PLAZA COMPONENT DETAILS

JOB NO. 4930
DATE: JULY 12, 2005
DRAWN BY: GDR CHECKED BY:
FILE: 4930_THEHARBOR_AsBuilt_110706

SHEET NUMBER

LW.11B