


**CURVE DATA**

1. Δ: 24°00'	2. Δ: 5°40'00"	3. Δ: 18°35'00"
R: 70.0'	R: 200.0'	R: 70.0'
T: 14.88'	T: 9.90'	T: 11.45'
L: 29.32'	L: 19.78'	L: 22.70'

**NOTE:** Contractor to Verify in the Field Location of all existing utilities prior to Construction. Information provided does not relieve the Contractor of the full responsibility for the protection of all existing utilities nor any damages caused by said Contractor during Construction.

**BENCHMARK:**  
Bolt on top of F.Hydt. South of Williams St at int. of Austin Street & Williams Street.  
ELEV. = 571.94

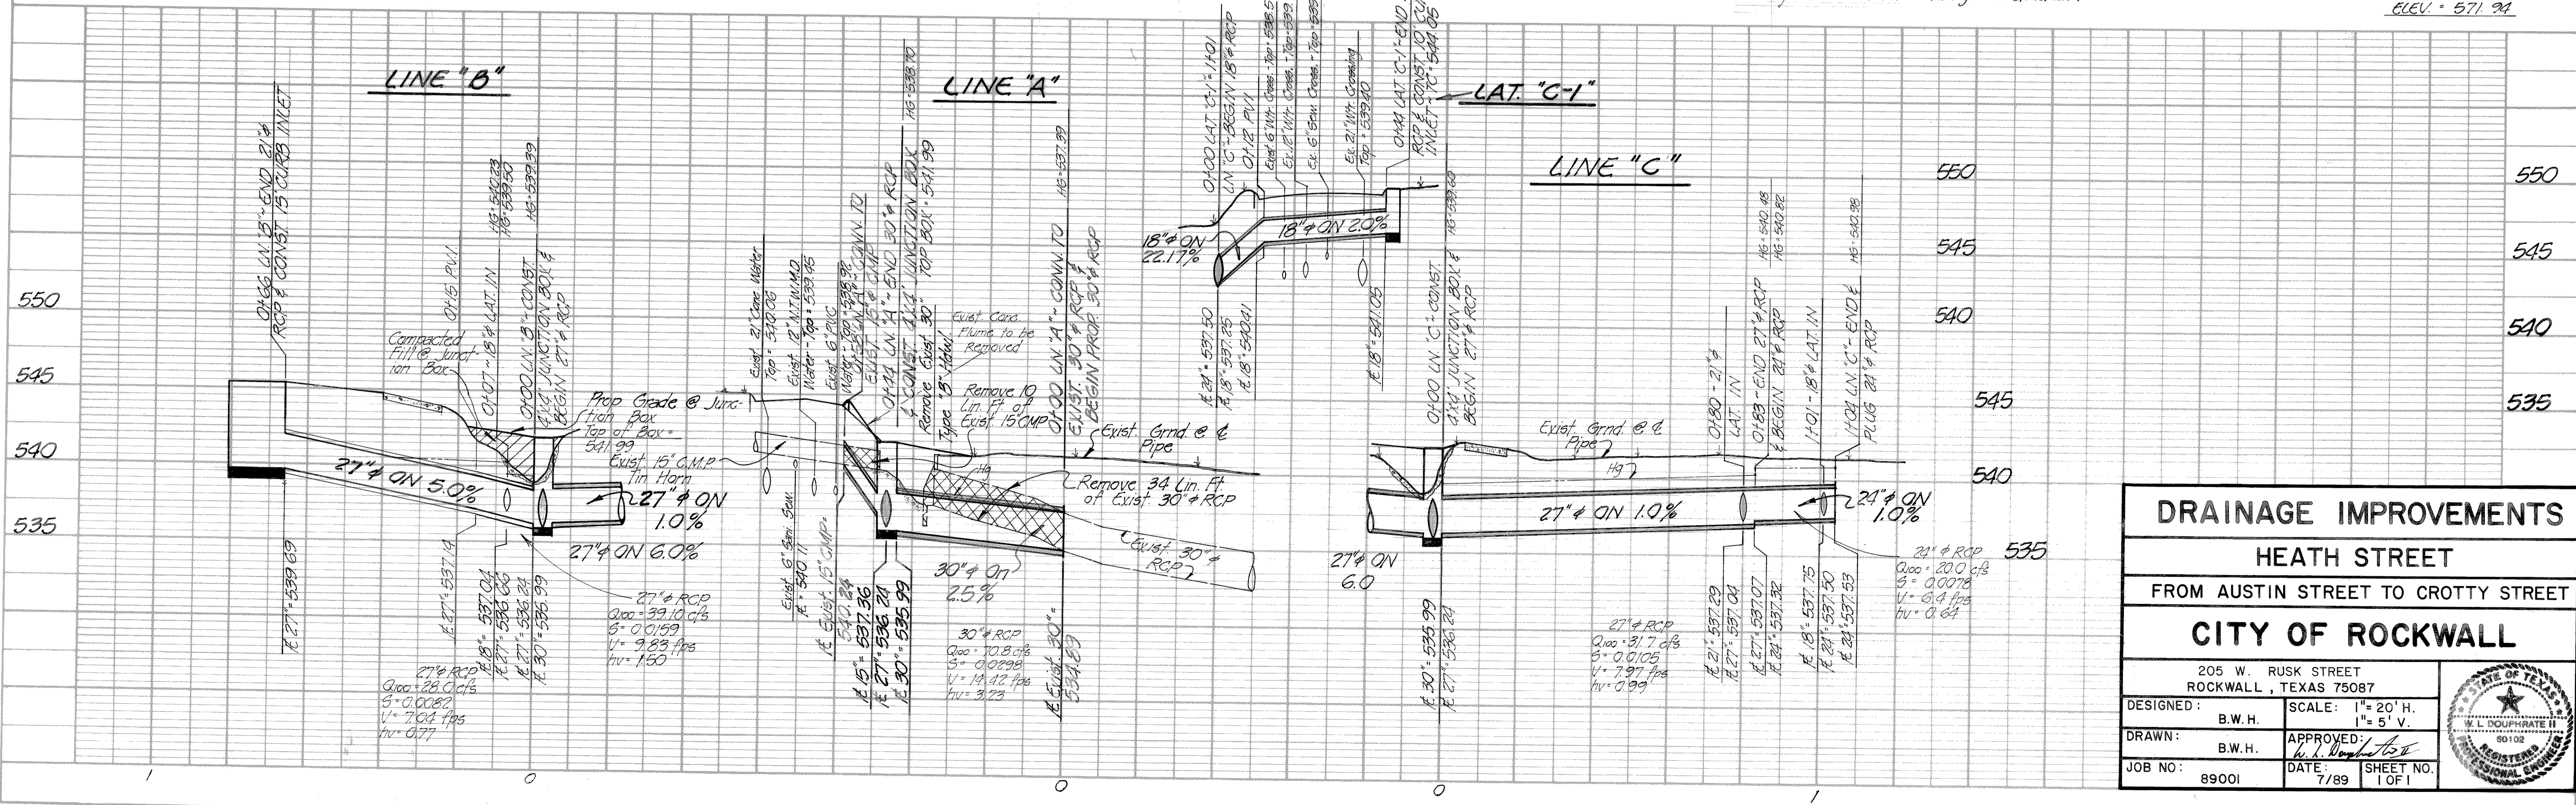

<b>DRAINAGE IMPROVEMENTS</b>	
<b>HEATH STREET</b>	
<b>FROM AUSTIN STREET TO CROTTY STREET</b>	
<b>CITY OF ROCKWALL</b>	
205 W. RUSK STREET ROCKWALL, TEXAS 75087	
DESIGNED: B.W.H.	SCALE: 1"=20' H. 1"=5' V.
DRAWN: B.W.H.	APPROVED: <i>[Signature]</i>
JOB NO: 89001	DATE: 7/89 SHEET NO. 1 OF 1

