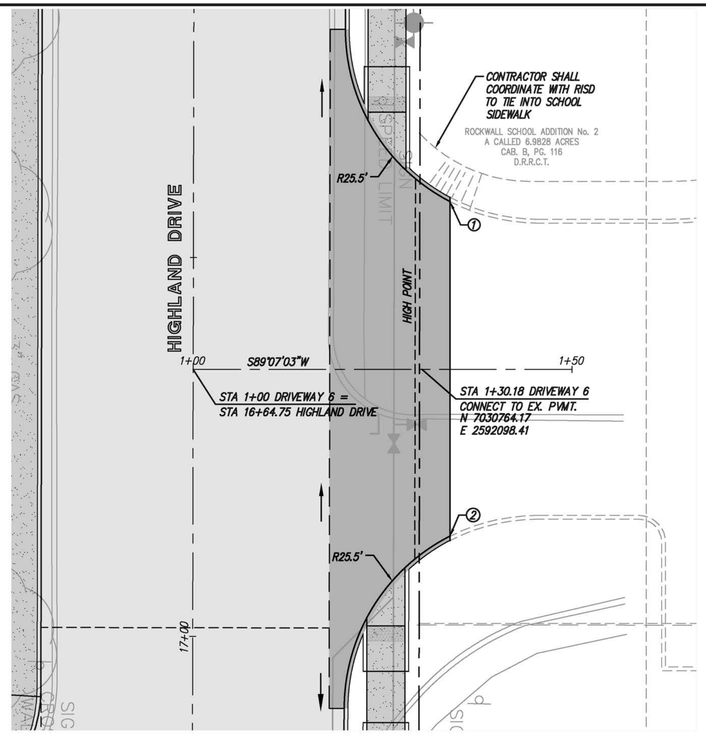

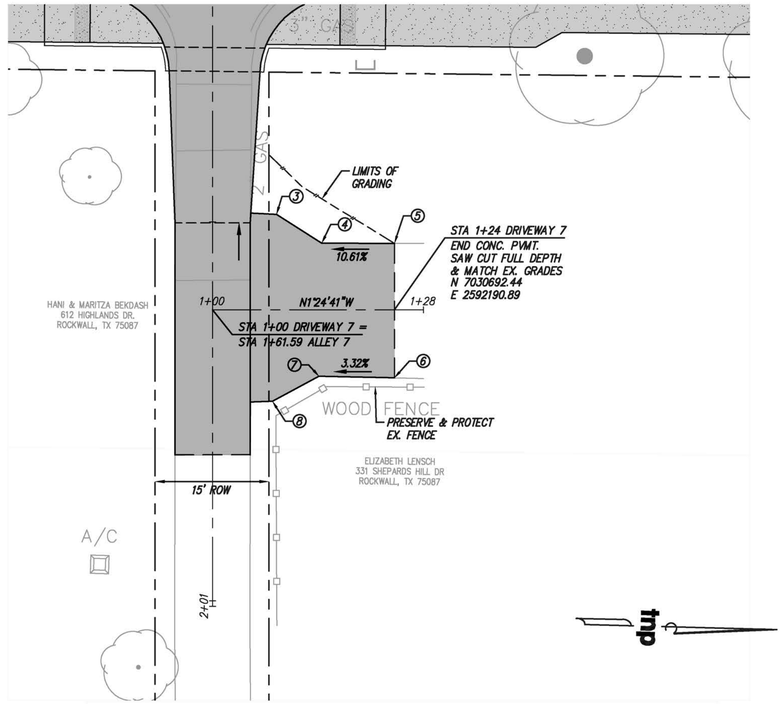

UTILITY NOTE

THE UTILITIES SHOWN ON THE PLANS WERE COMPILED FROM VARIOUS SOURCES AND ARE INTENDED TO SHOW THE GENERAL EXISTENCE AND LOCATION OF UTILITIES IN THE AREA OF CONSTRUCTION. THE ENGINEER ASSUMES NO RESPONSIBILITY FOR THE ACCURACY OF THE UTILITY INFORMATION SHOWN ON THE PLANS. THE CONTRACTOR SHALL VERIFY THE EXACT LOCATION OF ALL UTILITIES PRIOR TO CONSTRUCTION. THE CONTRACTOR SHALL CONTACT UTILITY COMPANIES 48 HOURS IN ADVANCE OF ANY CONSTRUCTION ACTIVITIES IN ORDER TO DETERMINE IF THERE IS ANY CONFLICT WITH THE PROPOSED FACILITIES. THE CONTRACTOR SHALL NOTIFY THE ENGINEER IMMEDIATELY WHEN CONFLICTS WITH EXISTING UTILITIES ARE DISCOVERED.

POINT TABLE: DRIVEWAY 6				
#	STA	OFFSET	DESC	T/P
1	1+33.89	22.13 LT	PI	552.23
2	1+33.89	22.05 RT	PI	552.66

POINT TABLE: DRIVEWAY 7				
#	STA	OFFSET	DESC	T/P
3	1+08.45	12.59 LT	PI	554.51
4	1+14.54	8.77 LT	PI	555.26
5	1+24	8.76 LT	PI	556.28
6	1+24	8.99 RT	PI	557.01
7	1+14.05	8.77 RT	PI	556.68
8	1+07.90	12.08 RT	PI	556.45

LEGEND

- PROP. 6" CONCRETE DRIVEWAY
- PROP. 8" CONCRETE PAVEMENT
- PROP. 4" CONCRETE SIDEWALK

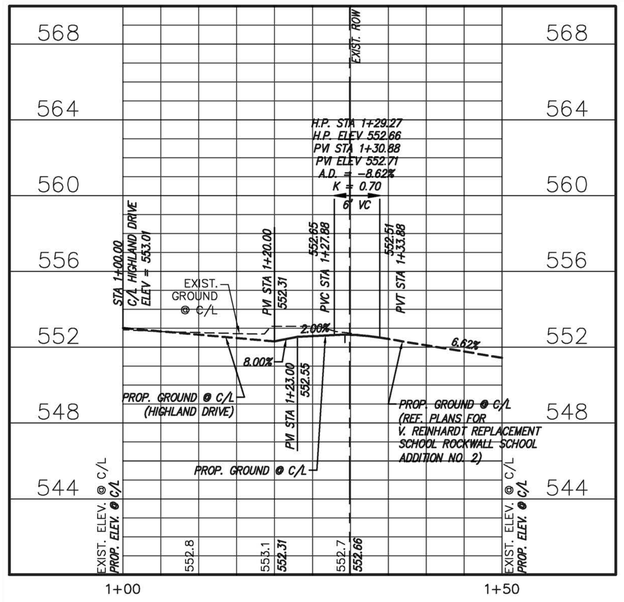

DRIVEWAY 6

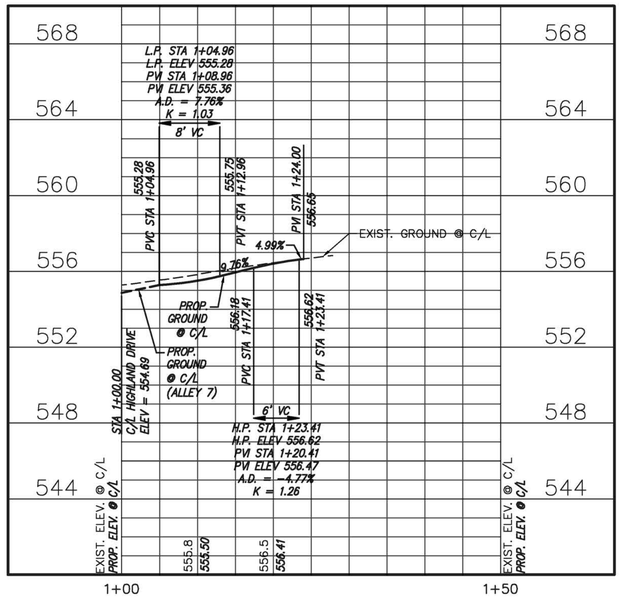

DRIVEWAY 7

GRAPHIC SCALE
10 0 5 10 20
GRAPHIC SCALE: 1" = 10'

no.	revision	by	date

teague nall and perkins, inc
825 Watters Creek Blvd., Suite M300
Allen, Texas 75013
214.461.9867 ph 214.461.9864 fx
www.tnpinc.com
TBPE: F-230; TBPLS: 10011600, 10011601, 10194381

City of Rockwall
The New Horizon

scale	
when bar is 1 inch long	
horiz	1" = 10'
vert	1" = 4'
SEP 2019	

tnp

RECORD DOCUMENTS

THESE PLANS ARE FOR THE OWNER'S USE AS RECORD SET OF THE CONSTRUCTED PROJECT, AND REFLECT REVISIONS AND CONSTRUCTION RELATED CHANGES AS RECORDED BY THE CONTRACTOR. CHANGES MADE FROM THE ORIGINAL CONSTRUCTION DOCUMENTS DO NOT DEPICT ENGINEERING AND ARE NOT THE RESPONSIBILITY OF TEAGUE NALL & PERKINS, INC. OR THE ENGINEER OF RECORD ON THE ORIGINAL DOCUMENTS. ORIGINAL PLANS RELEASED FOR CONSTRUCTION WERE SEALED BY GYANENDRA POKHREL, P.E. NO. 118159 ON 09/28/2018.

CITY OF ROCKWALL, TEXAS

HIGHLAND DRIVE RECONSTRUCTION, PHASE I

(DRIFTWOOD STREET TO BEDFORD FALLS LANE)

PAVING PLAN & PROFILE
DRIVEWAY 6 & 7

tnp project	
RWL18219	
sheet	41

Drawing: P:\PROJECTS\RWL18219\CAD\Sheets\PHASE 1 - NORTH\43 PAVING PLAN & PROFILE - DRIVEWAY 6 & 7.dwg ot Sep 27, 2019 - 10:43am by jbokolie
Layout: 43 PAVING PLAN & PROFILE - DRIVEWAY 6 & 7 Xrefs: xref-border.dwg - x3d-base.dwg - x3d-sewer.dwg - x3d-water.dwg - x3d-paving.dwg - X3D-SCHOOL SITE.dwg