13+50

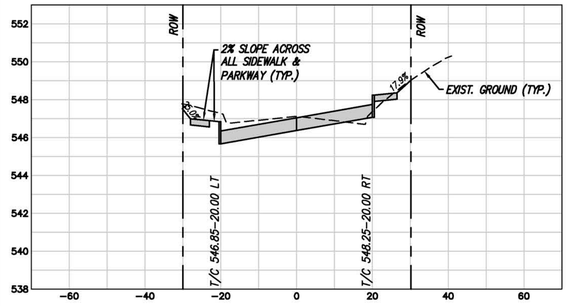

13+75

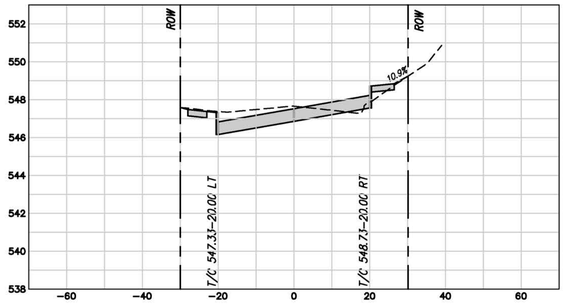

14+00

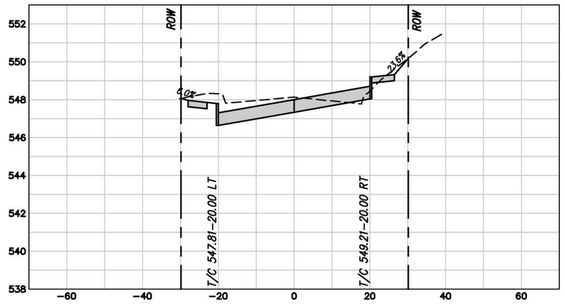

14+25

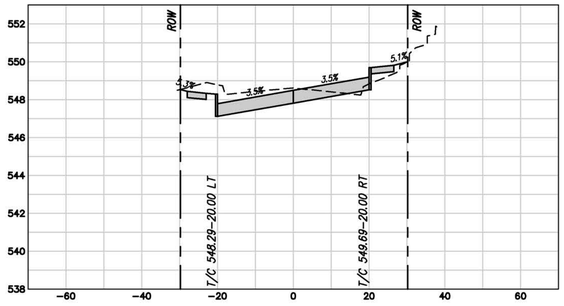

14+27.65

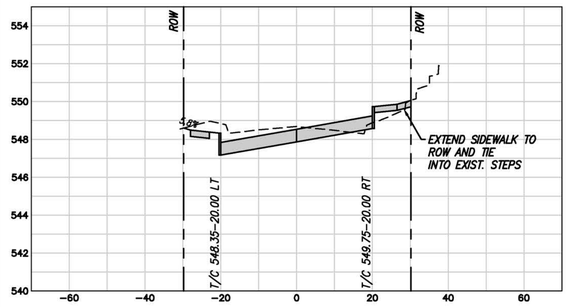

14+50

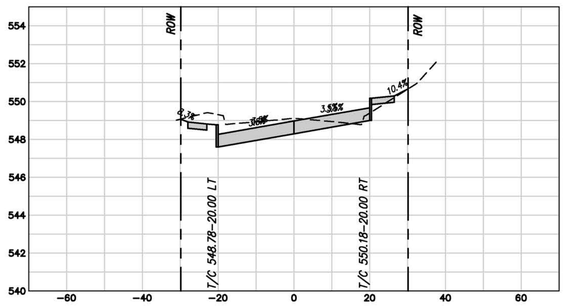

14+75

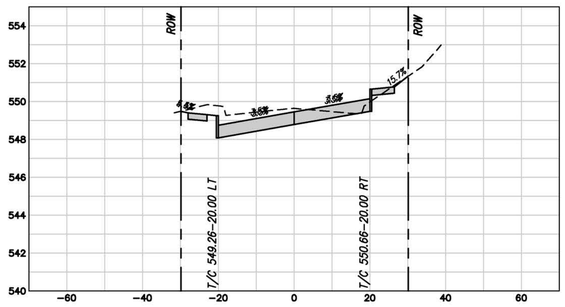

15+00

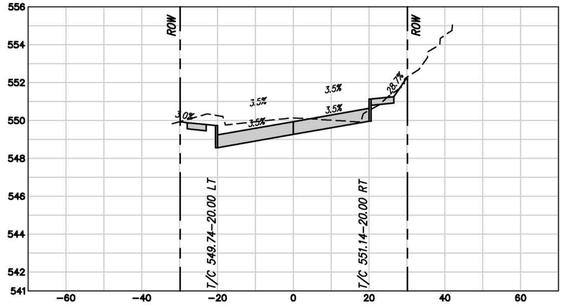

15+03.59

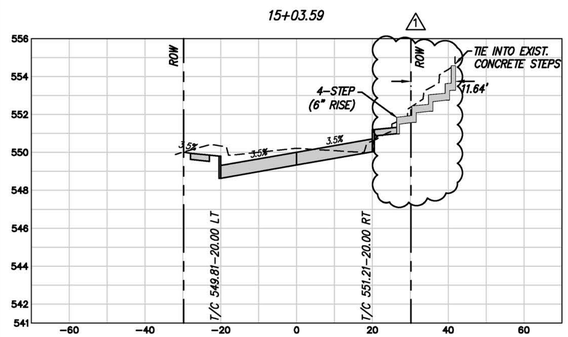

15+25

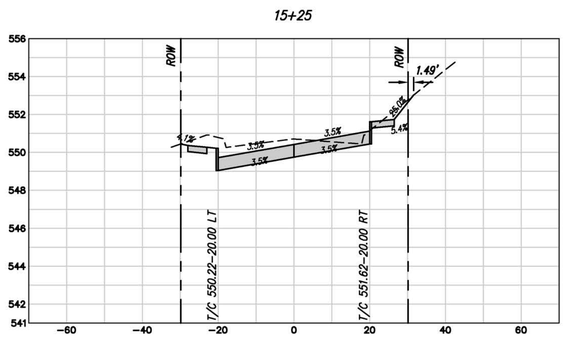

15+50

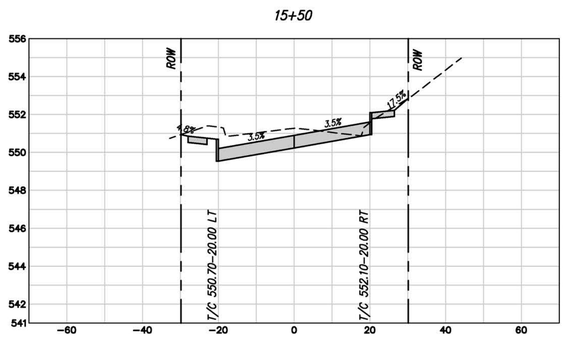

15+75

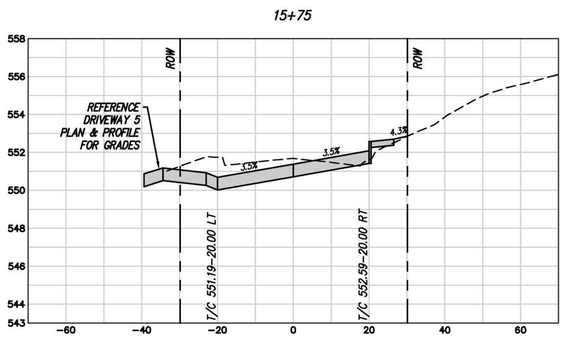

no.	revision	by	date
1	UPDATED LEAD WALK LIMITS PER AS BUILTS	JB	09/27/19

teague nall and perkins, inc
825 Watters Creek Blvd., Suite M300
Allen, Texas 75013
214.461.9867 ph 214.461.9864 fx
www.tnpinc.com
TBPE: F-230; TBPLS: 10011600, 10011601, 10194381

City of Rockwall
The New Horizon

scale
when bar is 1 inch long
horiz 1" = 20'
vert 1" = 4'
SEP 2019

tnp

RECORD DOCUMENTS

THESE PLANS ARE FOR THE OWNER'S USE AS RECORD SET OF THE CONSTRUCTED PROJECT, AND REFLECT REVISIONS AND CONSTRUCTION RELATED CHANGES AS RECORDED BY THE CONTRACTOR. CHANGES MADE FROM THE ORIGINAL CONSTRUCTION DOCUMENTS DO NOT DEPICT ENGINEERING AND ARE NOT THE RESPONSIBILITY OF TEAGUE NALL & PERKINS, INC. OR THE ENGINEER OF RECORD ON THE ORIGINAL DOCUMENTS. ORIGINAL PLANS RELEASED FOR CONSTRUCTION WERE SEALED BY GYANENDRA POKHREL, P.E. NO. 118159 ON 09/28/2018.

CITY OF ROCKWALL, TEXAS

HIGHLAND DRIVE RECONSTRUCTION, PHASE I

(DRIFTWOOD STREET TO BEDFORD FALLS LANE)

CROSS SECTIONS 2 OF 4

tnp project
RWL18219
sheet
52

Drawing: P:\PROJECTS\RWL18219\CAD\Sheets\PHASE 1 – NORTH\56 CROSS SECTIONS 4 OF 4.dwg at Oct 03, 2019–2:13pm by jbekolle
Layout: 54 CROSS SECTIONS 2 OF 4 Xrefs: xref–border.dwg – x3d–base.dwg – x3d–sewer.dwg – x3d–water.dwg – X3D–PAVING SW CHANGES.dwg – X3D–SCHOOL SITE.dwg