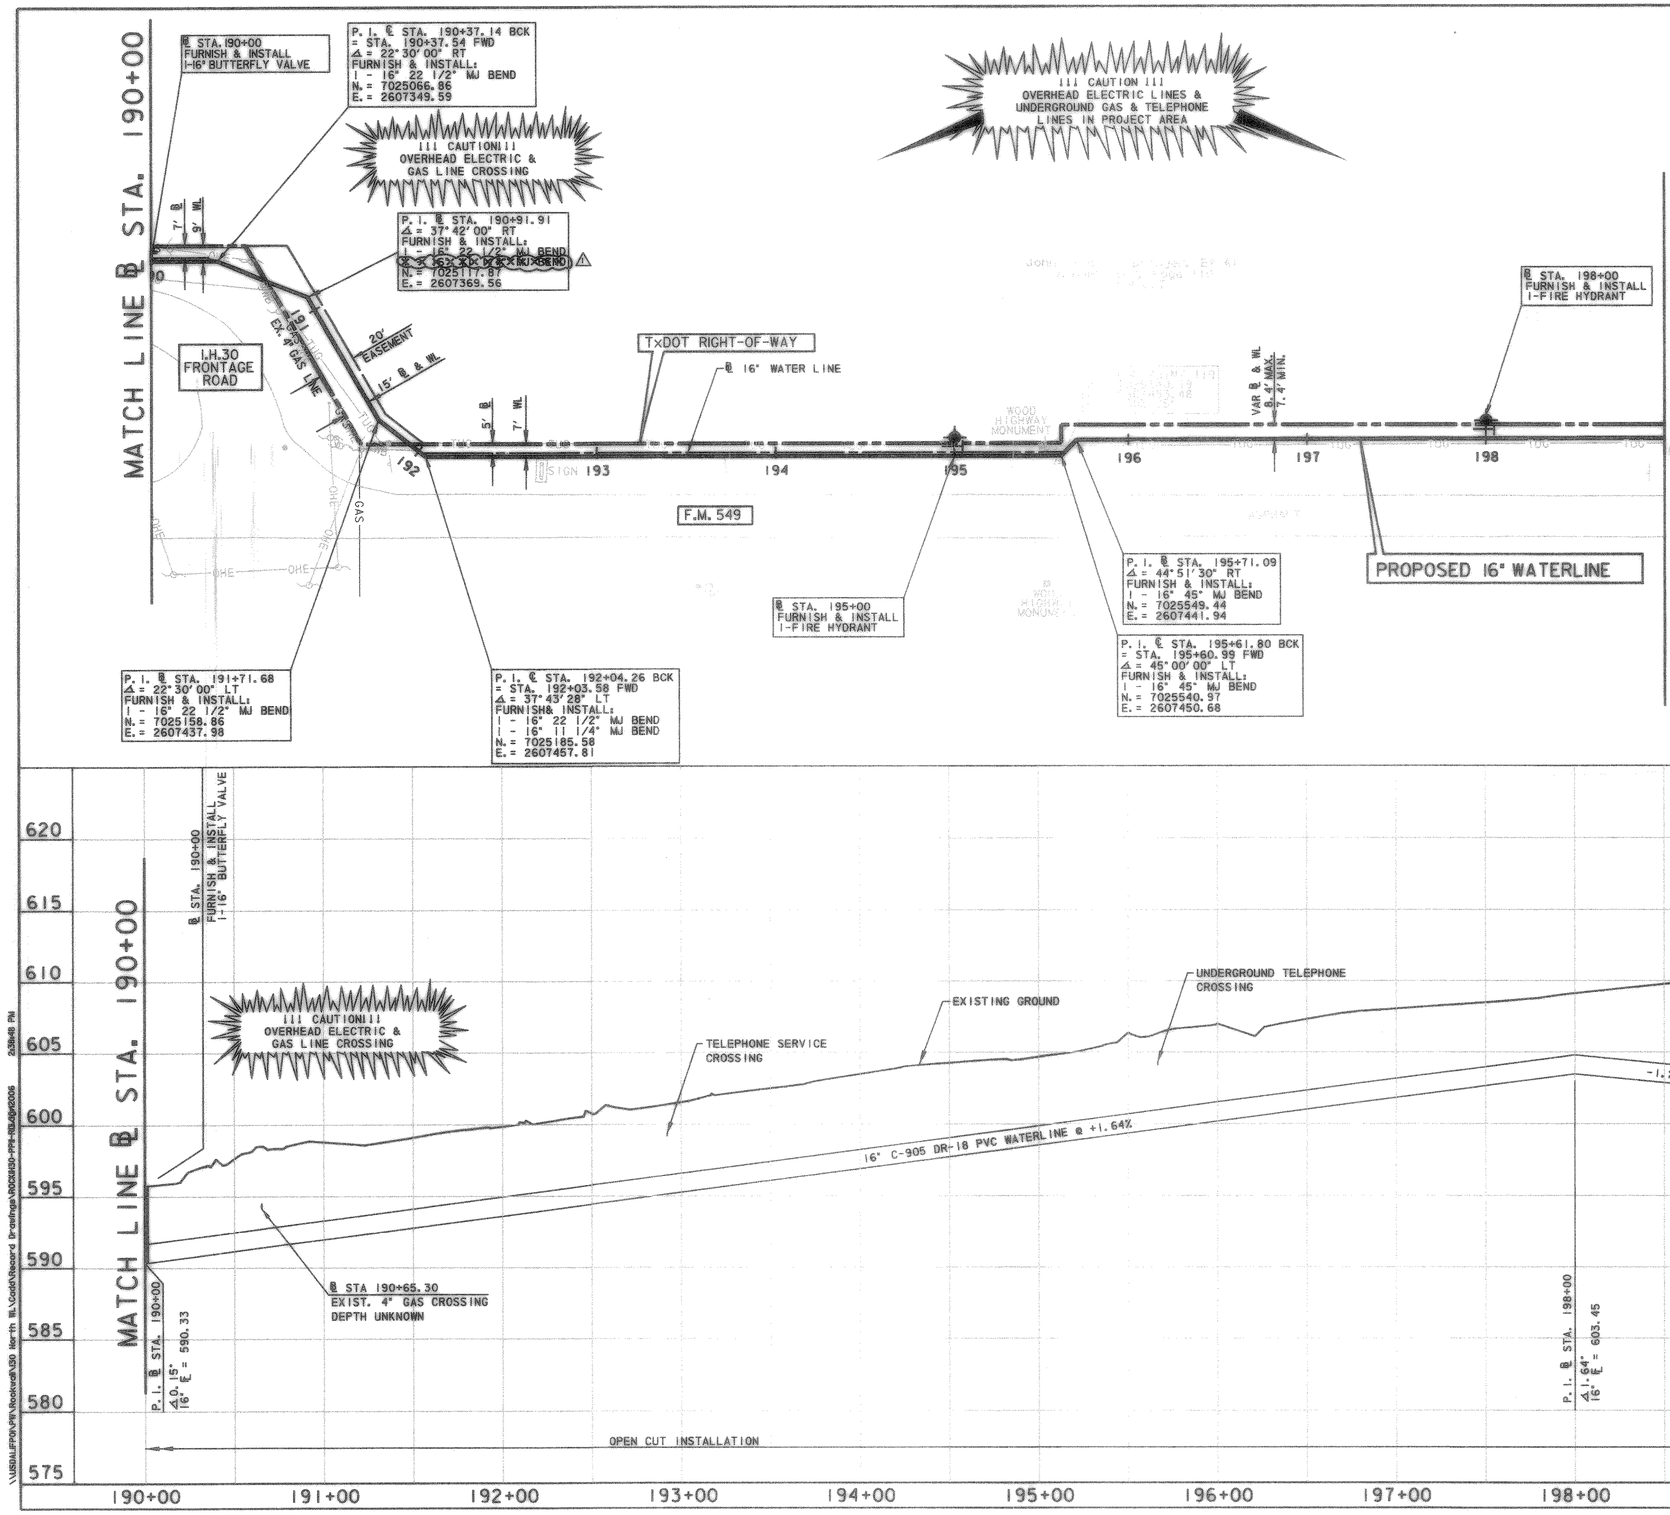

4		
3		
2		
1	03-09-06	RECORD DRAWING
NO.	DATE	REVISION APPRV.

CITY OF ROCKWALL
"THE NEW HORIZON"

IH-30 NORTH AND FM 549
WATER LINE - PHASE TWO

℄ STA. 190+00 TO ℄ STA. 199+00

TCB Turner Collie & Braden Inc.
Engineers • Planners • Project Managers

Unit	A123	Scale	Horiz. 1"=40' Vert. 1"=8'	Date	SEPTEMBER 2004
Designed	GC	Checked	TBS	Job No.	052131875.0001
Drawn	GBA	Approved	RCR	Sheet	15 of 25

\\USRALLEFP01\PW\Projects\430 North 78\Cadd\Record Drawings\ROCK430-PP1-RD.dgn 2/28/06 2:38:48 PM