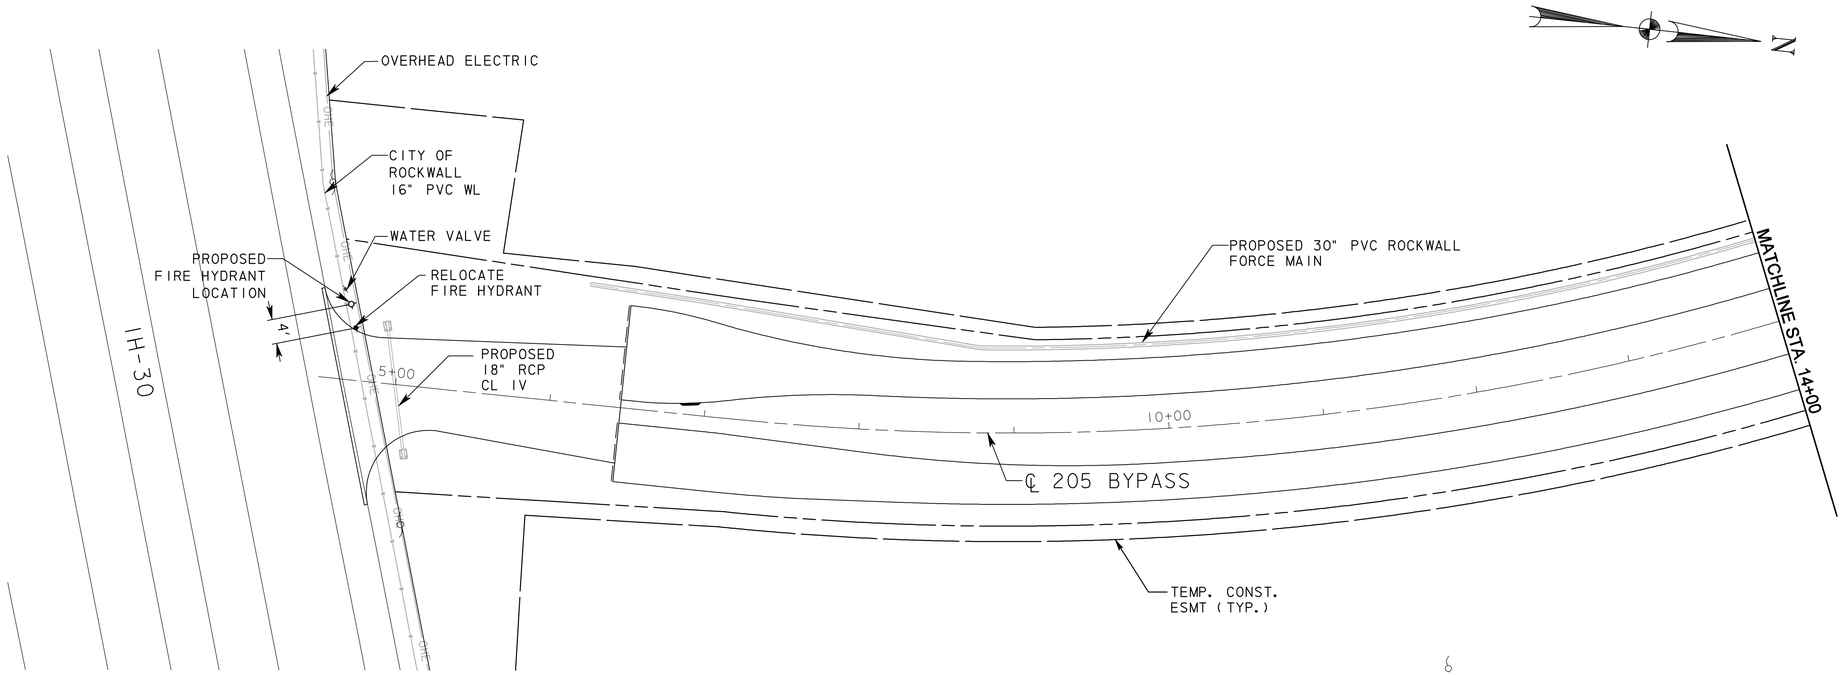

50 0 50 100
SCALE IN FEET

LEGEND

PROPOSED ROW

DRAINAGE EASEMENT

TEMP CONSTRUCTION EASEMENT

NOTES:

1. SEE ROADWAY PLAN AND PROFLIE SHEETS AND DRAINAGE PROFILE SHEETS FOR DETAILS OF CROSSING OVER THE 12" SANITARY SEWER LINE.

2. SEE ROADWAY PLAN AND PROFILE SHEETS FOR DETAILS OF CROSSING OVER THE CITY OF ROCKWALL 16" PVC WATER LINE.

UNDERGROUND UTILITIES

THE LOCATION OF EXISTING UTILITIES SHOWN ON THESE PLANS ARE APPROXIMATE AND BASED UPON DATA FURNISHED BY THE CITY OF ROCKWALL AND OTHER UTILITY OWNERS. IT IS THE RESPONSIBILITY OF THE CONTRACTOR TO LOCATE AND VERIFY ON-SITE THE UTILITIES THAT MAY CONFLICT WITH THE CONSTRUCTION.

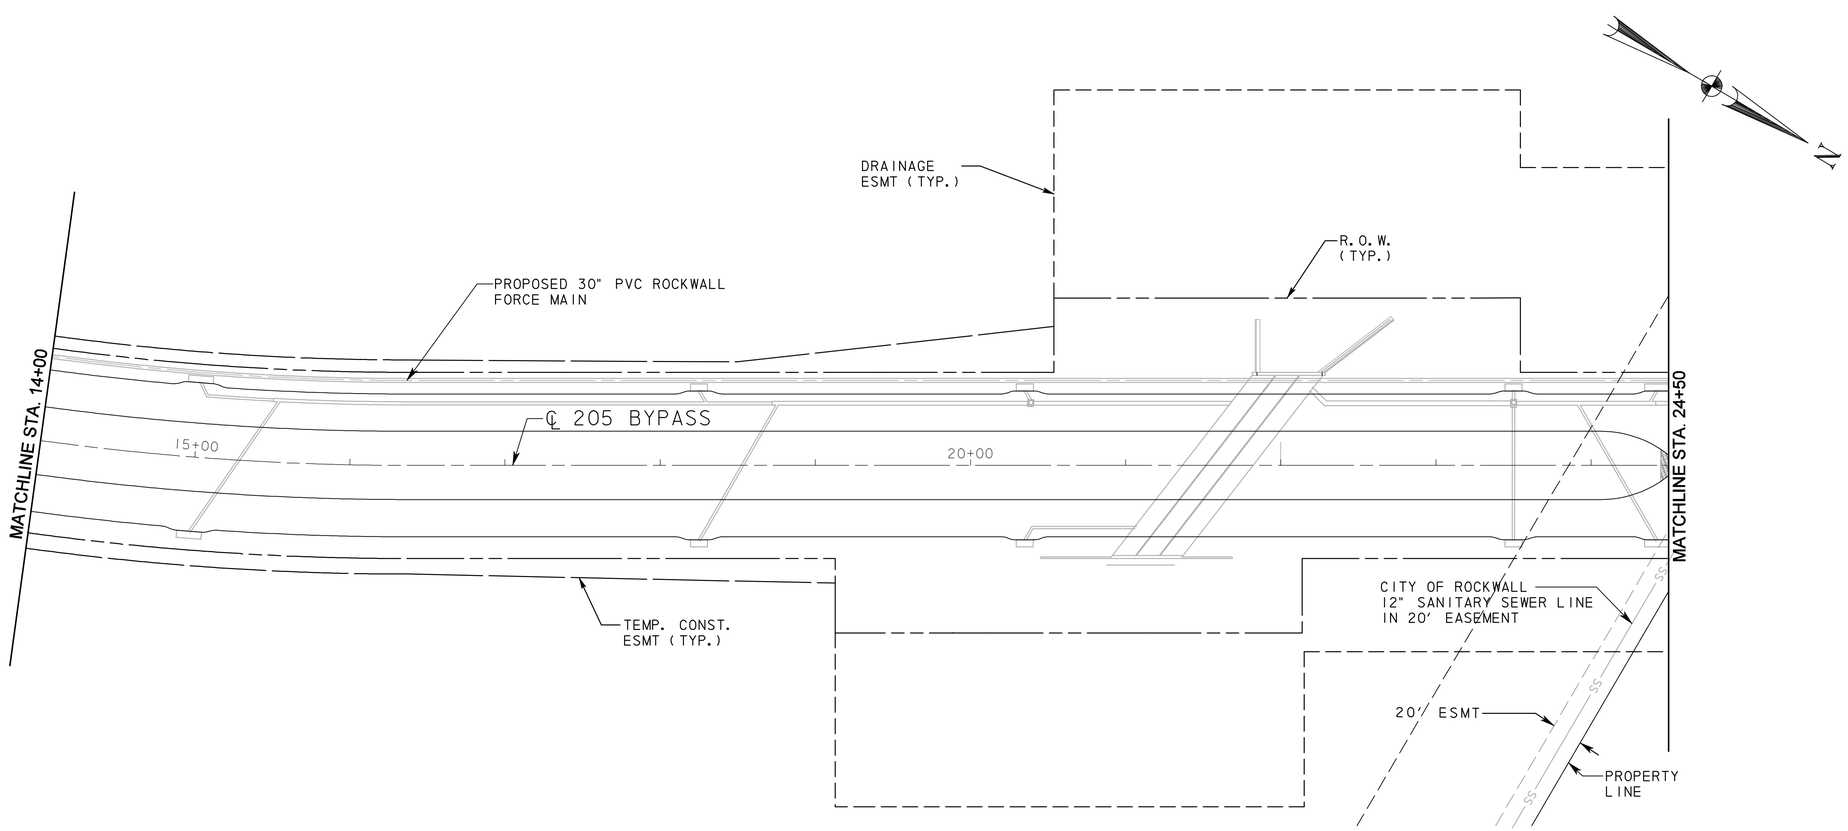

RECORD DRAWING

This drawing is a compilation of the original sealed engineering drawing and modifications by addenda, change orders and information furnished by the contractor. Information shown that was provided by the contractor and others not associated with the design engineer cannot be verified for accuracy or completeness. Original sealed drawing is on file at the office of AECOM USA Group, Inc., TBPE REG. NO. F-3082

ORIGINAL DRAWING SEALED & SIGNED BY

T.H. Gaertner, P.E.

TX NO. 37124

NO.	REVISION	BY	DATE

City of Rockwall, Texas

205 BYPASS
PHASE 3

UTILITIES LAYOUT
STA. 4+50 TO STA. 24+50

TCB | AECOM
TCB INC.
WWW.TCB.AECOM.COM
17300 DALLAS PARKWAY, SUITE 1010
DALLAS, TEXAS 75248

Unit	PW-DAL-FW	Scale:	Horz: AS SHOWN Vert: AS SHOWN	Date	11/23/2009
Designed	THG	Checked	TCB	Project No.	60004153
Drawn	FG	Approved	TCB	Sheet	101 of 215

\\usdallfp001\pw\4328\60004153-205bypass\cadd\sheets\phase 3 - I 30 to station sh 66\record drawing 10_7_09\01Utilities-01.dgn
11/23/2009