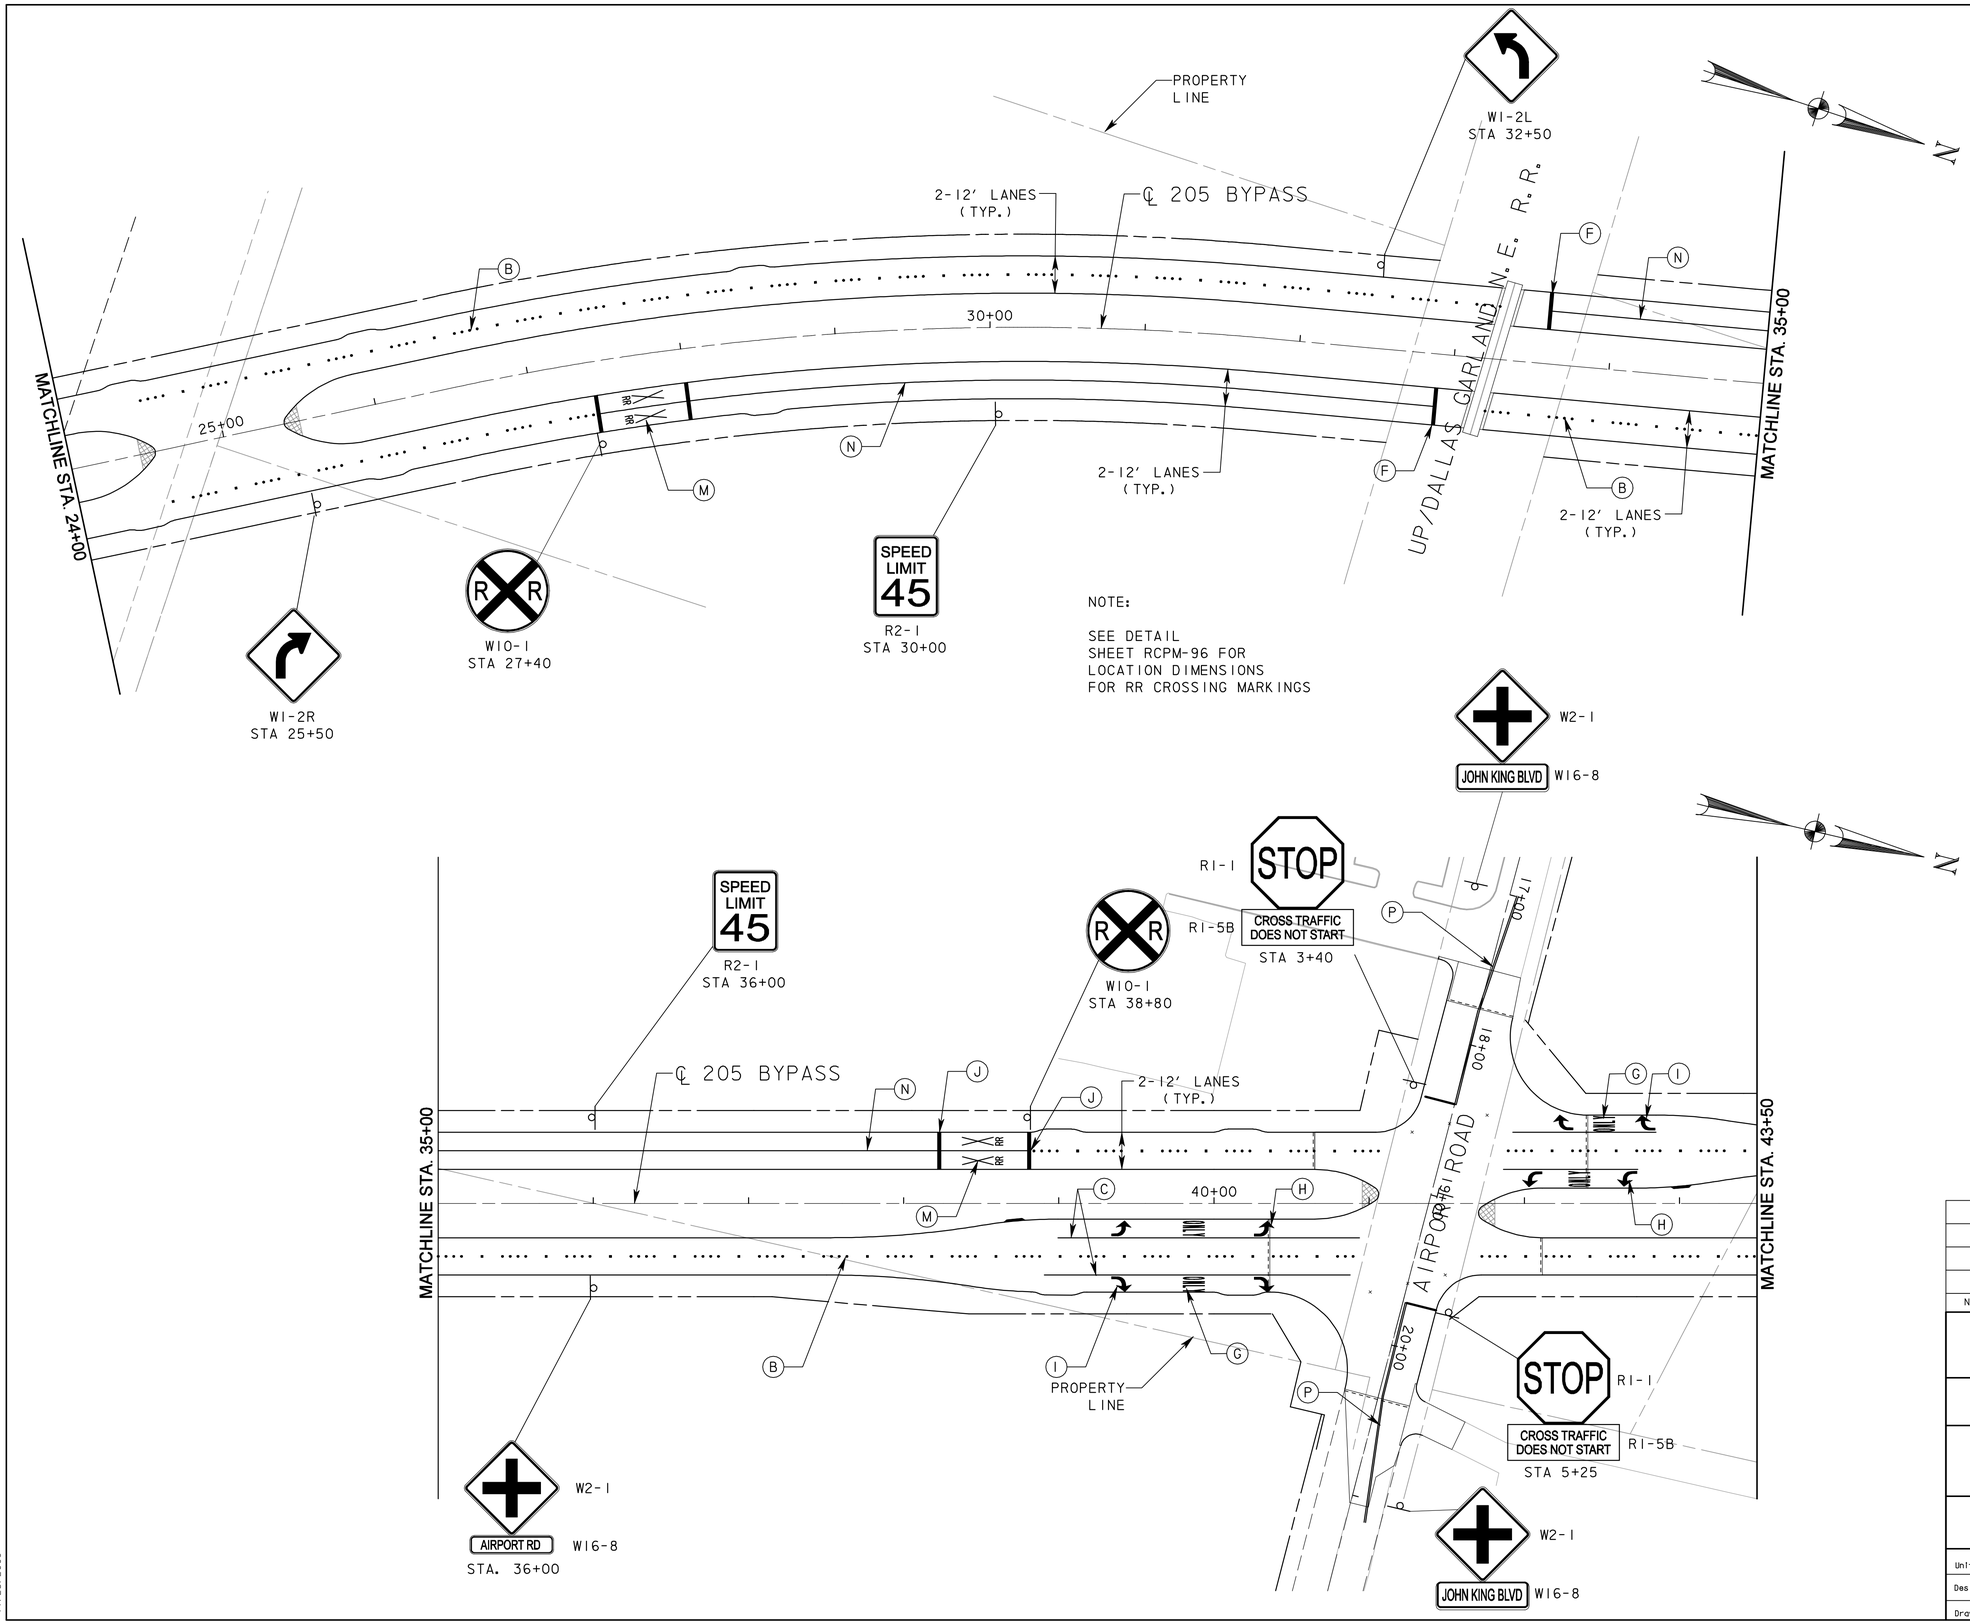

50 0 50 100
SCALE IN FEET

LEGEND

- (A) 4" WHITE SOLID
- (B) WHITE BUTTON TYPE LANE LINE SEE MISC. ROADWAY DETAIL SHEET 2 OF 2 FOR MORE INFORMATION.
- (C) WHITE BUTTON TURN BAY LINE. SEE MISC. ROADWAY DETAIL SHEET 2 OF 2 FOR MORE INFORMATION.
- (D) 4" YELLOW SOLID
- (E) 4" DOUBLE YELLOW SOLID
- (F) 24" WHITE STOP BAR
- (G) "ONLY" WHITE
- (H) WHITE LEFT TURN ARROW
- (I) WHITE RIGHT TURN ARROW
- (J) 12" WHITE SOLID
- (K) 12" YELLOW SOLID
- (L) WHITE ARROW
- (M) WHITE RR-CROSSING MARKINGS (SEE TXDOT DETAIL SHEET RCPM-96)
- (N) 8" WHITE SOLID
- (P) DOUBLE YELLOW BUTTON TYPE LINE. SEE MISC. ROADWAY DETAIL SHEET 2 OF 2 FOR MORE INFORMATION.

RECORD DRAWING

This drawing is a compilation of the original sealed engineering drawing and modifications by addenda, change orders and information furnished by the contractor. Information shown that was provided by the contractor and others not associated with the design engineer cannot be verified for accuracy or completeness. Original sealed drawing is on file at the office of AECOM USA Group, Inc., TBPE REG. NO. F-3082

ORIGINAL DRAWING SEALED & SIGNED BY
T.H. Gaertner, P.E.
TX NO. 37124

NO.	REVISION	BY	DATE

City of Rockwall, Texas

205 BYPASS
PHASE 3

PAVEMENT MARKINGS & SIGNING
STA. 24+00 TO STA. 43+50

TCB | AECOM
TCB INC.
WWW.TCB.AECOM.COM
17200 DALLAS PARKWAY, SUITE 1010
DALLAS, TEXAS 75248

Unit	PW-DAL-FW	Scale: Horz: AS SHOWN Vert: AS SHOWN		Date	11/23/2009
Designed	THG	Checked	TCB	Project No.	60004153
Drawn	FG	Approved	TCB	Sheet	118 of 215

\\usdallfp01\pw\4328\60004153-205bypass\cadd\sheets\phase 3 - 1 30 to station sh 66\record drawing 10_7_09\118PvmtMrk-02.dgn
11/23/2009