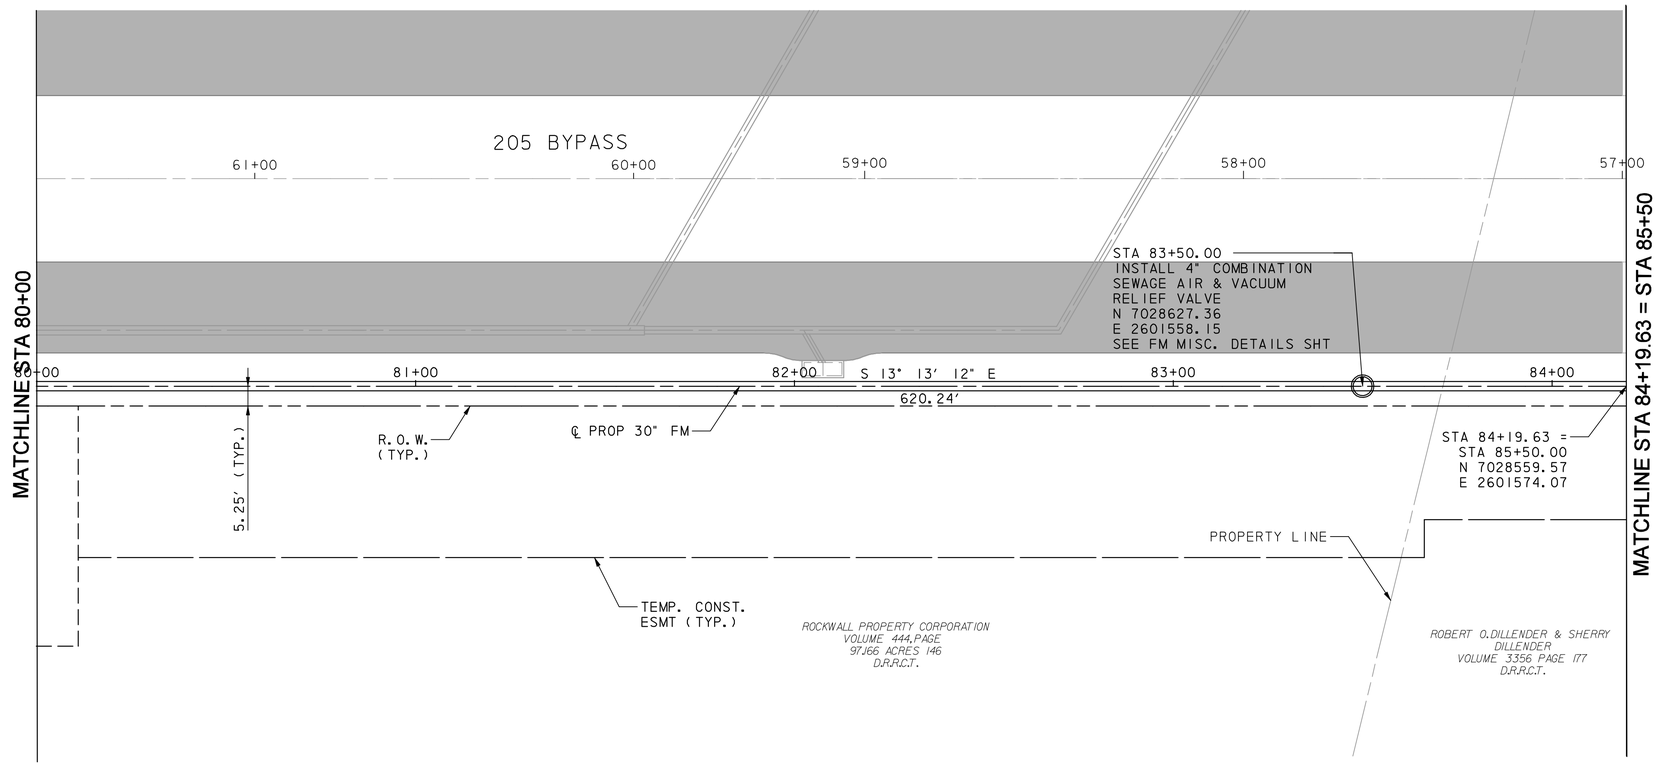

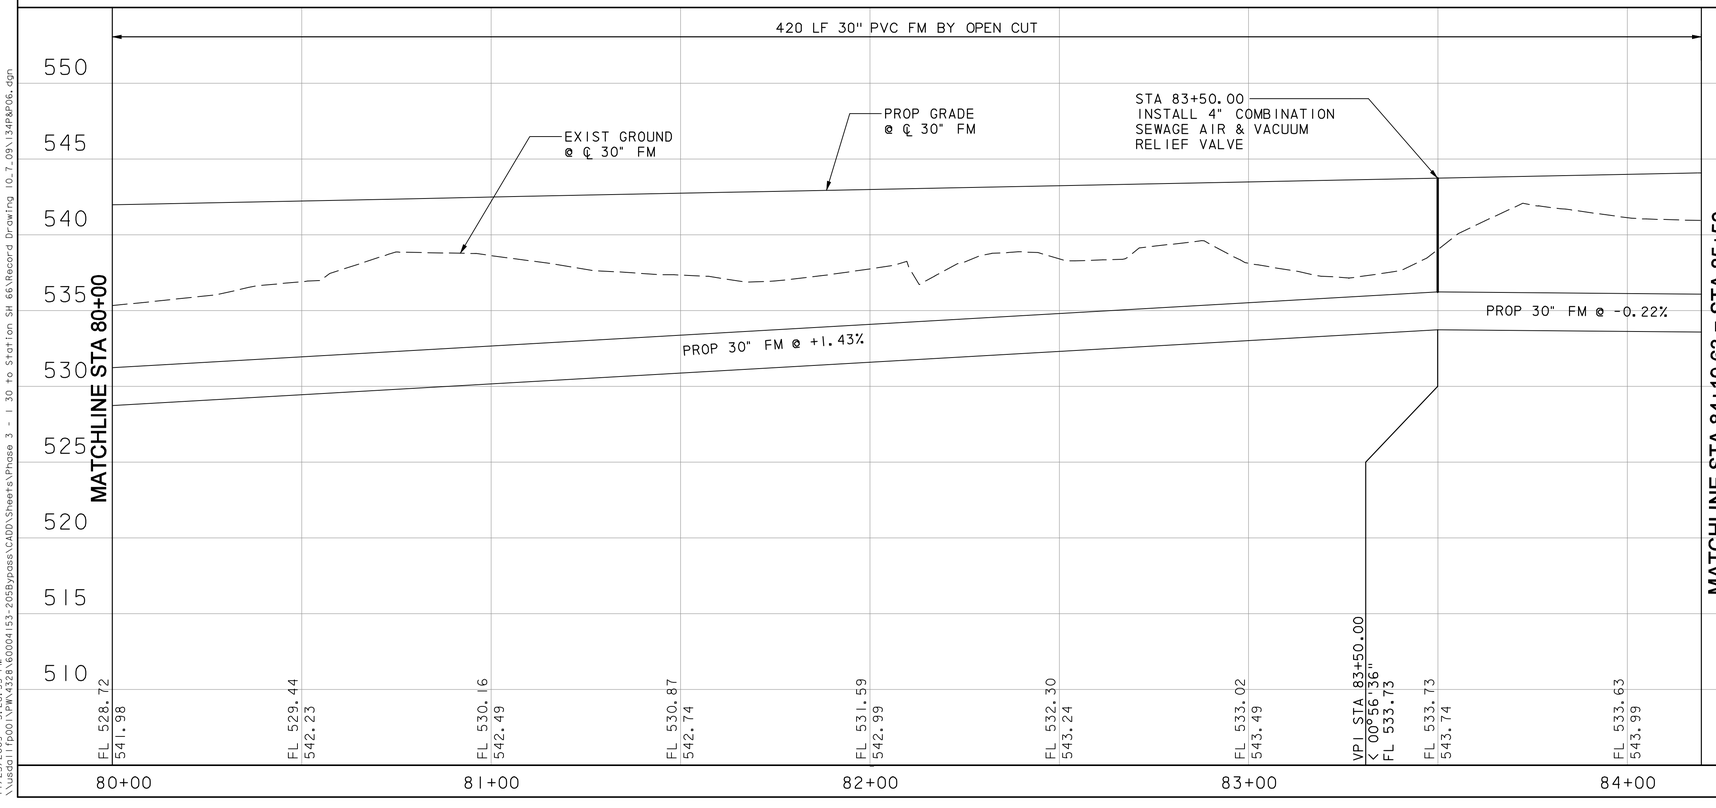

20 0 20 40
SCALE IN FEET
HORIZONTAL

5 0 5 10
SCALE IN FEET
VERTICAL

LEGEND

RIGHT-OF-WAY

DRAINAGE EASEMENT

TEMP. CONSTRUCTION EASEMENT

205 BYPASS PAVING

UNDERGROUND UTILITIES

THE LOCATION OF EXISTING UTILITIES SHOWN ON THESE PLANS ARE APPROXIMATE AND BASED ON DATA FURNISHED BY THE CITY OF ROCKWALL. IT IS THE RESPONSIBILITY OF THE CONTRACTOR TO LOCATE AND VERIFY ON-SITE THE UTILITIES THAT MAY CONFLICT WITH THE CONSTRUCTION.

RECORD DRAWING

This drawing is a compilation of the original sealed engineering drawing and modifications by addenda, change orders and information furnished by the contractor. Information shown that was provided by the contractor and others not associated with the design engineer cannot be verified for accuracy or completeness. Original sealed drawing is on file at the office of AECOM USA Group, Inc., TBPE REG. NO. F-3082

ORIGINAL DRAWING SEALED & SIGNED BY

Nicholas R. Batker, P.E.

TX NO. 92749

NO.	REVISION	BY	DATE

City of Rockwall, Texas

205 BYPASS
PHASE 3

30" FORCE MAIN
PLAN & PROFILE
STA 80+00 TO 84+19.63

6 OF 18

TCB | AECOM
TCB INC.
WWW.TCB.AECOM.COM
17300 DALLAS PARKWAY, SUITE 1010
DALLAS, TEXAS 75248

Unit	PW-DAL-FW	Scale: Horiz.	1:40	Date	11/23/2009
Designed	JLT/SDB	Vert.	1:10	Project No.	60023784
Drawn	TCB	Checked	NRB	Sheet	134 of 215
		Approved	NRB		

11/23/2009 3:28:55 PM
\\usdal1fp001\PW\4328\60004153-205Bypass\CADD\Sheets\Phase 3 - I 30 to Station Sht 66\Record Drawing 10_7_09\134P&P06.dgn