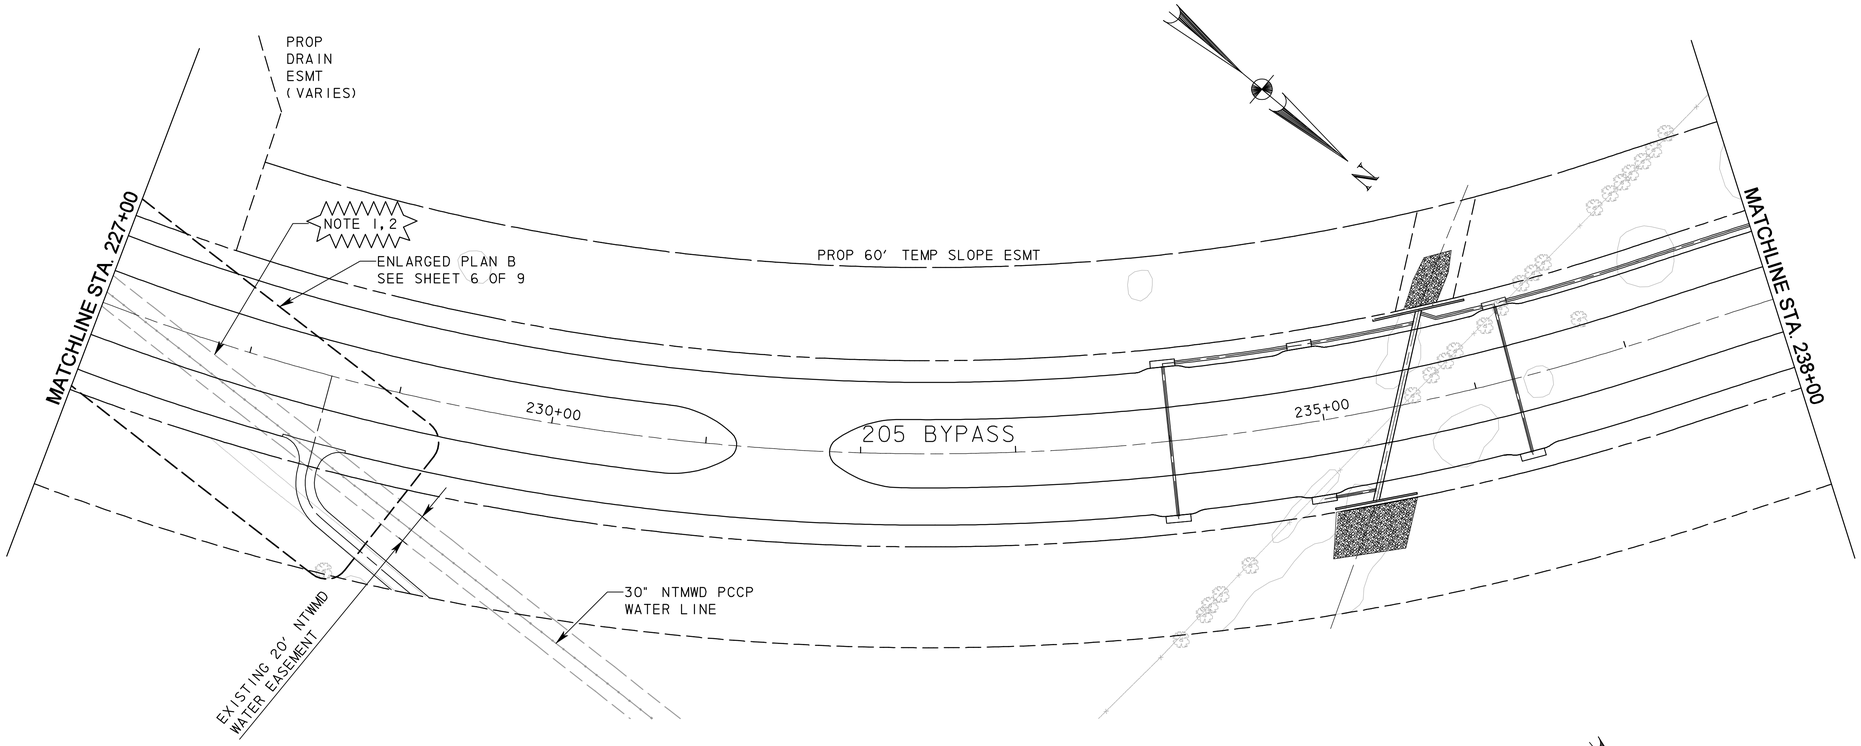

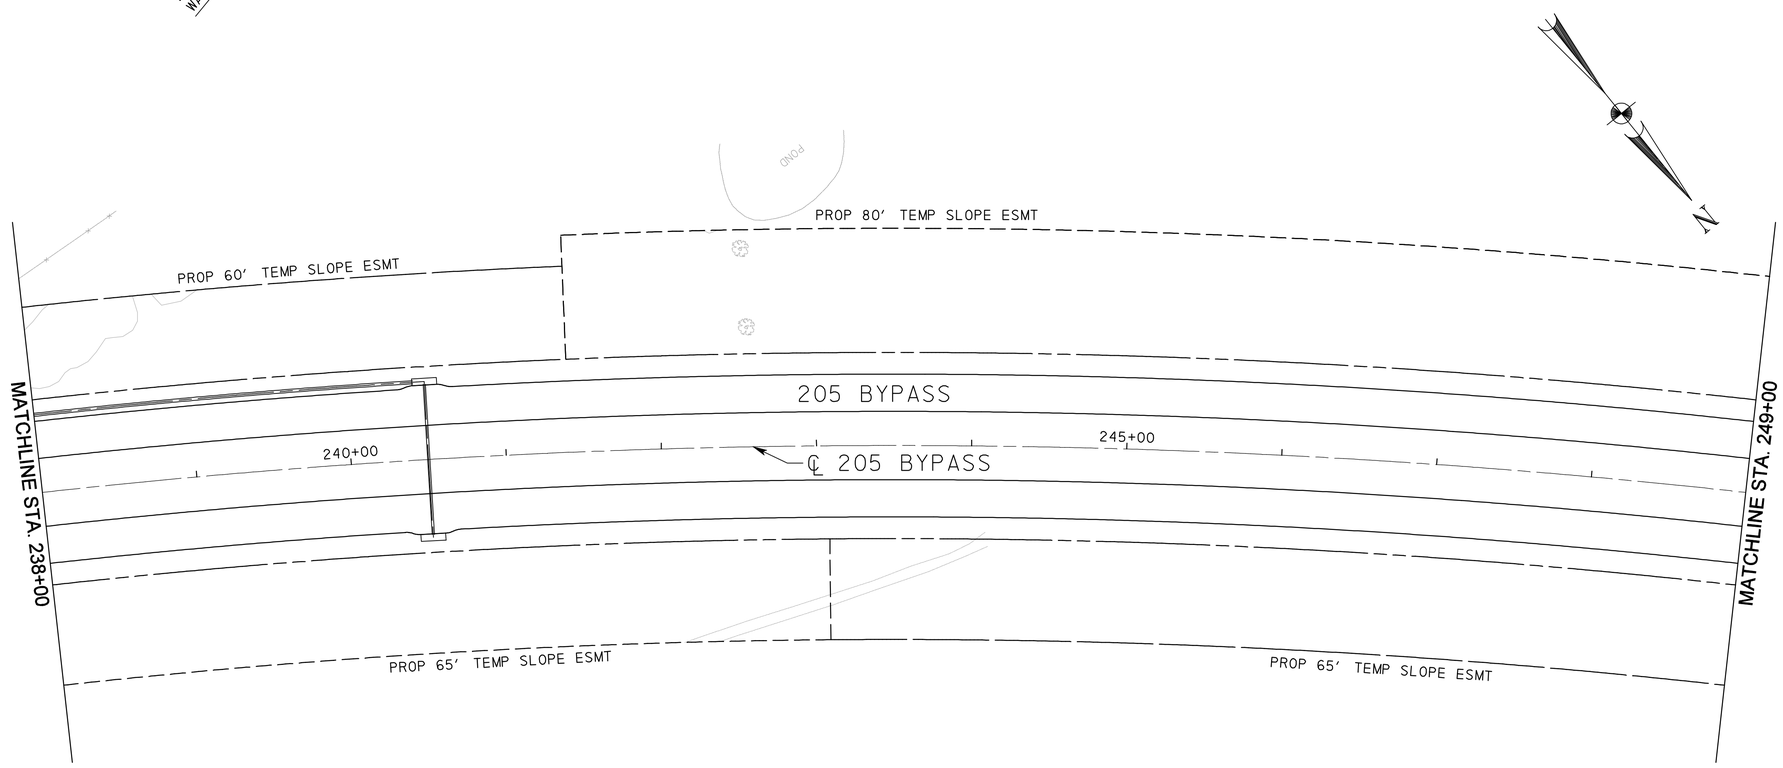

UNDERGROUND UTILITIES

THE LOCATION OF EXISTING UTILITIES SHOWN ON THESE PLANS ARE APPROXIMATE AND BASED ON DATA FURNISHED BY THE CITY OF ROCKWALL. IT IS THE RESPONSIBILITY OF THE CONTRACTOR TO LOCATE AND VERIFY ON-SITE THE UTILITIES THAT MAY CONFLICT WITH THE CONSTRUCTION.

50 0 50 100
SCALE IN FEET

LEGEND

PROPOSED ROW
DRAINAGE EASEMENT
TEMP SLOPE EASEMENT

UTILITY ADJUSTMENT NOTES:

1. MAINTAIN A MINIMUM OF 3.5 FT CLEARANCE BETWEEN TOP OF WATER PIPES AND SUBGRADE.
2. MAINTAIN A MINIMUM OF 1.0 FOOT VERTICAL CLEARANCE BETWEEN NTMWD AND DRAINAGE PIPING.

RECORD DRAWING

This drawing is a compilation of the original sealed engineering drawing and modifications by addenda, change orders and information furnished by the contractor. Information shown that was provided by the contractor and others not associated with the design engineer cannot be verified for accuracy or completeness. Original sealed drawing is on file at the office of AECOM USA Group, Inc., TBPE REG. NO. F-3082

ORIGINAL DRAWING SEALED & SIGNED BY
John W. Lacy, P.E.
TX NO. 90202

NO.	REVISION	BY	DATE

City of Rockwall, Texas

205 BYPASS
PHASE 6

UTILITIES LAYOUT

2 OF 9

TCB | AECOM
TCB INC.
WWW.TCB.AECOM.COM
17300 DALLAS PARKWAY, SUITE 1010
DALLAS, TEXAS 75248

Unit	PW-DAL-FW	Scale:	Horz: AS SHOWN Vert: AS SHOWN	Date	11/24/2009
Designed	SRR/SDB	Checked	TCB	Project No.	60004153
Drawn	FG	Approved	TCB	Sheet	107 of 216

p:\4328\60004153-205bypass\cadd\sheets\phase 6 - fm552 to 205\record drawing 10.7.09\107Existingutils-02.dgn
11/24/2009