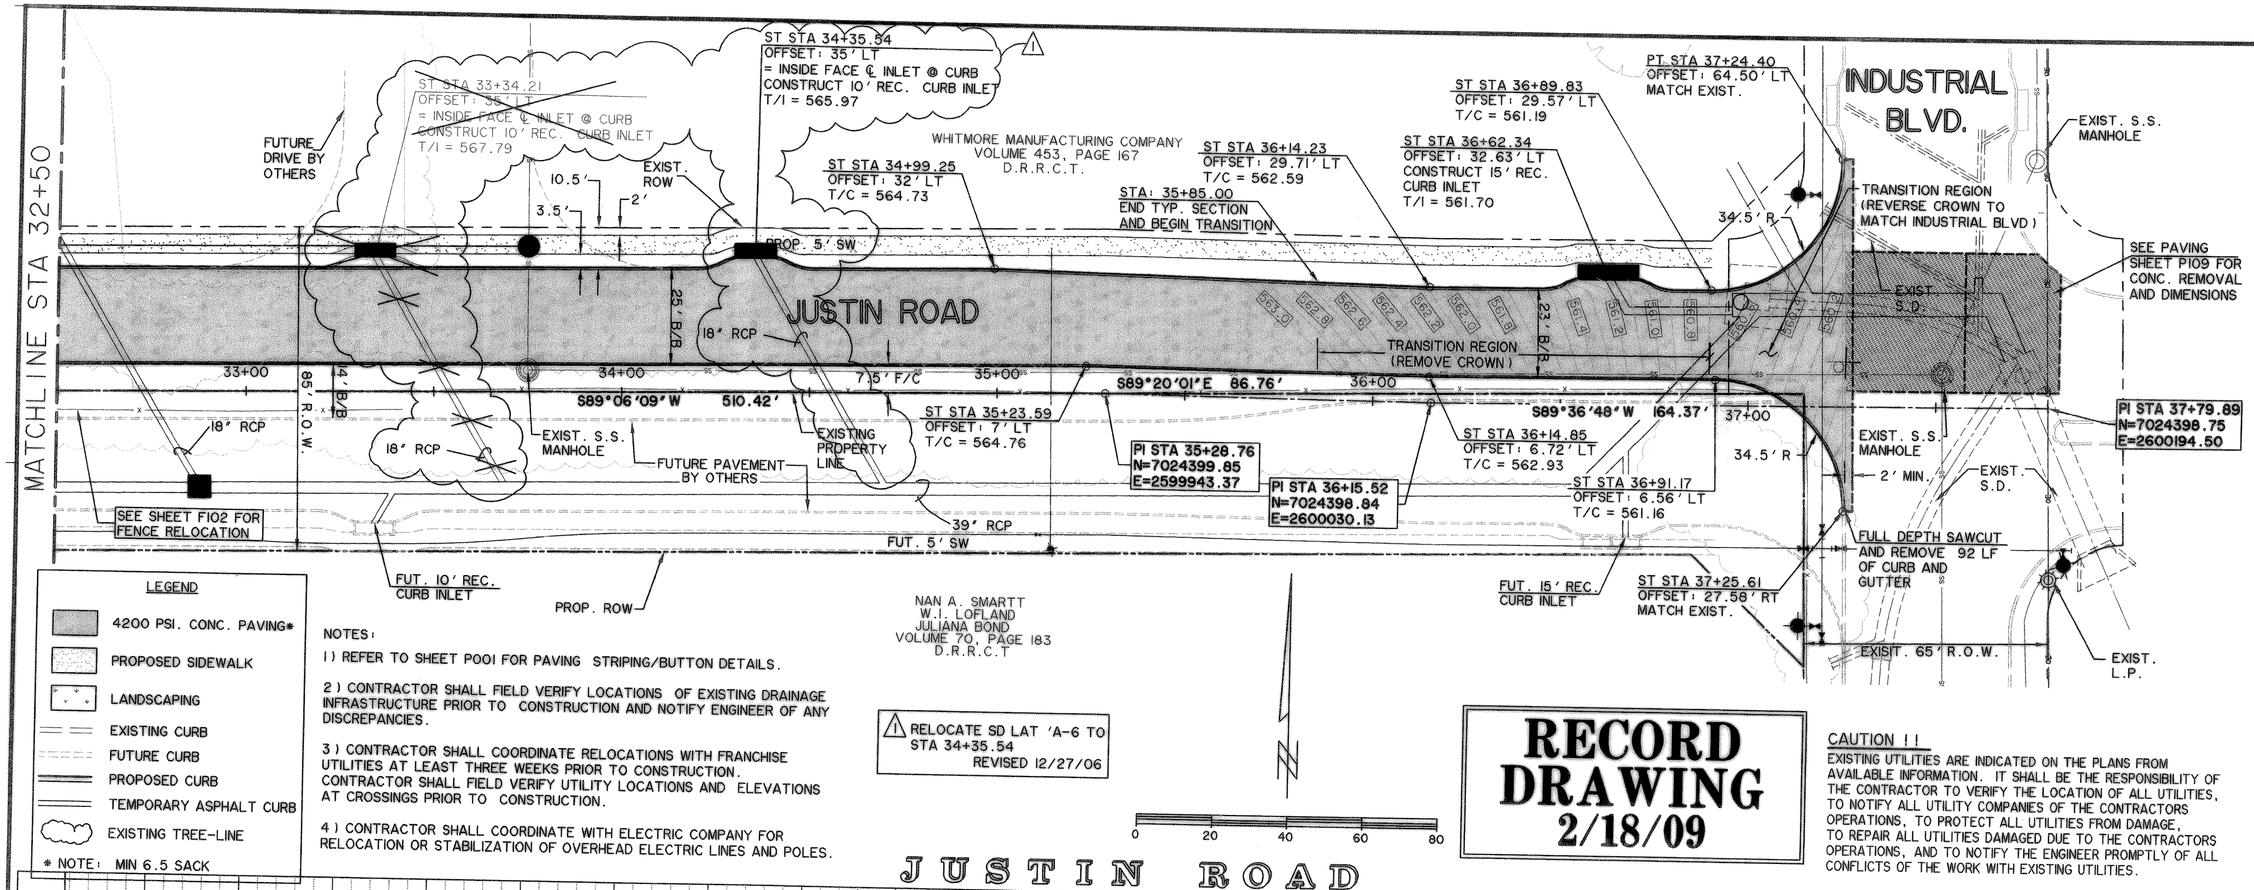

LEGEND

- 4200 PSI. CONC. PAVING*
- PROPOSED SIDEWALK
- LANDSCAPING
- EXISTING CURB
- FUTURE CURB
- PROPOSED CURB
- TEMPORARY ASPHALT CURB
- EXISTING TREE-LINE

* NOTE: MIN 6.5 SACK

NOTES:

1) REFER TO SHEET P001 FOR PAVING STRIPING/BUTTON DETAILS.

2) CONTRACTOR SHALL FIELD VERIFY LOCATIONS OF EXISTING DRAINAGE INFRASTRUCTURE PRIOR TO CONSTRUCTION AND NOTIFY ENGINEER OF ANY DISCREPANCIES.

3) CONTRACTOR SHALL COORDINATE RELOCATIONS WITH FRANCHISE UTILITIES AT LEAST THREE WEEKS PRIOR TO CONSTRUCTION. CONTRACTOR SHALL FIELD VERIFY UTILITY LOCATIONS AND ELEVATIONS AT CROSSINGS PRIOR TO CONSTRUCTION.

4) CONTRACTOR SHALL COORDINATE WITH ELECTRIC COMPANY FOR RELOCATION OR STABILIZATION OF OVERHEAD ELECTRIC LINES AND POLES.

1 RELOCATE SD LAT 'A-6 TO STA 34+35.54
REVISED 12/27/06

RECORD DRAWING 2/18/09

CAUTION !!

EXISTING UTILITIES ARE INDICATED ON THE PLANS FROM AVAILABLE INFORMATION. IT SHALL BE THE RESPONSIBILITY OF THE CONTRACTOR TO VERIFY THE LOCATION OF ALL UTILITIES, TO NOTIFY ALL UTILITY COMPANIES OF THE CONTRACTORS OPERATIONS, TO PROTECT ALL UTILITIES FROM DAMAGE, TO REPAIR ALL UTILITIES DAMAGED DUE TO THE CONTRACTORS OPERATIONS, AND TO NOTIFY THE ENGINEER PROMPTLY OF ALL CONFLICTS OF THE WORK WITH EXISTING UTILITIES.

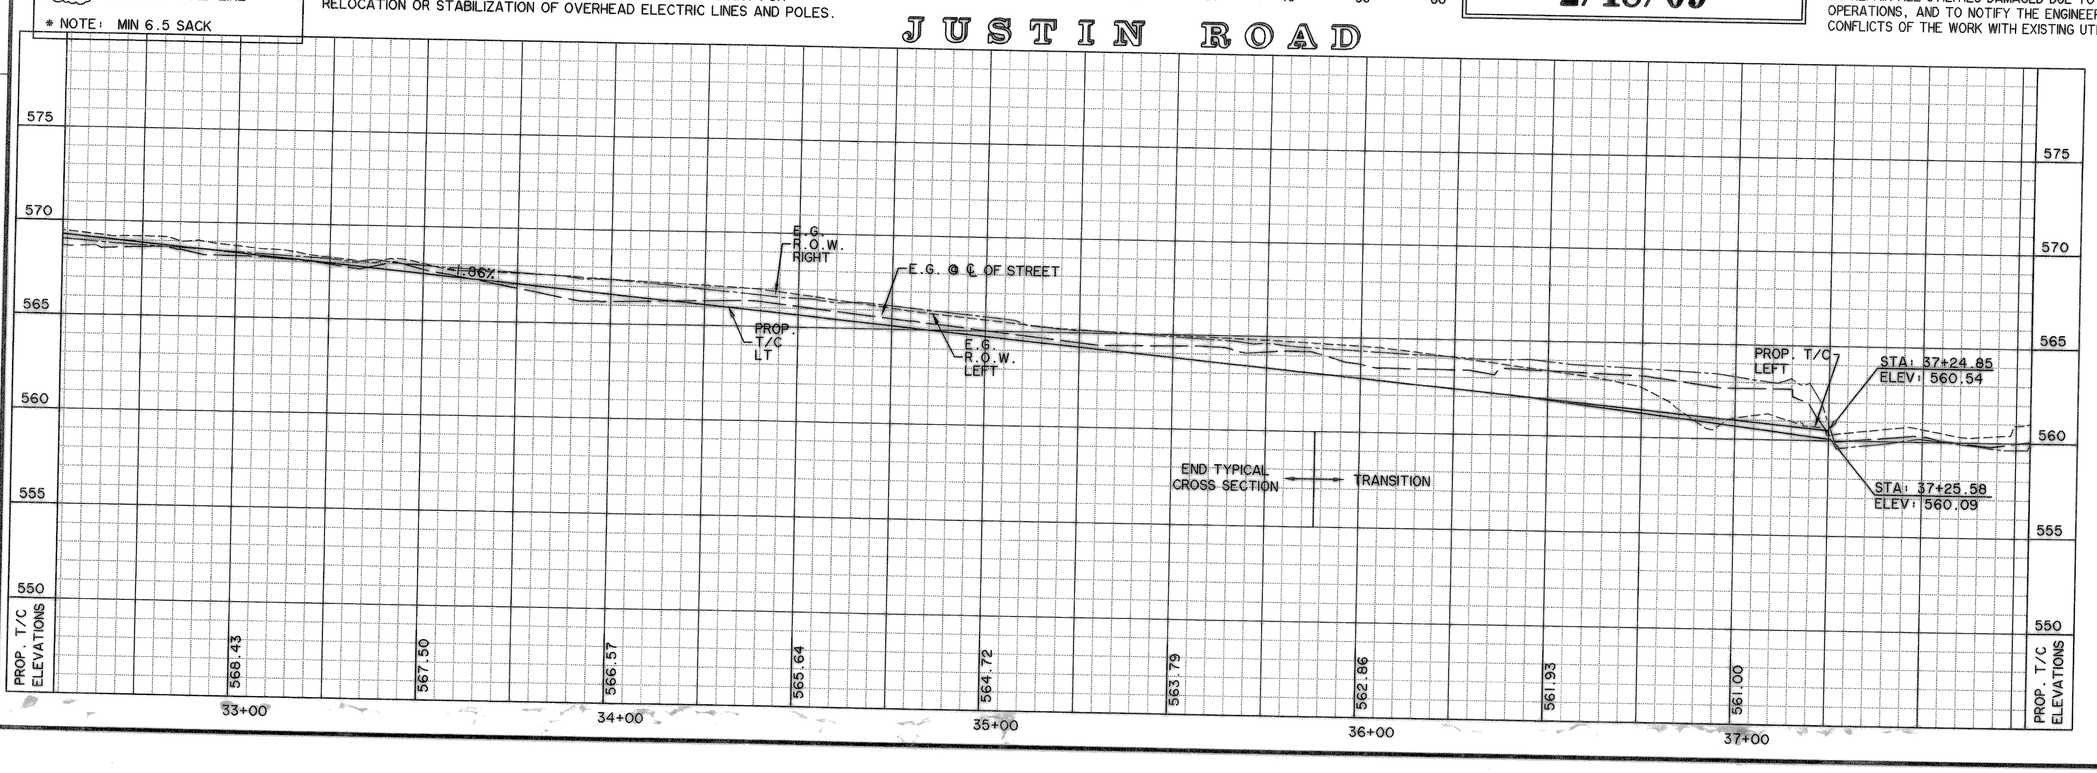

TIME:9:54 FILE:PAVE-8-04124.01.dwg

PREPARED BY:
WIER & ASSOCIATES, INC.
ENGINEERS SURVEYORS LAND PLANNERS
701 HIGHLANDER BLVD., SUITE 300 ARLINGTON, TEXAS 76015 METRO (817)467-7700
6849 ELM STREET FRISCO, TEXAS 75034 METRO (214)387-8000
www.wierassociates.com

CITY OF ROCKWALL
JUSTIN ROAD EXTENSION

PAVING PLAN AND PROFILE
STA 32+50 TO STA 37+79.89

STATE OF TEXAS
RONALD RAMIREZ
81821
REGISTERED PROFESSIONAL ENGINEER
2/18/09

COPYRIGHT © WIER & ASSOCIATES, INC.
LAST SHEET EDIT DATE 02-18-2009
WA# 04124.01

SHEET NO. P108