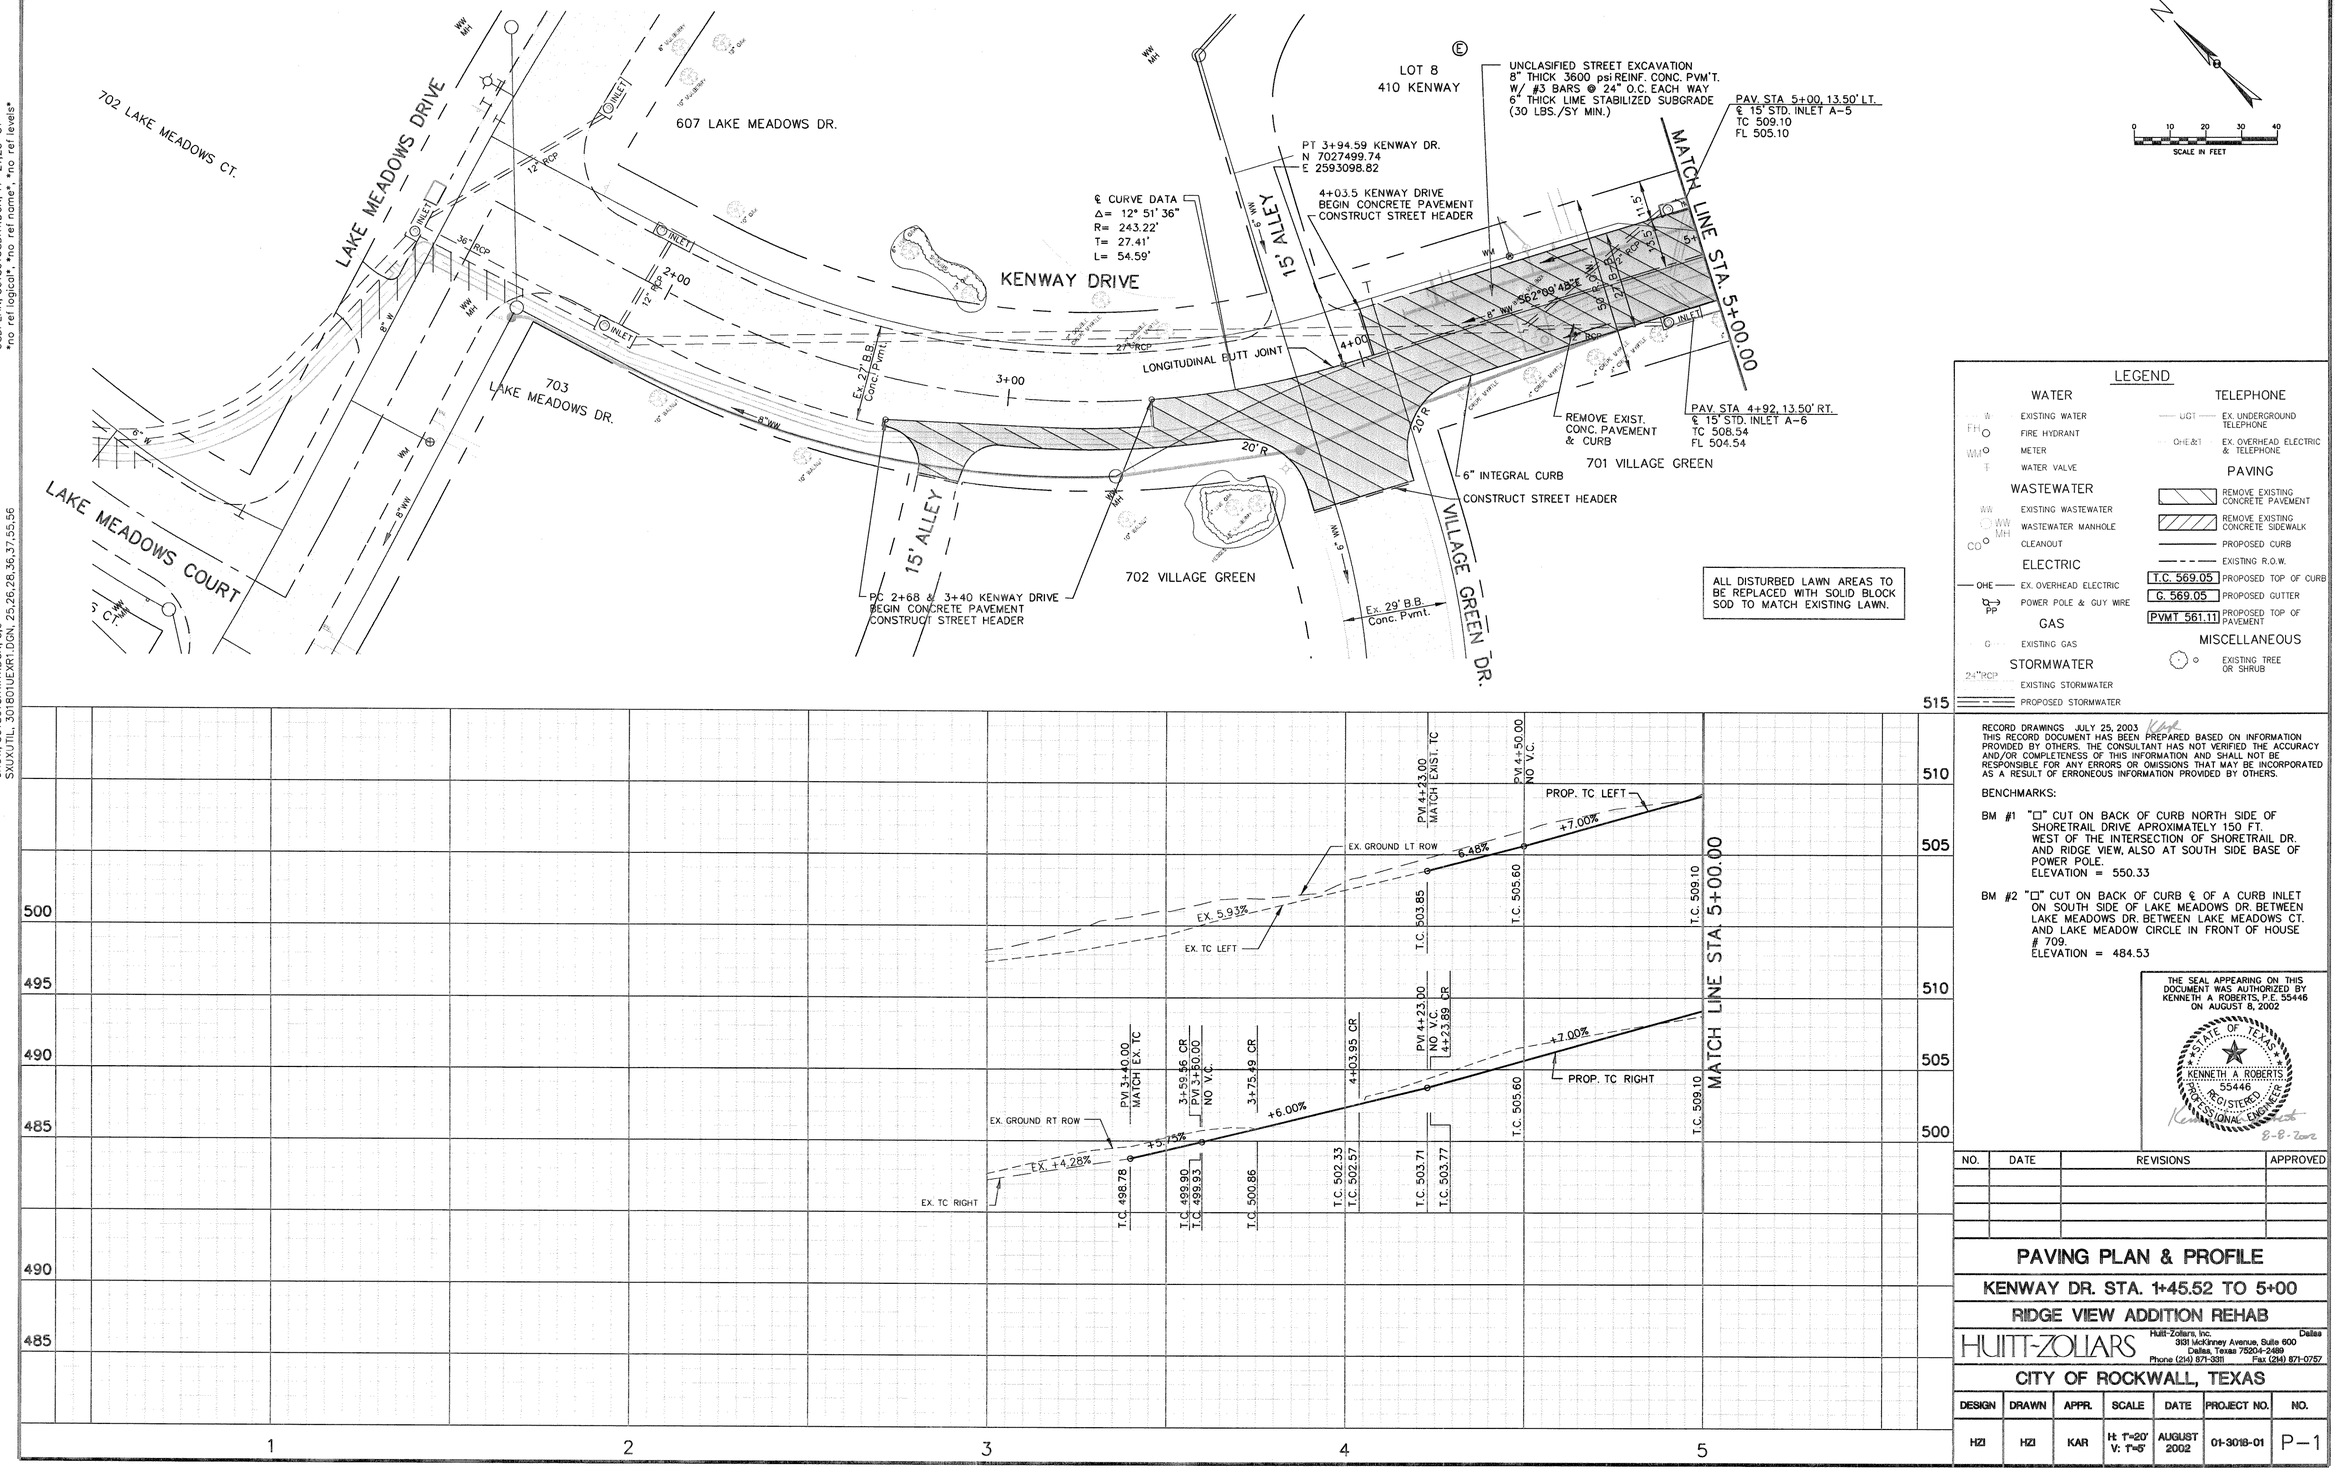


## LEGEND

**WATER**
- W — EXISTING WATER
- FH — FIRE HYDRANT
- WM — METER
- V — WATER VALVE

**WASTEWATER**
- WW — EXISTING WASTEWATER
- WW MH — WASTEWATER MANHOLE
- CO — CLEANOUT

**ELECTRIC**
- OHE — EX. OVERHEAD ELECTRIC
- PP — POWER POLE & GUY WIRE

**GAS**
- G — EXISTING GAS

**STORMWATER**
- 24"RCP — EXISTING STORMWATER
- PROPOSED STORMWATER

**TELEPHONE**
- UGT — EX. UNDERGROUND TELEPHONE
- OHE&T — EX. OVERHEAD ELECTRIC & TELEPHONE

**PAVING**
- REMOVE EXISTING CONCRETE PAVEMENT
- REMOVE EXISTING CONCRETE SIDEWALK
- PROPOSED CURB
- EXISTING R.O.W.
- T.C. 569.05 — PROPOSED TOP OF CURB
- G. 569.05 — PROPOSED GUTTER
- PVMT 561.11 — PROPOSED TOP OF PAVEMENT

**MISCELLANEOUS**
- EXISTING TREE OR SHRUB

RECORD DRAWINGS JULY 25, 2003 Kagh
THIS RECORD DOCUMENT HAS BEEN PREPARED BASED ON INFORMATION PROVIDED BY OTHERS. THE CONSULTANT HAS NOT VERIFIED THE ACCURACY AND/OR COMPLETENESS OF THIS INFORMATION AND SHALL NOT BE RESPONSIBLE FOR ANY ERRORS OR OMISSIONS THAT MAY BE INCORPORATED AS A RESULT OF ERRONEOUS INFORMATION PROVIDED BY OTHERS.

BENCHMARKS:

BM #1 "□" CUT ON BACK OF CURB NORTH SIDE OF SHORETRAIL DRIVE APROXIMATELY 150 FT. WEST OF THE INTERSECTION OF SHORETRAIL DR. AND RIDGE VIEW, ALSO AT SOUTH SIDE BASE OF POWER POLE.
ELEVATION = 550.33

BM #2 "□" CUT ON BACK OF CURB ℄ OF A CURB INLET ON SOUTH SIDE OF LAKE MEADOWS DR. BETWEEN LAKE MEADOWS DR. BETWEEN LAKE MEADOWS CT. AND LAKE MEADOW CIRCLE IN FRONT OF HOUSE # 709.
ELEVATION = 484.53

THE SEAL APPEARING ON THIS DOCUMENT WAS AUTHORIZED BY KENNETH A ROBERTS, P.E. 55446 ON AUGUST 8, 2002

STATE OF TEXAS · KENNETH A ROBERTS · 55446 · REGISTERED · PROFESSIONAL ENGINEER
8-8-2002

| NO. | DATE | REVISIONS | APPROVED |
|---|---|---|---|
| | | | |
| | | | |
| | | | |
| | | | |

# PAVING PLAN & PROFILE

## KENWAY DR. STA. 1+45.52 TO 5+00

## RIDGE VIEW ADDITION REHAB


HUITT-ZOLLARS
Huitt-Zollars, Inc. Dallas
3131 McKinney Avenue, Suite 600
Dallas, Texas 75204-2489
Phone (214) 871-3311 Fax (214) 871-0757


## CITY OF ROCKWALL, TEXAS

| DESIGN | DRAWN | APPR. | SCALE | DATE | PROJECT NO. | NO. |
|---|---|---|---|---|---|---|
| HZI | HZI | KAR | H: 1"=20' V: 1"=5' | AUGUST 2002 | 01-3018-01 | P-1 |

h:\proj\01301801\dgn\301801CST09.DGN


BORDER, 301801GBDR1.DGN, 1-4,7,11,12,21,30,31,37,38,40,41,45-48,50
VFIELD, 301801VFTR1.DGN, 11,14,20,24,26,28,43,50,56,57,60
CHALIGN, 301801CHAR1.DGN, 1-3
CSTPLAN, 301801CSTR1.DGN, 20,28,31,35,41,46,57
CROW, 301801CRWR1.DGN, 5,6
SXJUTIL, 301801UEXR1.DGN, 25,26,28,36,37,55,56
UWTPLAN, 301801UWTR1.DGN, 17,18,20,21,48-54
USSPLAN, 301801USSR1.DGN, 17,18,20,21,35-38,40,41
CVALIGN, 301801CVAR1.DGN, 3,6,23,27-29,31,32
CVALIGNR, 301801CVAR1.DGN, 4,6,23,27-29,31,32
USPLAN, 301801USDR1.DGN, 17-21,23-31
*no ref logical*, *no ref name*, *no ref levels*
theressa
SCALE=20.000000
PRF ROTATION=-45.000000
F:\tbl\VH2IFULL.TBL
h:\proj\01301801\dgn\301801CST09.DGN
DATE: 7/29/03
TIME: 07:57:01