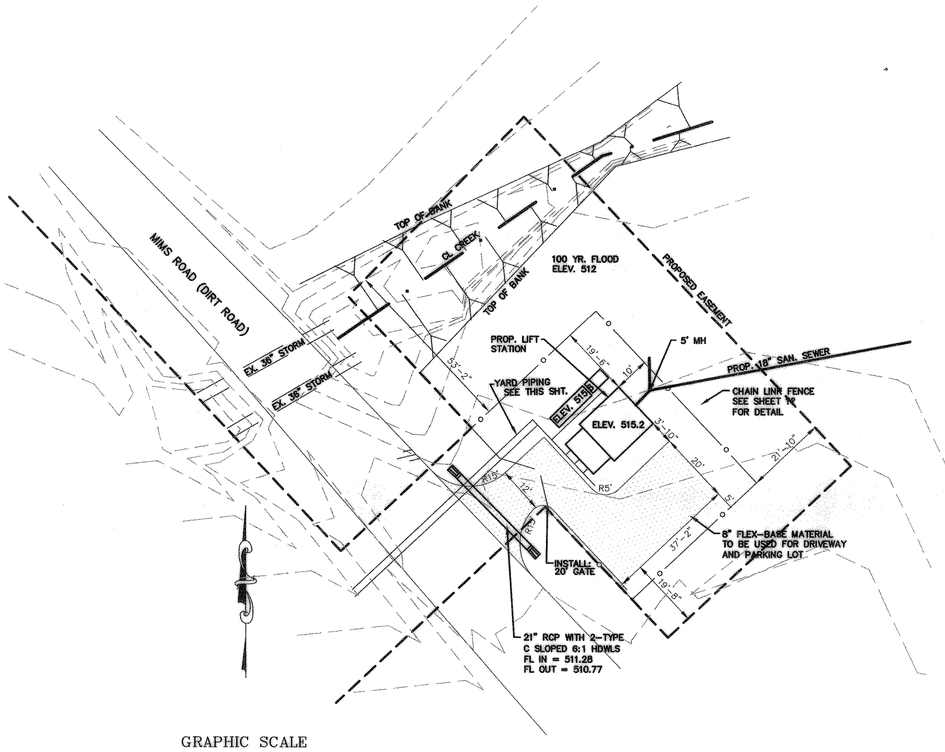

GRAPHIC SCALE

20 0 10 20 40 80

(IN FEET)
1 inch = 20 ft.

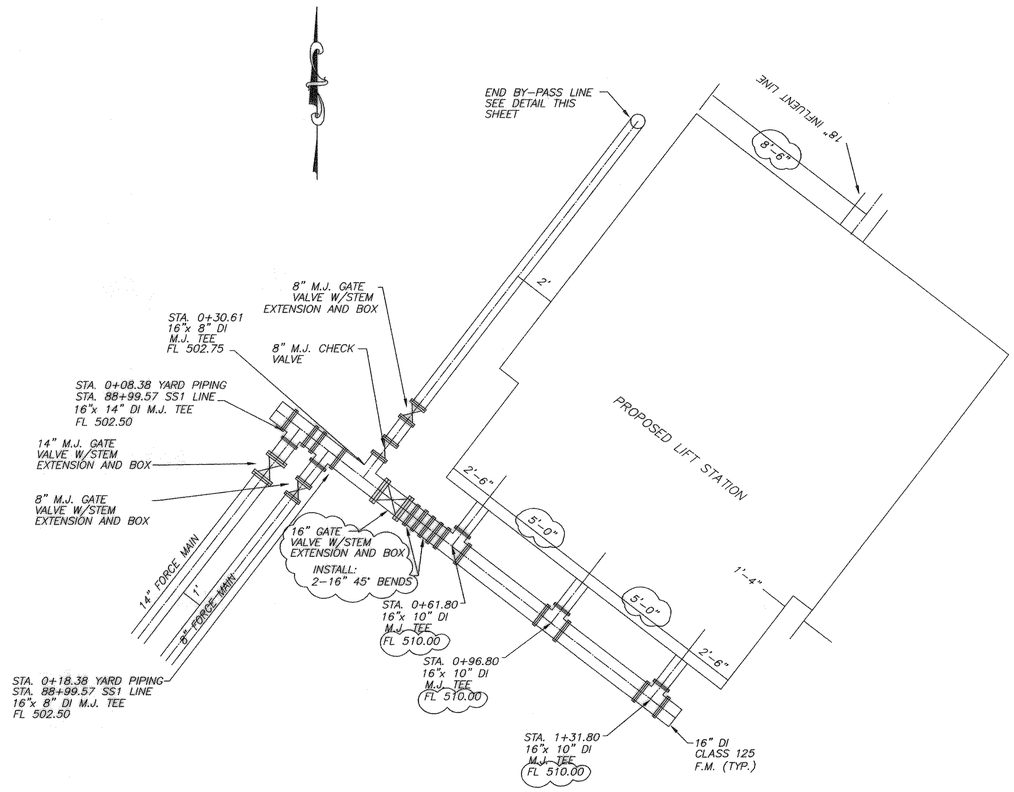

DISCHARGE PIPING LAYOUT

NTS

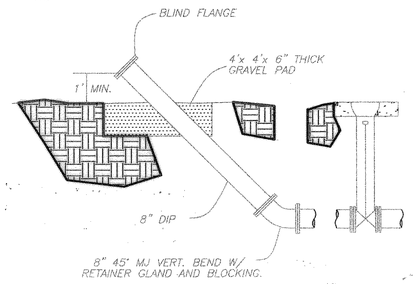

EMERGENCY BY-PASS DETAIL

N.T.S.

RECORD DRAWINGS:

THE INTENT OF THE OWNER AND ENGINEER WAS TO CONSTRUCT THESE FACILITIES ACCORDING TO THESE PLANS AS APPROVED BY THE CITY OF Rockwall. THE LINES AND GRADES WERE SET ON THE GROUND FOR CONSTRUCTION ACCORDING TO SAID PLANS. THE CITY OF Rockwall INSPECTED THE CONSTRUCTION. THE OWNER NOR ENGINEER DID NOT VERIFY LINES OR GRADES AFTER CONSTRUCTION. WE ARE NOT AWARE OF ANY CHANGES OR REVISIONS TO THESE PLANS DURING CONSTRUCTION EXCEPT AS NOTED

THE SEAL APPEARING ON THIS DOCUMENT WAS AUTHORIZED BY W.L. DOUPHRATE II TEXAS P.E. NO. 60102 ON 7/26/01

DOUPHRATE & ASSOCIATES, INC.
ENGINEERING • PROJECT MANAGEMENT • SURVEYING
2231 RIDGE RD., # 200 ROCKWALL, TEXAS 75087
PHONE: (972)771-9004 FAX: (972)771-9005

SITE AND YARD PIPING PLAN
MIMS ROAD REGIONAL
LIFT STATION
ROCKWALL, ROCKWALL COUNTY, TEXAS

5/19/2000 RAISED PART OF 16" FORCE MAIN TO FL 510.00 5/8/2000 WIDENED STATION REVISION	
W.L.D.	CHECKED
A.J.W.	DRAWN
11/3/99	DATE
9825LS1	PROJECT
16 OF 30	