NASHSHT2.DWG

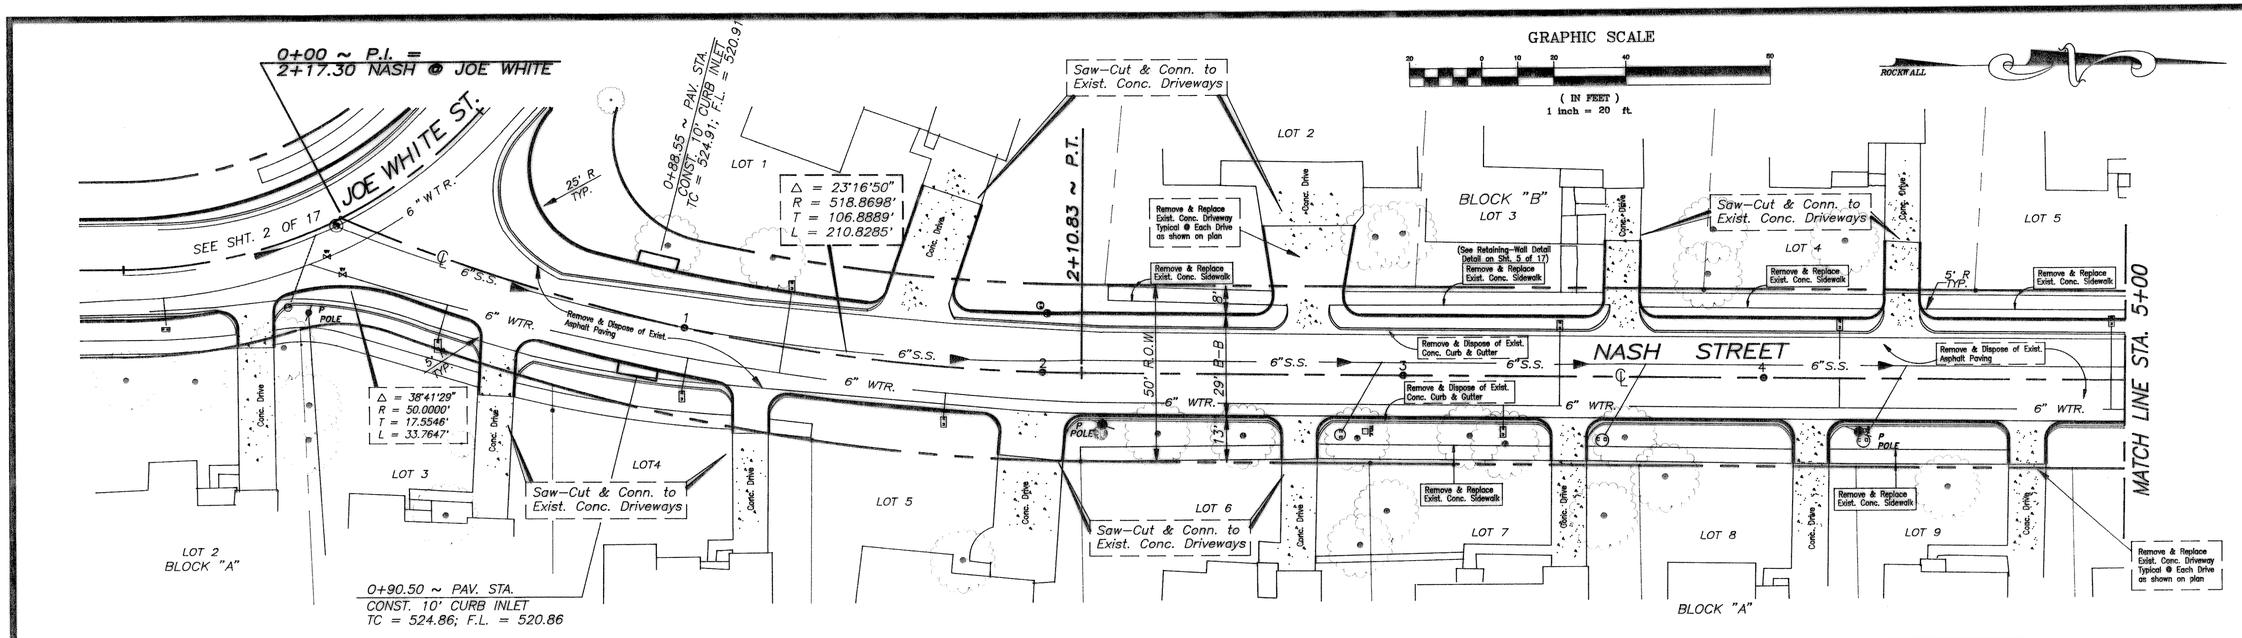

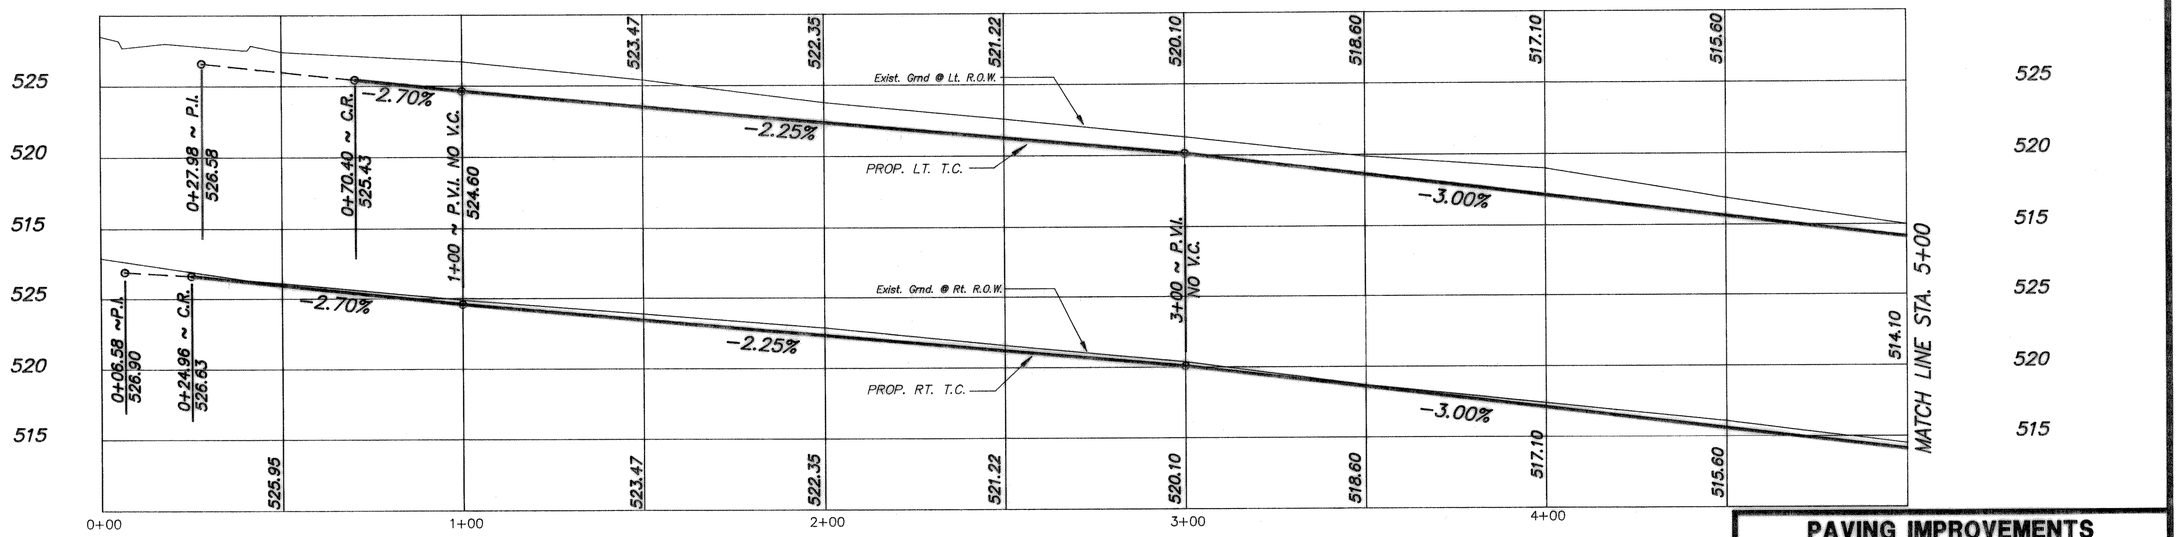

BENCHMARK NO. 4 :
R.R. SPIKE SET IN P/P @ EAST SIDE OF NASH STREET AT THE ℄ OF NASH & JOE WHITE INTERSECTION.
ELEV. = 529.32

BENCHMARK NO. 5 :
TOP OF OPERATING NUT @ N.E. CORNER OF NASH STREET & HEATH STREET, 40' N. OF HEATH STREET.
ELEV. = 536.72

REVISION NO.	REMARKS	DATE
1	Trees in wrong location. Moved to right location as shown on plan view.	8/7/92

PAVING IMPROVEMENTS
NASH STREET
ROCKWALL, TEXAS

CITY OF ROCKWALL
"THE NEW HORIZON"

DESIGNED: B.W.H.	THE SEAL APPEARING ON THIS DOCUMENT WAS AUTHORIZED BY W.L. DOUPHRATE II TEXAS P.E. NO. 60102 ON 8/24/92	
DRAWN: ACAD		
JOB NO.	DATE: 6/15/92	SHEET NO. 3 OF 17

STATE OF TEXAS — W.L. DOUPHRATE II — 60102 — REGISTERED PROFESSIONAL ENGINEER