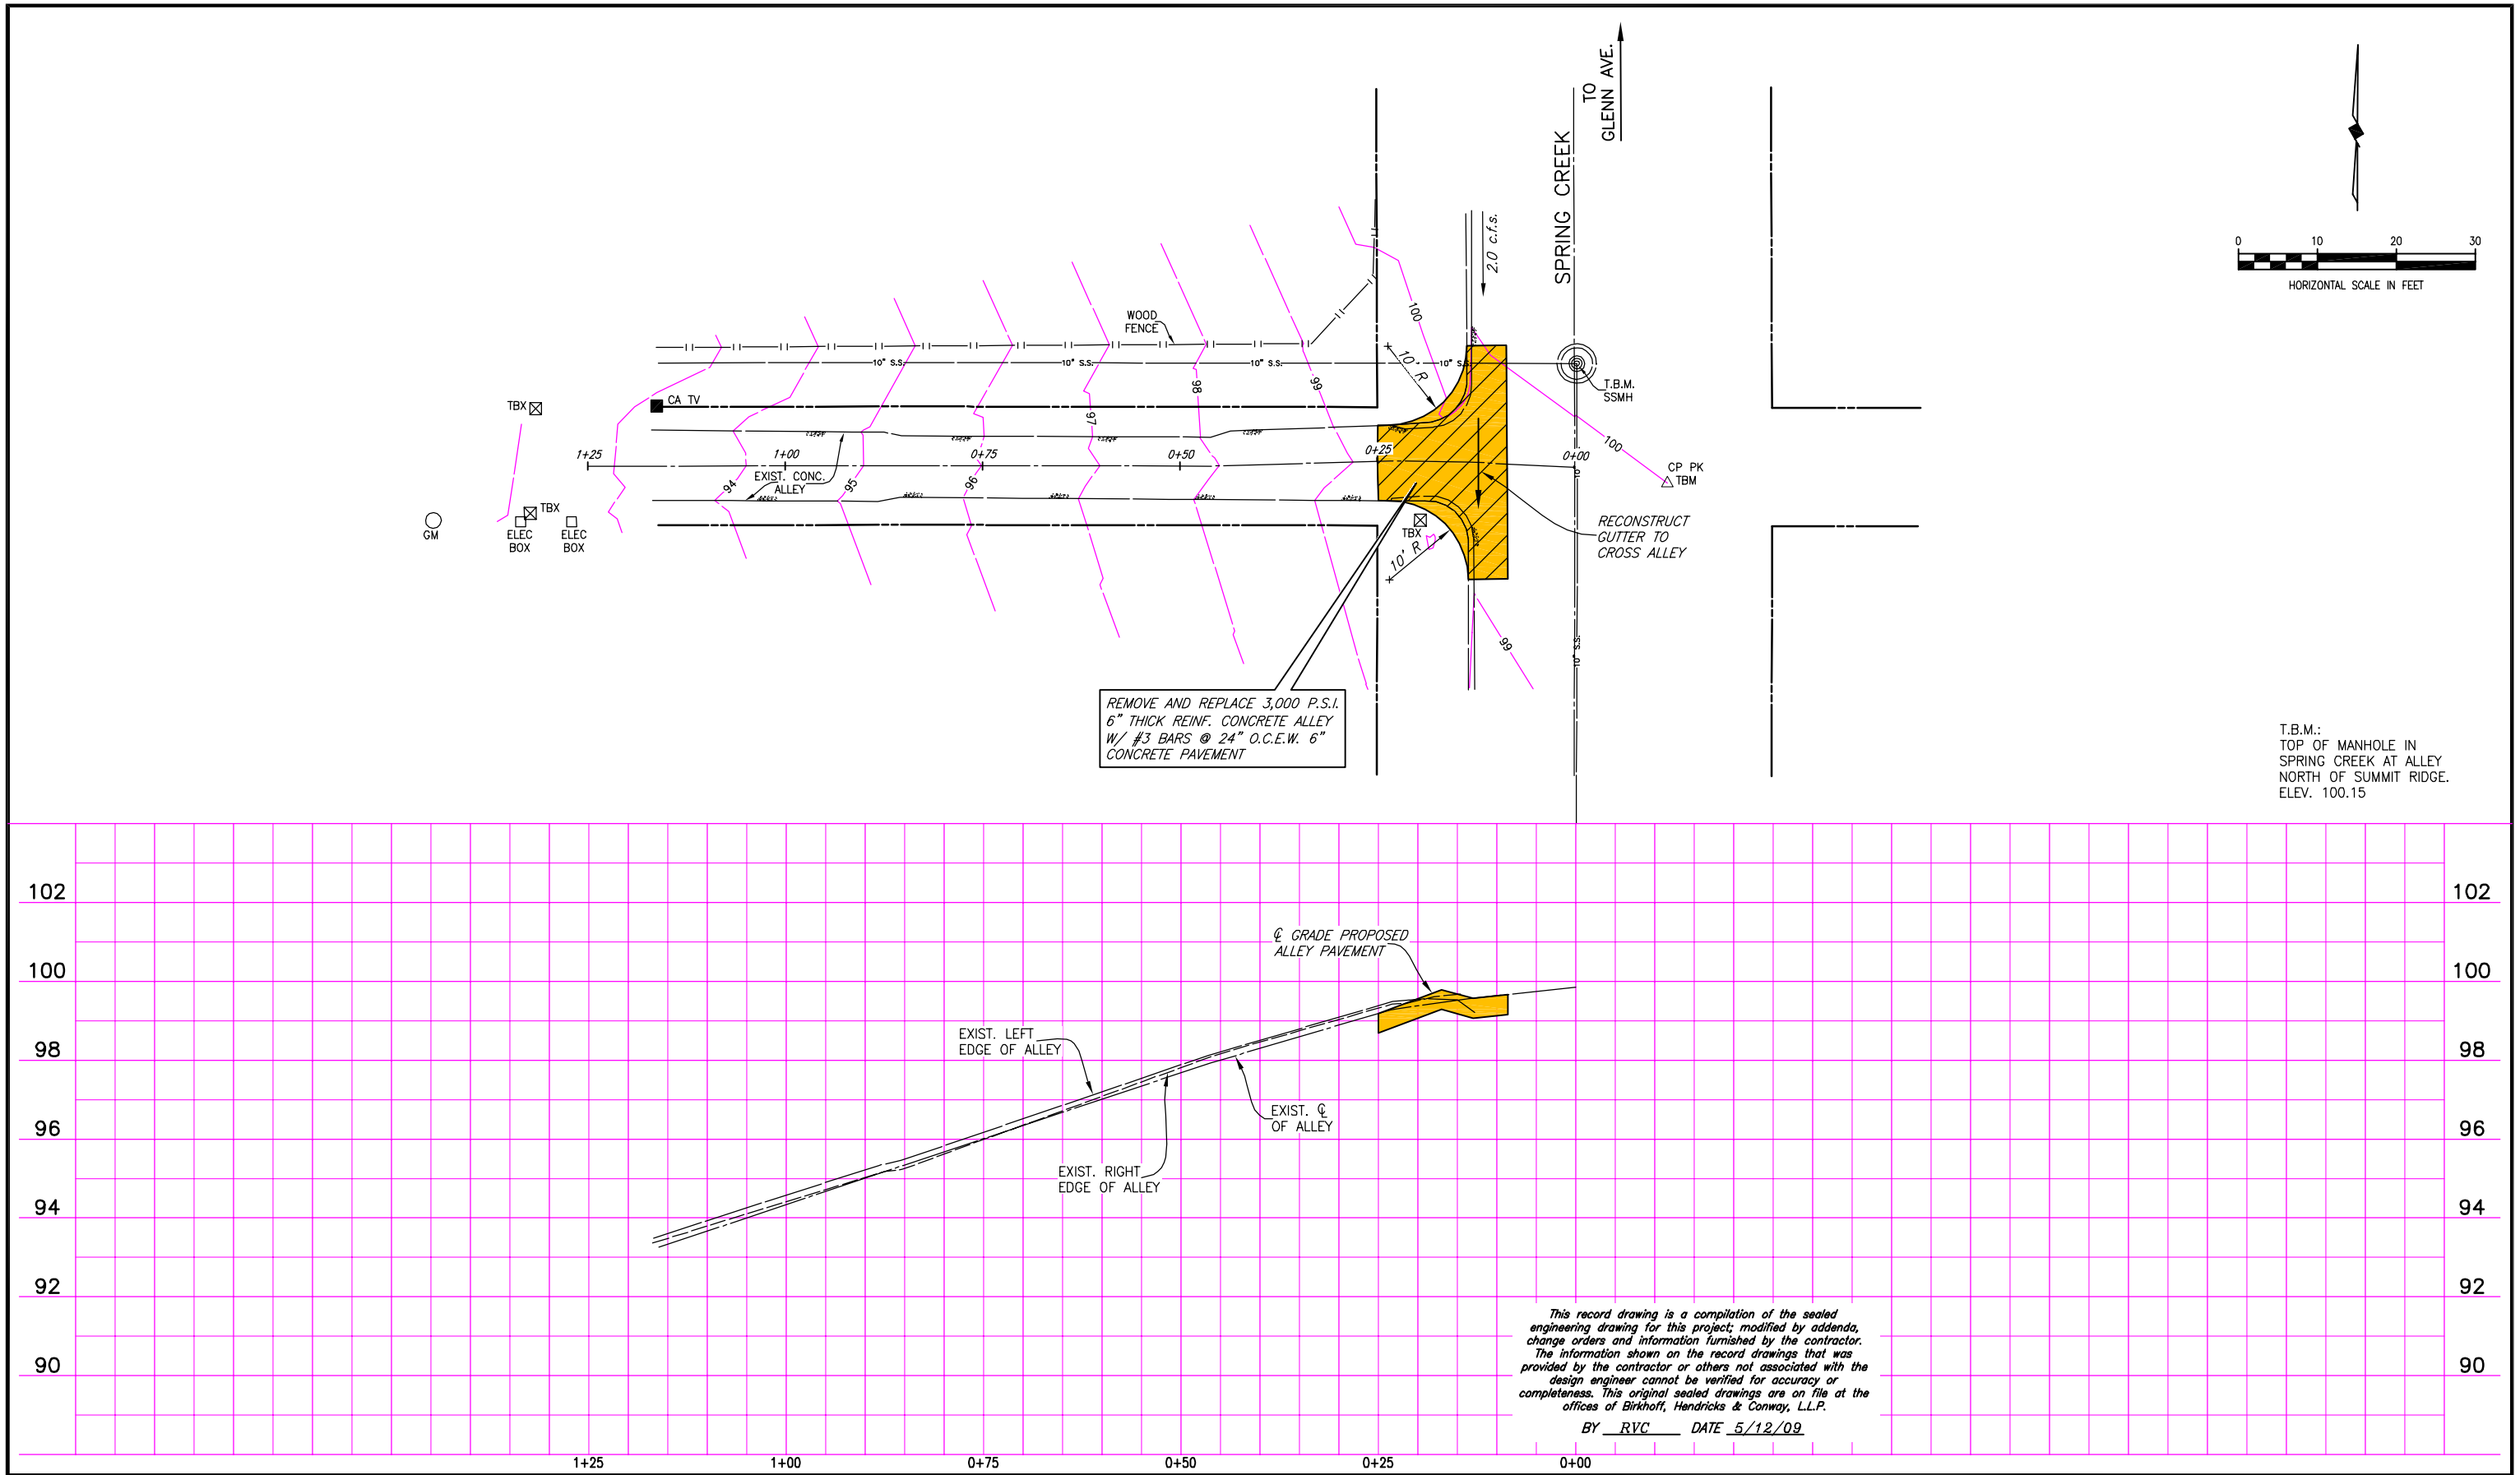

BIRKHOFF, HENDRICKS & CONWAY, L.L.P.
CONSULTING ENGINEERS
7502 Greenville Ave., Suite 220
Dallas, Texas
(214) 361-7900

STATE OF TEXAS
RONALD V CONWAY
37891
REGISTERED PROFESSIONAL ENGINEER

1/31/07

CITY OF ROCKWALL, TEXAS
NEIGHBORHOOD DRAINAGE IMPROVEMENTS

DRAINAGE SITE 17 IMPROVEMENTS
ALLEY NORTH OF SUMMIT RIDGE AT SPRING CREEK

BHC PROJECT NO. 2006-182

JANUARY, 2007

SHEET NO. **20**

These plans and related specifications were prepared for construction of this specific project only. Reuse of these documents is not permitted without written authorization of Birkhoff, Hendricks, & Conway, L.L.P.