BORDER_335401BDR1.DGN, 1-4,6,7,20-30,32,34-45,47-59,61,62
no ref levels
no ref logical, *no ref name*, *no ref levels*

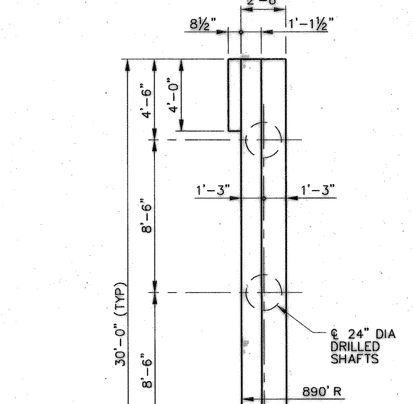

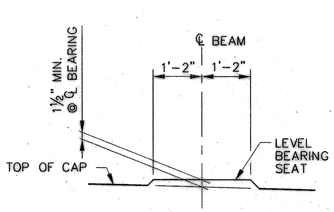

BEARING SEAT DETAIL

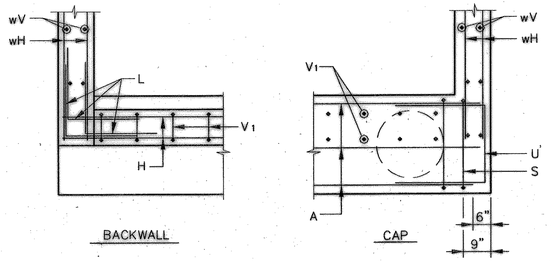

CORNER DETAILS
NOT TO SCALE

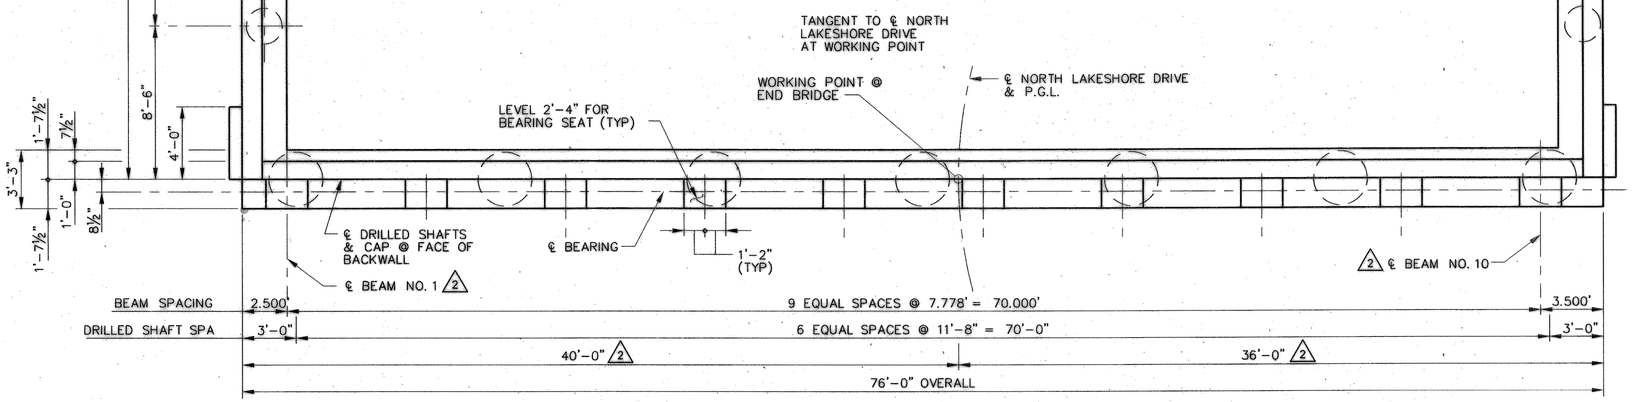

PLAN
SCALE: ¼"=1'-0"

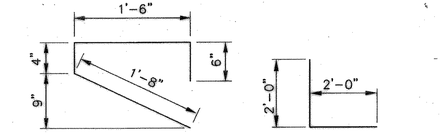

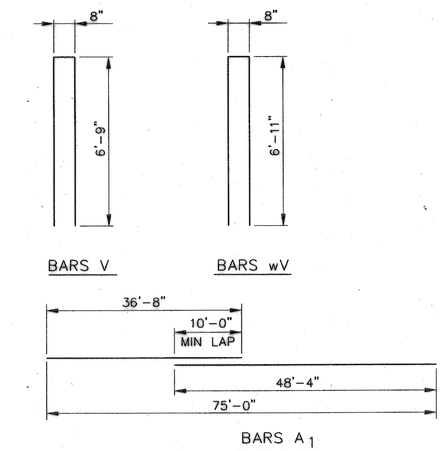

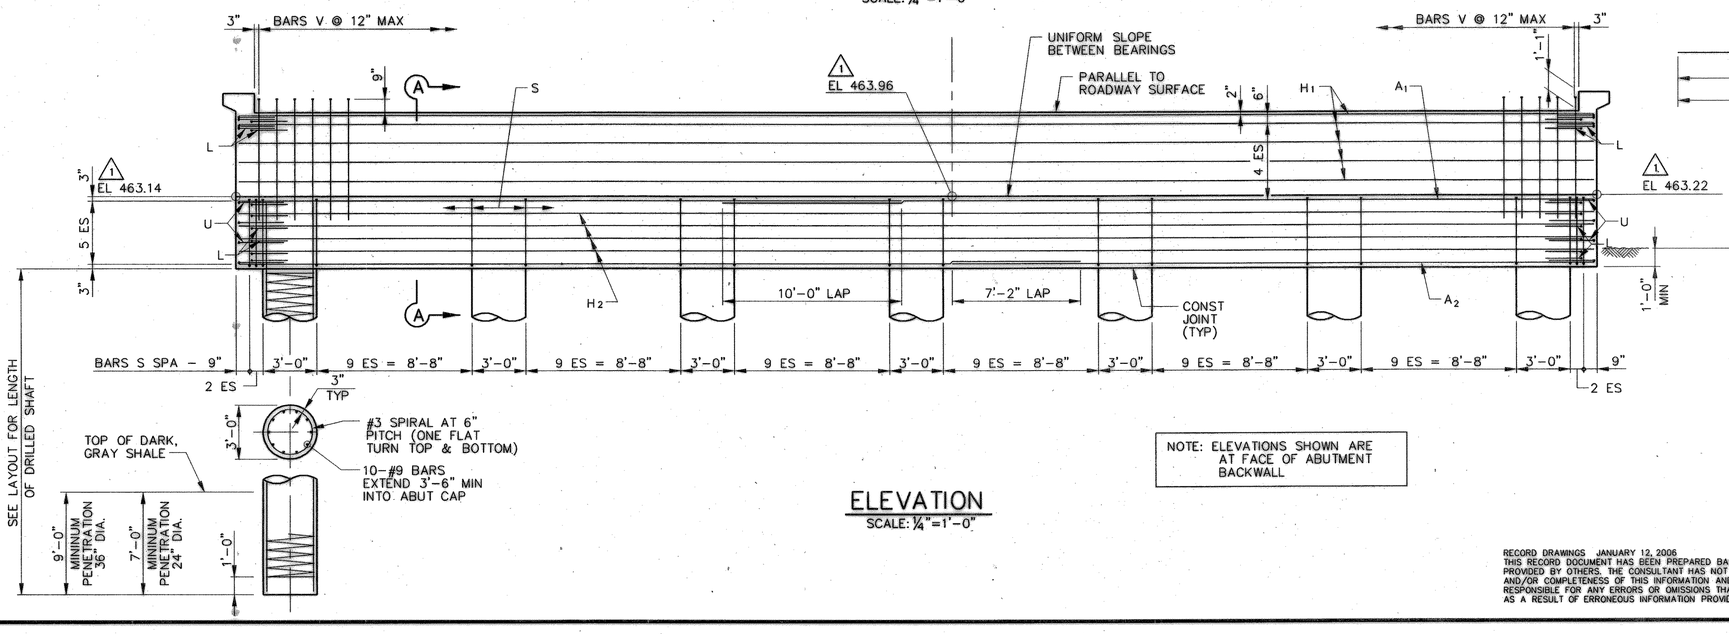

ELEVATION
SCALE: ¼"=1'-0"

NOTE: ELEVATIONS SHOWN ARE AT FACE OF ABUTMENT BACKWALL

RECORD DRAWINGS JANUARY 12, 2006
THIS RECORD DOCUMENT HAS BEEN PREPARED BASED ON INFORMATION PROVIDED BY OTHERS. THE CONSULTANT HAS NOT VERIFIED THE ACCURACY AND/OR COMPLETENESS OF THIS INFORMATION AND SHALL NOT BE RESPONSIBLE FOR ANY ERRORS OR OMISSIONS THAT MAY BE INCORPORATED AS A RESULT OF ERRONEOUS INFORMATION PROVIDED BY OTHERS.

THE SEAL APPEARING ON THIS DOCUMENT WAS AUTHORIZED BY CHARLES E. QUADE, P.E. 69396 ON AUGUST 31, 2004

STATE OF TEXAS · CHARLES E QUADE · 69396 · LICENSED · PROFESSIONAL ENGINEER · 8/31/2004

SHEET 1 OF 2

NO.	DATE	REVISIONS	APPROVED
1	11/12/2004	REVISED FOR CLARIFICATION	
2	1/27/2005	REVISED FOR CLARIFICATION	

ABUTMENT NO. 5

NORTH LAKESHORE DRIVE

NAPA DRIVE TO S.H. 205

HUITT-ZOLLARS
Huitt-Zollars, Inc. Dallas
3131 McKinney Avenue, Suite 600
Dallas, Texas 75204-2480
Phone (214) 871-3311 Fax (214) 871-0757

CITY OF ROCKWALL, TEXAS

DESIGN	DRAWN	APPR.	SCALE	DATE	PROJECT NO.	NO.
HZI	HZI	CEQ	AS SHOWN	AUGUST 2004	01-3354-01	B-8

theresas
SCF=1.000021
PRF ROTATION=90.000000
f:\tbl\HZIFULL.TBL
h:\proj\01335401\dgn\335401TAB03.DGN
DATE: 1/12/2006
TIME: 08:36:24