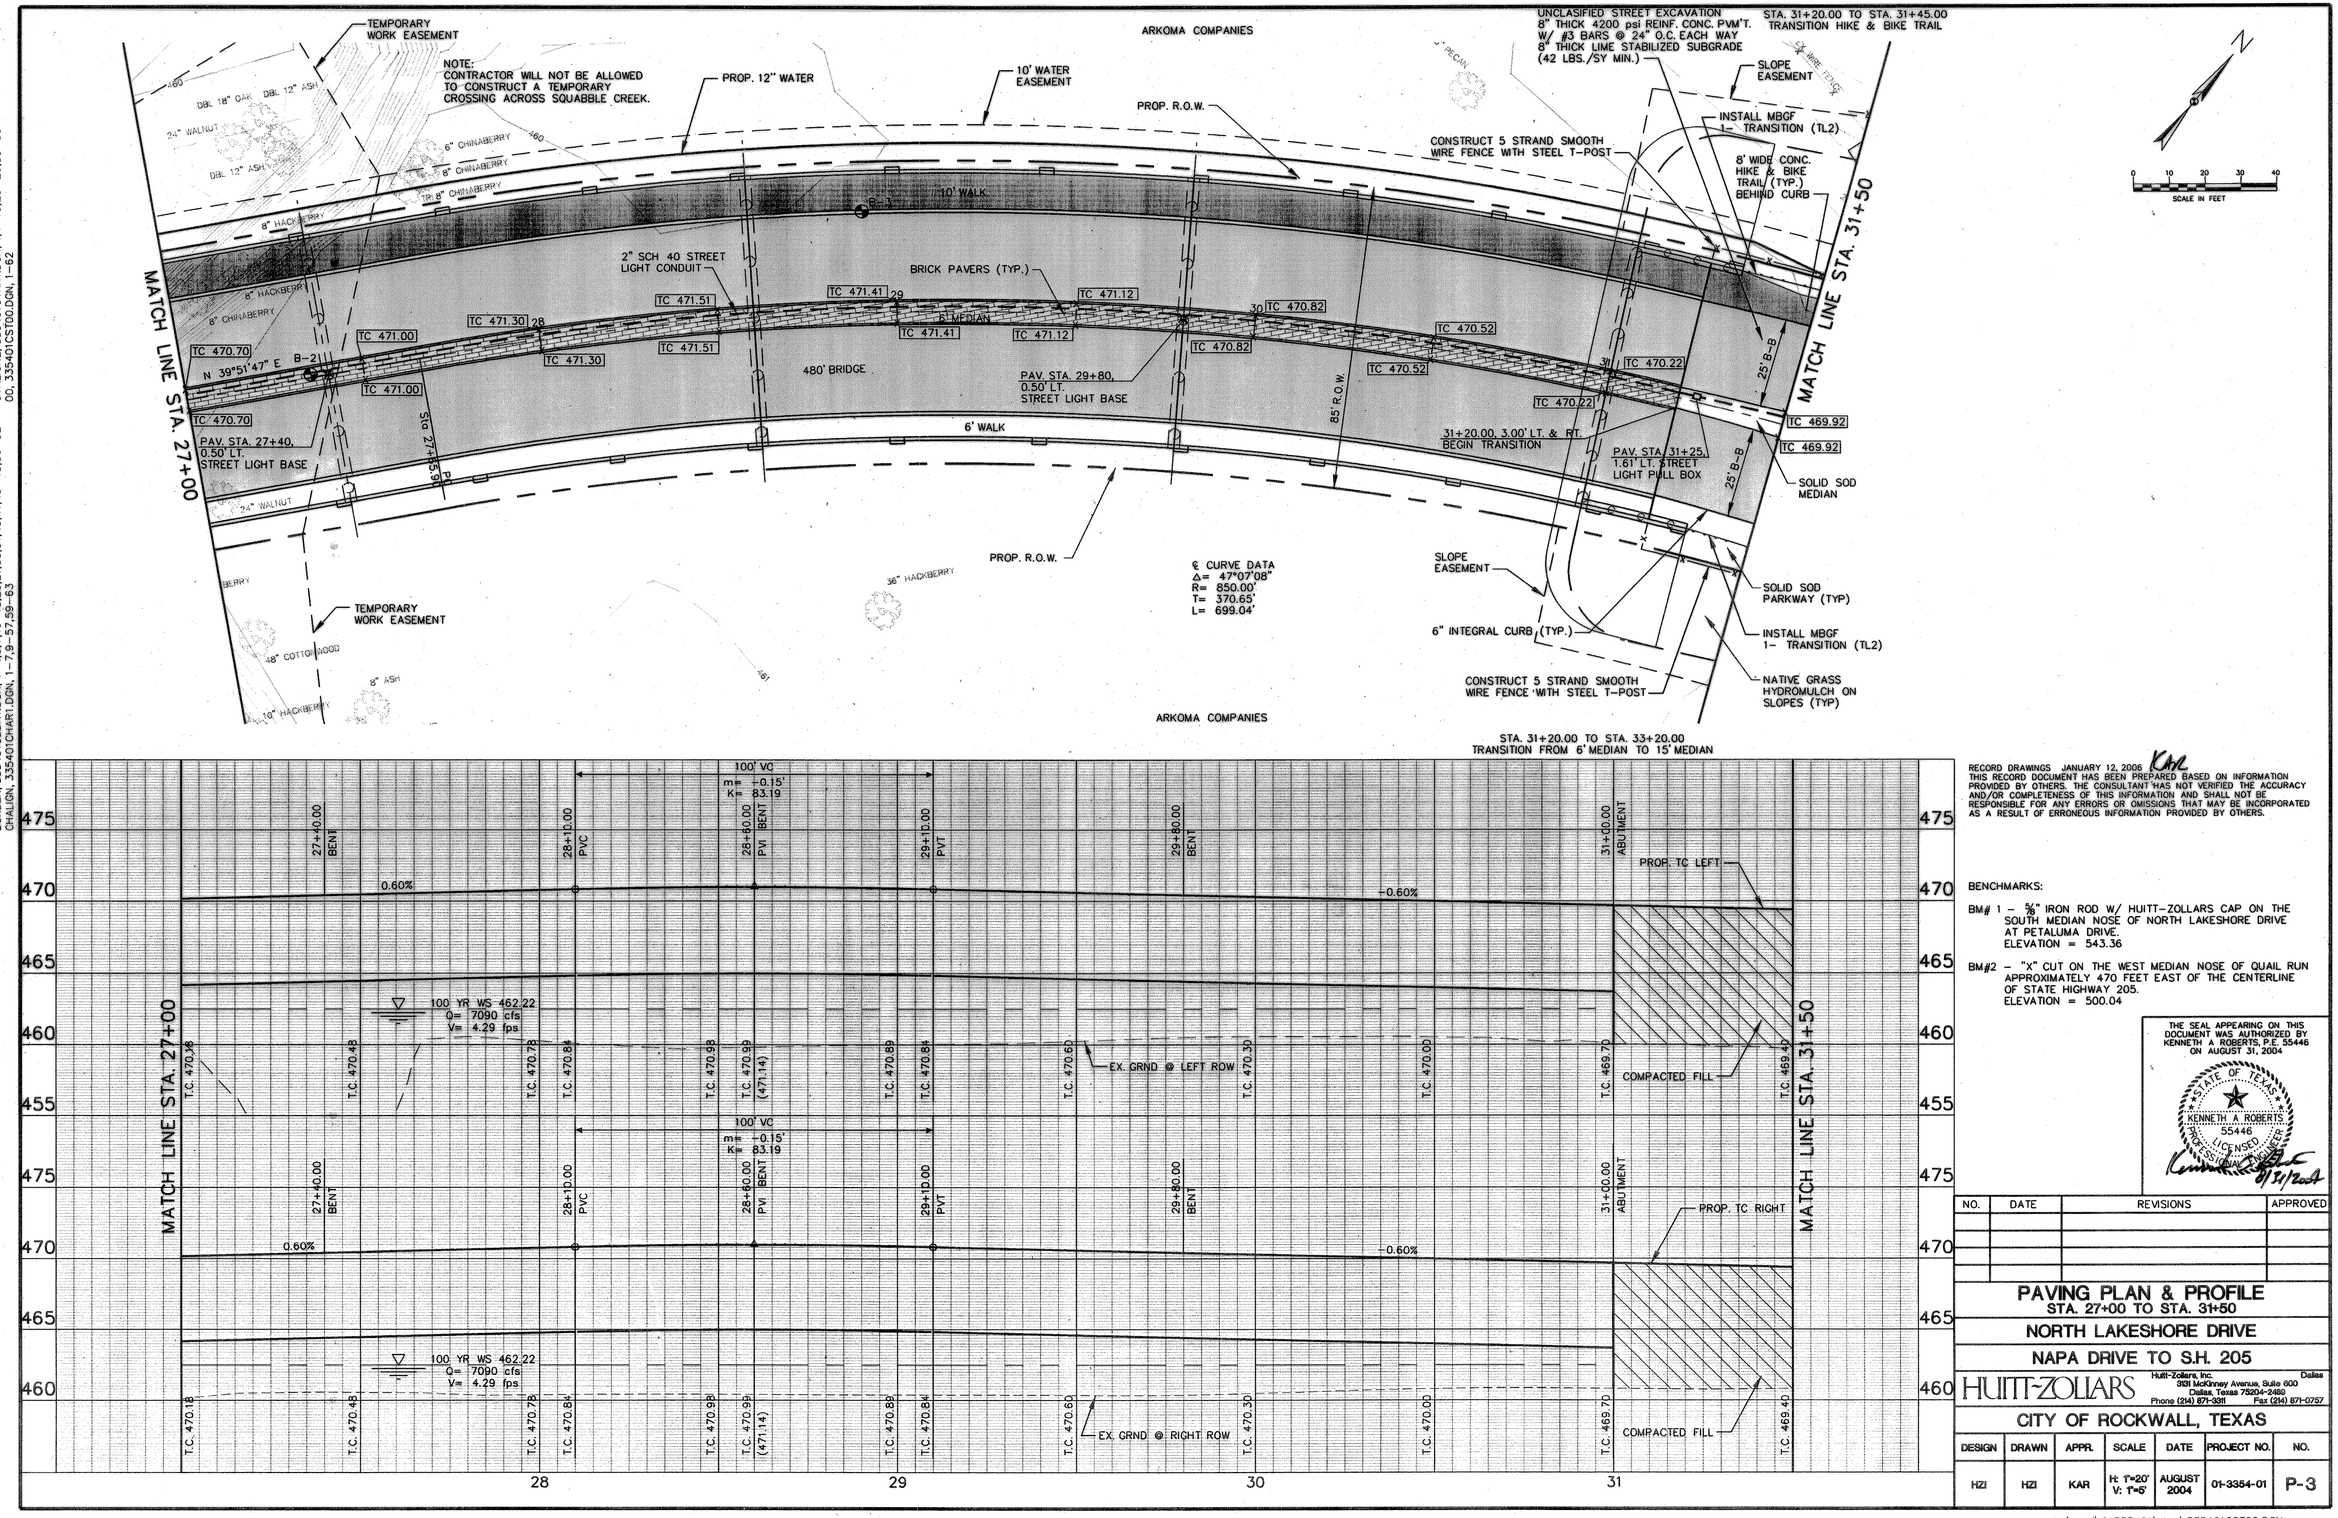

CVALIGN1, 335401CVAR1.DGN, 1,3,5-16,23-34,41-55
TBRIDGE, 335401TBPR1.DGN, 2-63
GRAD, REGRADING.DGN, 1-40,42-63
CSTRUCT, 335401CSTR1.DGN, 1-63
CVALIGN2, 335401CVAR1.DGN, 1,4-16,23-26,33-55
CD, 335401CSTD0.DGN, 1-62

CROW, 335401CRWR1.DGN, 1-47,49-63
VFIELD, 335401VFTR1.DGN, 1-3,5-9,11-35,37-41,44,45,50-53,55-57,60-62
SURV, 335403.DGN, 1-63
CSPLAN, 335401CSPL1.DGN, 1-41,43-62
GSPR, 335401GSPR1.DGN, 1-4,6,7,16-18,20,21,30,31,40,41,45-48,50-52
CHALIGN, 335401CHAR1.DGN, 1-7,9-57,59-63

theressa
SCALE=20.000000
PRF ROTATION=50.000000
f:\tb\VIZFULL.TBL

h:\proj\01335401\dgn\335401CST02.DGN
DATE: 1/10/2006
TIME: 08:48:43

RECORD DRAWINGS JANUARY 12, 2006 KAR
THIS RECORD DOCUMENT HAS BEEN PREPARED BASED ON INFORMATION PROVIDED BY OTHERS. THE CONSULTANT HAS NOT VERIFIED THE ACCURACY AND/OR COMPLETENESS OF THIS INFORMATION AND SHALL NOT BE RESPONSIBLE FOR ANY ERRORS OR OMISSIONS THAT MAY BE INCORPORATED AS A RESULT OF ERRONEOUS INFORMATION PROVIDED BY OTHERS.

BENCHMARKS:

BM# 1 – ⅝" IRON ROD W/ HUITT-ZOLLARS CAP ON THE SOUTH MEDIAN NOSE OF NORTH LAKESHORE DRIVE AT PETALUMA DRIVE.
ELEVATION = 543.36

BM#2 – "X" CUT ON THE WEST MEDIAN NOSE OF QUAIL RUN APPROXIMATELY 470 FEET EAST OF THE CENTERLINE OF STATE HIGHWAY 205.
ELEVATION = 500.04

THE SEAL APPEARING ON THIS DOCUMENT WAS AUTHORIZED BY KENNETH A ROBERTS, P.E. 55446 ON AUGUST 31, 2004

STATE OF TEXAS
KENNETH A ROBERTS
55446
LICENSED PROFESSIONAL ENGINEER
8/31/2004

NO.	DATE	REVISIONS	APPROVED

PAVING PLAN & PROFILE
STA. 27+00 TO STA. 31+50
NORTH LAKESHORE DRIVE
NAPA DRIVE TO S.H. 205

HUITT-ZOLLARS
Huitt-Zollars, Inc. Dallas
3131 McKinney Avenue, Suite 600
Dallas, Texas 75204-2460
Phone (214) 871-3311 Fax (214) 871-0757

CITY OF ROCKWALL, TEXAS

DESIGN	DRAWN	APPR.	SCALE	DATE	PROJECT NO.	NO.
HZI	HZI	KAR	H: 1"=20' V: 1"=5'	AUGUST 2004	01-3354-01	P-3

h:\proj\01335401\dgn\335401CST02.DGN