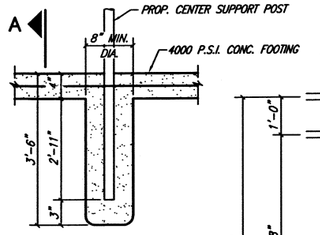

ELEVATION

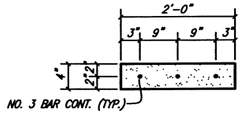

SECTION A–A

MOW STRIP NOTES:
1. MOW STRIP SHALL HAVE TOOLED JOINT @ 10' O.C.
2. MOW STRIP SHALL HAVE EXPANSION JOINT @ 50' O.C.
3. CONCRETE MOW STRIP NOT REQUIRED WHERE FENCE POSTS ARE EMBEDDED IN RETAINING WALL.

⚠1 FENCE MOW STRIP

NO SCALE

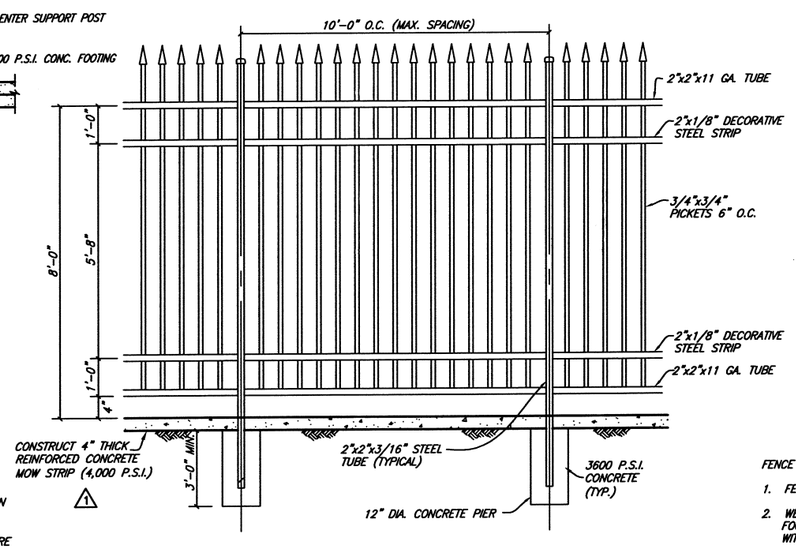

WELDED STEEL FENCE ELEVATION

NO SCALE

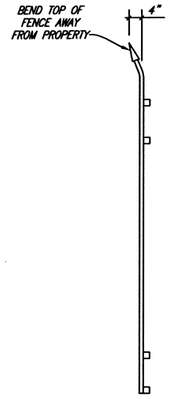

SECTION

NO SCALE

FENCE NOTES:
1. FENCE SHALL BE MADE OF PAINTED WELDED STEEL.
2. WELDED STEEL GATES SHALL BE DOUBLE 7 FOOT WIDE, MANUAL SWING OPENING GATES WITH LATCH PLATE FOR LOCKING & PADLOCK.
3. SHOP DRAWINGS FOR GATES, ALL FENCING AND PAINT COLOR SHALL BE SUBMITTED TO ENGINEER FOR APPROVAL PRIOR TO FABRICATION.
4. WHERE FENCE WILL BE INSTALLED OVER EXISTING CONCRETE PAVEMENT HOLE SHALL BE CORED IN PAVEMENT TO INSTALL FENCE POST EXCEPT ALONG REMAINING WALL WHERE FENCE SHALL BE BOLTED TO CONCRETE PAVEMENT.

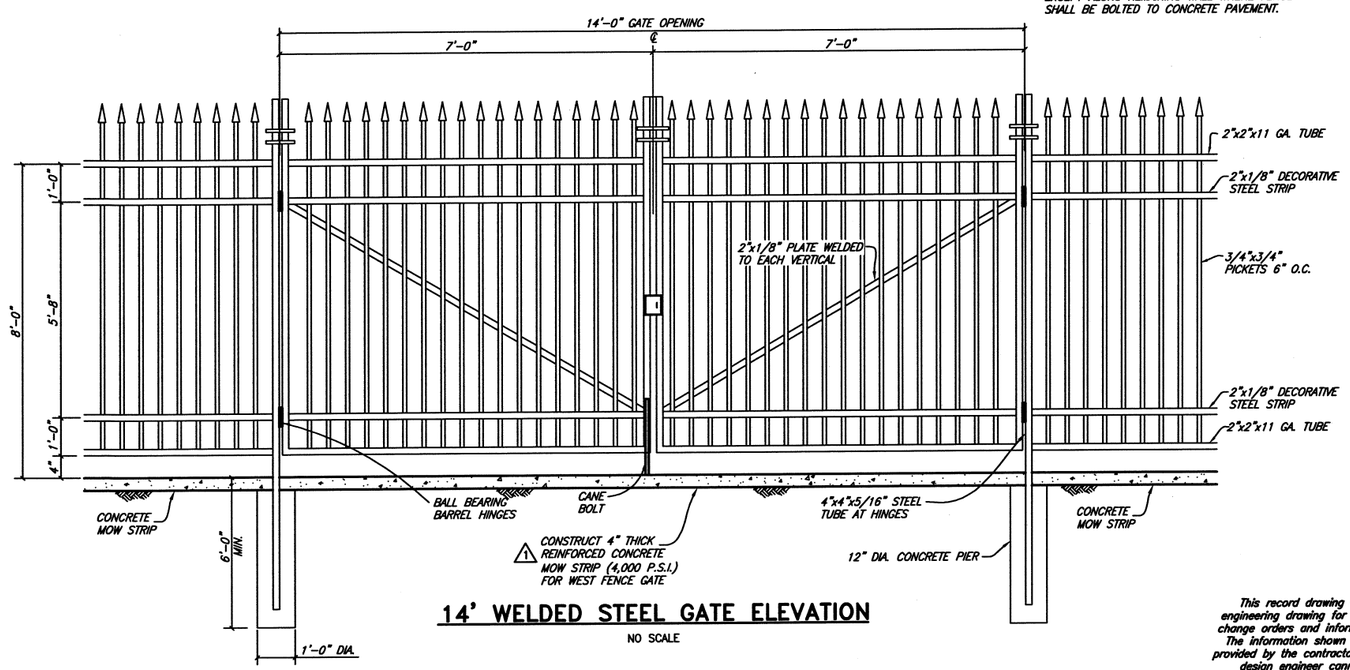

14' WELDED STEEL GATE ELEVATION

NO SCALE

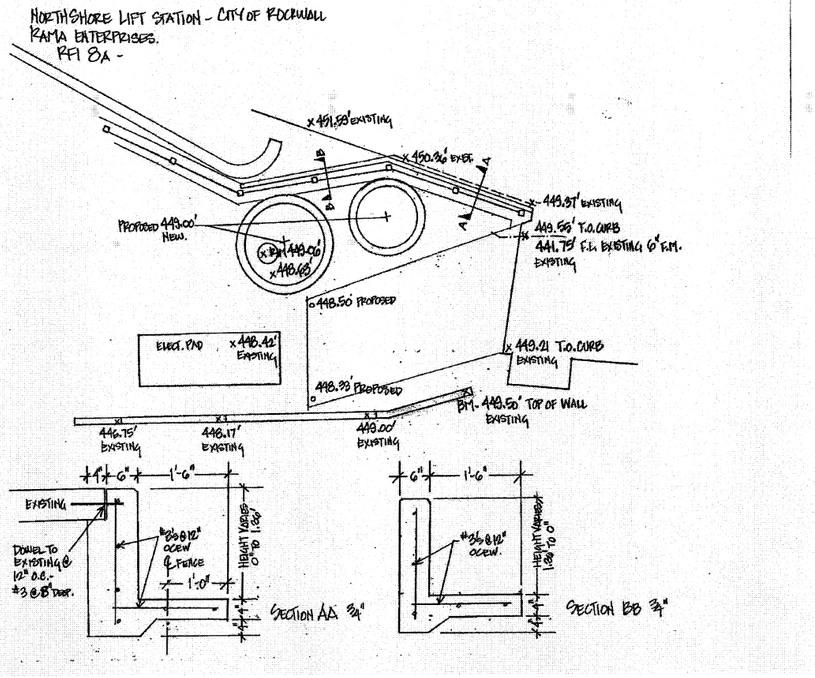

SKETCH OF WALL FROM CONTRACTOR

This record drawing is a compilation of the sealed engineering drawing for this project; modified by addenda, change orders and information furnished by the contractor. The information shown on the record drawings that was provided by the contractor or others not associated with the design engineer cannot be verified for accuracy or completeness. This original sealed drawings are on file at the offices of Birkhoff, Hendricks & Carter, L.L.P.

BY MH DATE 06/08/15

⚠ ADDENDA NO. 1 (2/17/14) – ADDED REINFORCED CONCRETE MOW STRIP
CHANGE ORDER NO. X
FIELD CHANGE
ADDENDUM

These plans and related specifications were prepared for construction of this specific project only. Reuse of these documents is not permitted without written authorization of Birkhoff, Hendricks & Carter, L.L.P. If this drawing is converted to an electronic file, if any discrepancy occurs between the electronic file and the Birkhoff, Hendricks & Carter, L.L.P. original document, the original document will govern in all cases.

BIRKHOFF, HENDRICKS & CARTER, L.L.P.
PROFESSIONAL ENGINEERS
Texas Firm F526
11910 Greenville Ave., Suite 600
Dallas, Texas 75243 (214) 361-7900

STATE OF TEXAS · MATTHEW HICKEY · 85480 · LICENSED PROFESSIONAL ENGINEER

1/2/14

CITY OF ROCKWALL, TEXAS
NORTHSHORE LIFT STATION

MISCELLANEOUS DETAILS

BHC PROJECT NO. 2013-119
January 2014

SHEET NO. 15

REVISED: 6/10/15 – KBIRKHOFF

H:\Projects\Rockwall\2013119\Sheets\2013119 12 Misc Details.dwg PLOT SCALE: 1:2 PLOT STYLE: 11x17.ctb PLOTTED BY: KBIRKHOFF ON 6/10/2015