CURVE DATA							
CURVE	RADIUS	DELTA	TANGENT	LENGTH	CHORD	BEARING	P.C.	P.T.
C-4	100.00'	1°37'25"	1.96'	3.92'	3.92'	N 64°58'32" E	1+85.57	1+89.49
C-5	100.00'	0°79'16"	1.43'	2.87'	2.87'	N 67°05'21" E	3+75.63	3+78.50

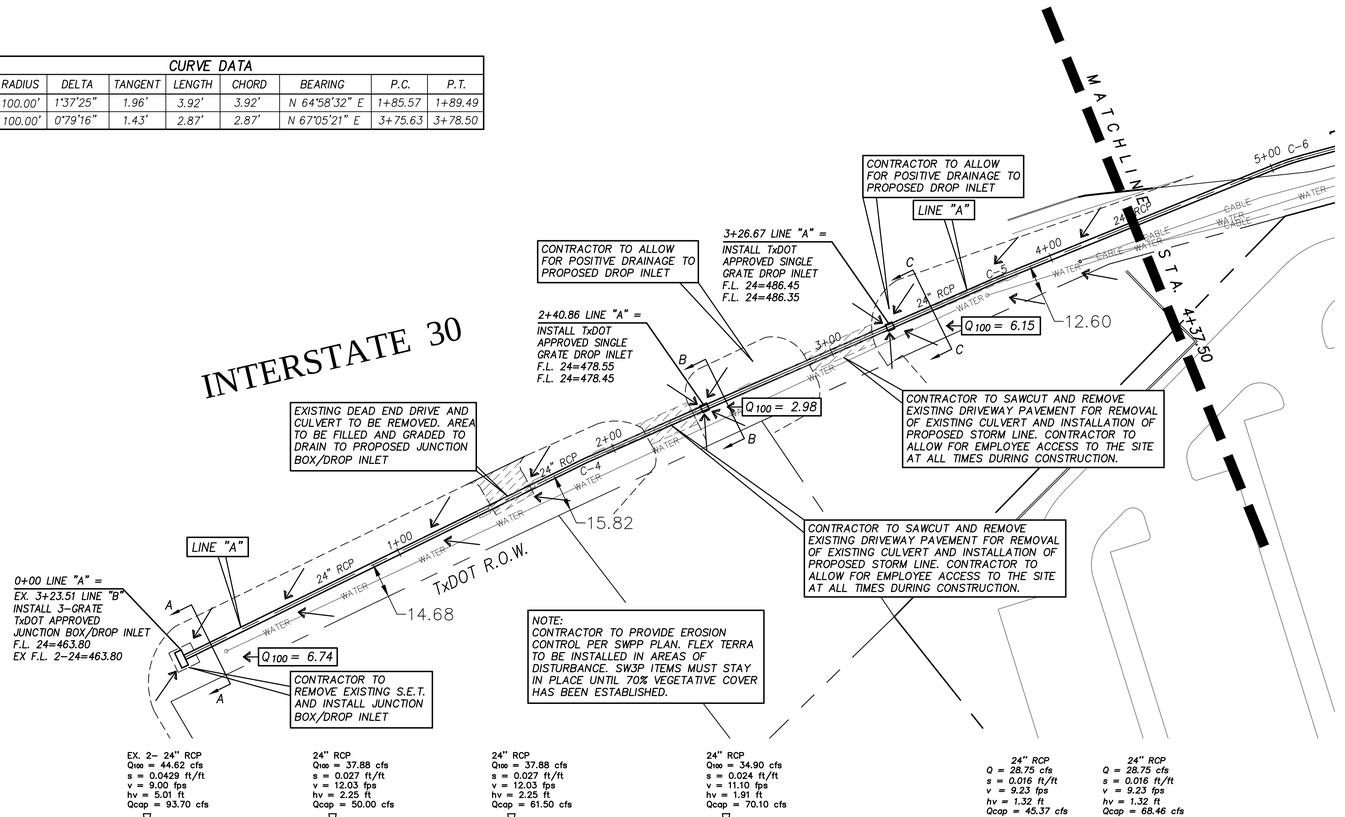

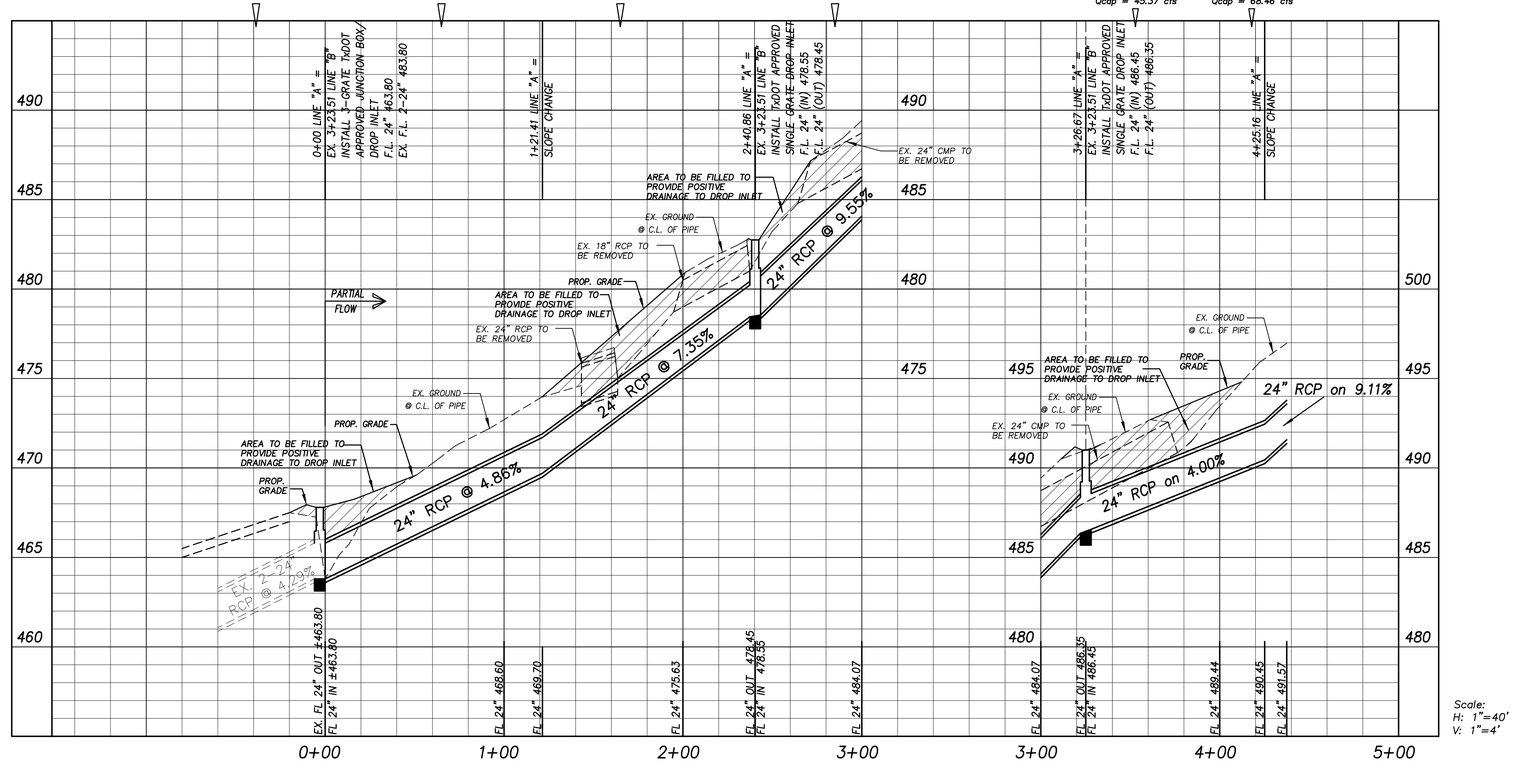

Scale:
H: 1"=40'
V: 1"=4'

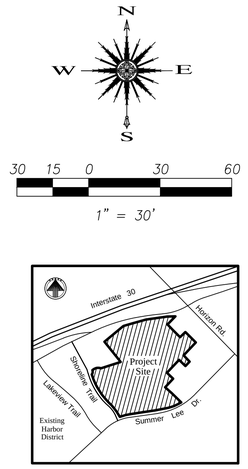

LOCATION MAP

LEGEND

DIRECTIONAL FLOW

EXIST. STORM SEWER

PROP. STORM SEWER

This drawing is proprietary and may not be copied or used in any way without the written permission of FC Cuny Corporation – © Copyright – FC Cuny Corporation

RECORD DRAWING

Revision	Date	Description

Owner:
CITY OF ROCKWALL

Developer:
Sterling One Construction L.L.C.
#2 Horizon Court • Heath, Texas 75032 • 469-772-9400

Harbor District Infrastructure

Rockwall, Texas

~ Civil Engineer ~
F.C. CUNY CORPORATION
#2 Horizon Court • Heath, Texas 75032 • (469) 402-7700
Texas Registered Engineering Firm F-7449

THE SEAL APPEARING ON THIS DOCUMENT WAS AUTHORIZED BY CHRISTOPHER R. CUNY, P.E. 65642

STATE OF TEXAS
CHRISTOPHER R. CUNY
65642
REGISTERED PROFESSIONAL ENGINEER
9-30-2019

Drawn By:	Checked By:
F.C. CUNY	F.C. CUNY
Date: 08/11	Project No.: -
Sheet Title: Storm Sewer Plan & Profile Line "A"	
Scale: 1"=30'	Sheet No.: 12 of 21