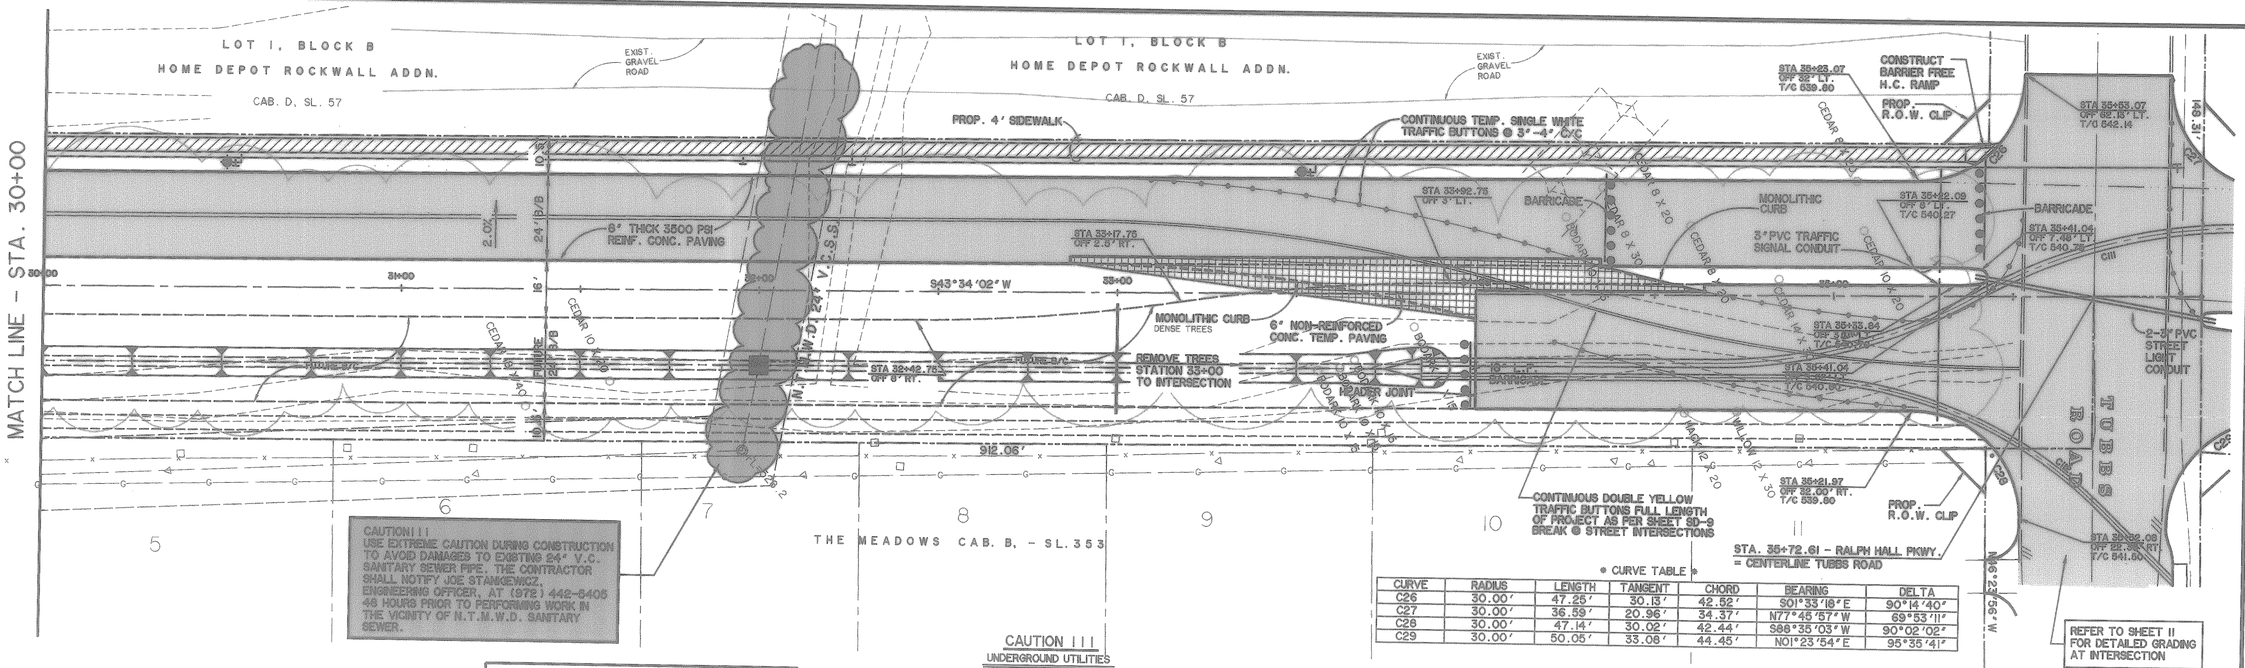

* CURVE TABLE *

CURVE	RADIUS	LENGTH	TANGENT	CHORD	BEARING	DELTA
C26	30.00'	47.25'	30.13'	42.52'	S01°33'18"E	90°14'40"
C27	30.00'	36.59'	20.96'	34.37'	N77°45'57"W	69°53'11"
C28	30.00'	47.14'	30.02'	42.44'	S88°35'03"W	90°02'02"
C29	30.00'	50.05'	33.08'	44.45'	N01°23'54"E	95°35'41"

LEGEND

- 8" - 3500 PSI CONCRETE PAVEMENT
- 6" - 3500 PSI NON-REINF. CONCRETE PAVEMENT
- 4' REINFORCED CONCRETE SIDEWALK

* BENCHMARKS *

GPS CONTROL MONUMENT #7 AT SOUTHEAST CORNER OF I-30 AND MIMS STREET. ELEV. 566.25

BOX CUT IN NW CURB RETURN AT THE INTERSECTION OF WESTWOOD AND ROCKWALL PARKWAY. ELEV. 537.86

BOX CUT IN NW CURB RETURN AT THE INTERSECTION OF WOODCREEK AND ROCKWALL PARKWAY. ELEV. 526.53

CAUTION !!! UNDERGROUND UTILITIES

EXISTING UTILITIES AND UNDERGROUND FACILITIES INDICATED ON THESE PLANS HAVE BEEN LOCATED FROM REFERENCE INFORMATION SUPPLIED BY VARIOUS OWNERS OF THE FACILITIES. THE ENGINEER DOES NOT ACCEPT THE RESPONSIBILITY FOR THE UTILITY LOCATIONS SHOWN. IT SHALL BE THE RESPONSIBILITY OF THE CONTRACTOR TO VERIFY BOTH HORIZONTALLY AND VERTICALLY THE LOCATION OF ALL EXISTING UTILITIES AND UNDERGROUND FACILITIES PRIOR TO CONSTRUCTION, TO TAKE NECESSARY PRECAUTIONS IN ORDER TO PROTECT ALL FACILITIES ENCOUNTERED, AND TO NOTIFY THE ENGINEER PROMPTLY OF ALL CONFLICTS OF THE WORK WITH EXISTING FACILITIES. THE CONTRACTOR SHALL PRESERVE AND PROTECT ALL EXISTING UTILITIES FROM DAMAGE DURING CONSTRUCTION. ANY DAMAGE BY THE CONTRACTOR TO EXISTING UTILITIES SHALL BE REPAIRED BY THE CONTRACTOR AT HIS EXPENSE. CONTACT ALL POSSIBLE UTILITY AND UNDERGROUND FACILITY OWNERS.

THE CITY OF ROCKWALL STANDARD CONSTRUCTION DETAILS ARE INCORPORATED HEREIN BY REFERENCE. ALL WORK SHALL BE PERFORMED IN ACCORDANCE WITH SHEETS 1-15 OF THE LATEST VERSION OF THESE DETAILS, WITH THE EXCEPTION OF THE FOLLOWING:
1. TYPICAL PAVEMENT SECTION.
2. RECESSED CURB INLET.

RALPH HALL PARKWAY

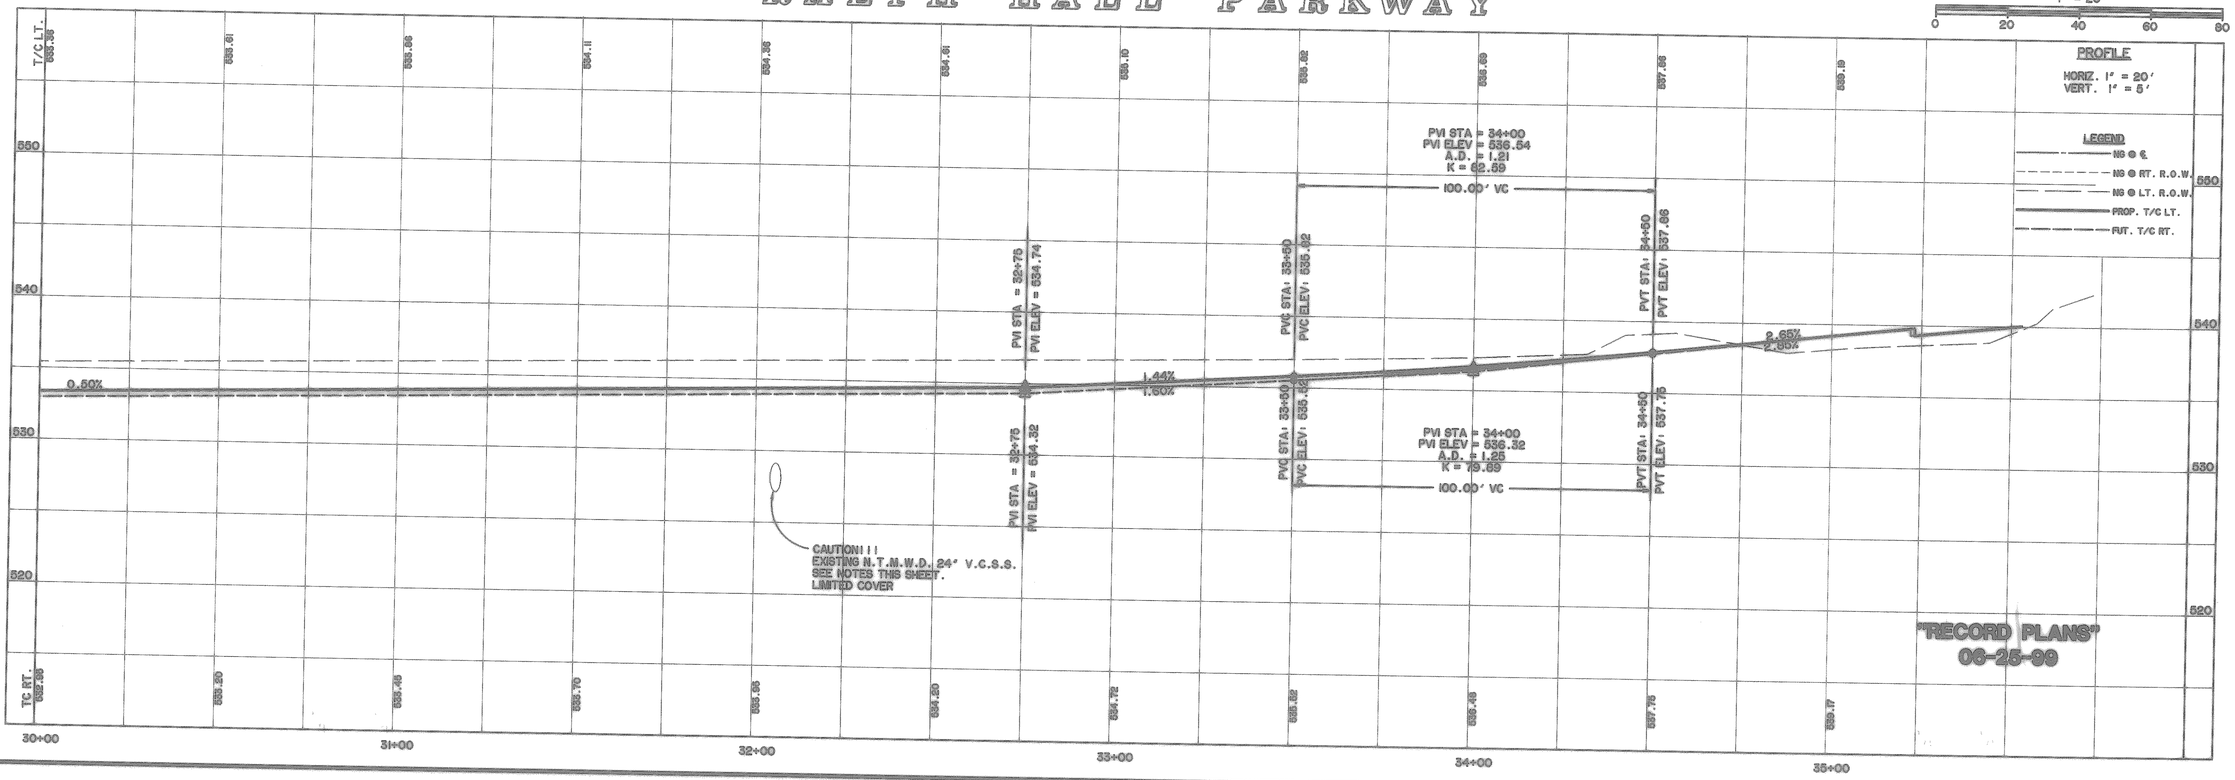

PREPARED BY:
WIER & ASSOCIATES, INC.
ENGINEERS SURVEYORS LAND PLANNERS
4300 BELTWAY PLACE SUITE 131 ARLINGTON, TEXAS 76018 METRO (817)467-7700
4100 ANN CONNER BLVD. SUITE 200 FORT WORTH, TEXAS 76155 METRO (817)355-0457

RALPH HALL PARKWAY
CITY OF ROCKWALL
ROCKWALL COUNTY, TEXAS

PAVING
PLAN & PROFILE
STA 30+00 TO END

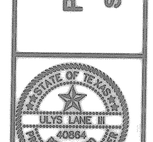

COPYRIGHT © WIER & ASSOCIATES, INC.

LAST SHEET EDIT DATE 06-28-99
W&A# 9705.7

SHEET NO. 9

TIME: 3:16PM FILE: PAVE7.DWG