CURVE	RADIUS	LENGTH	CHORD	BEARING	DELTA
C100	108.89'	30.39'	30.29'	N54°25'45"W	15°59'33"
C101	108.89'	30.39'	30.29'	S54°25'45"E	15°59'33"
C102	78.00'	53.66'	52.62'	N63°21'28"E	39°24'52"
C103	72.00'	96.39'	89.35'	S81°54'59"W	76°41'54"
C104	1174.00'	207.10'	206.83'	S36°30'49"W	10°06'26"
C105	1230.00'	92.47'	92.44'	N35°36'49"E	04°18'26"
C106	100.00'	11.14'	11.13'	N40°57'28"E	06°22'51"
C107	200.00'	37.47'	37.42'	S38°46'50"W	10°44'05"
C108	200.00'	37.47'	37.42'	N38°46'50"E	10°44'05"
C109	150.00'	131.19'	127.05'	N69°12'19"E	50°06'39"
C110	100.00'	152.62'	138.23'	S87°17'21"W	67°26'37"
C111	77.00'	107.46'	98.95'	S03°35'06"W	79°57'51"

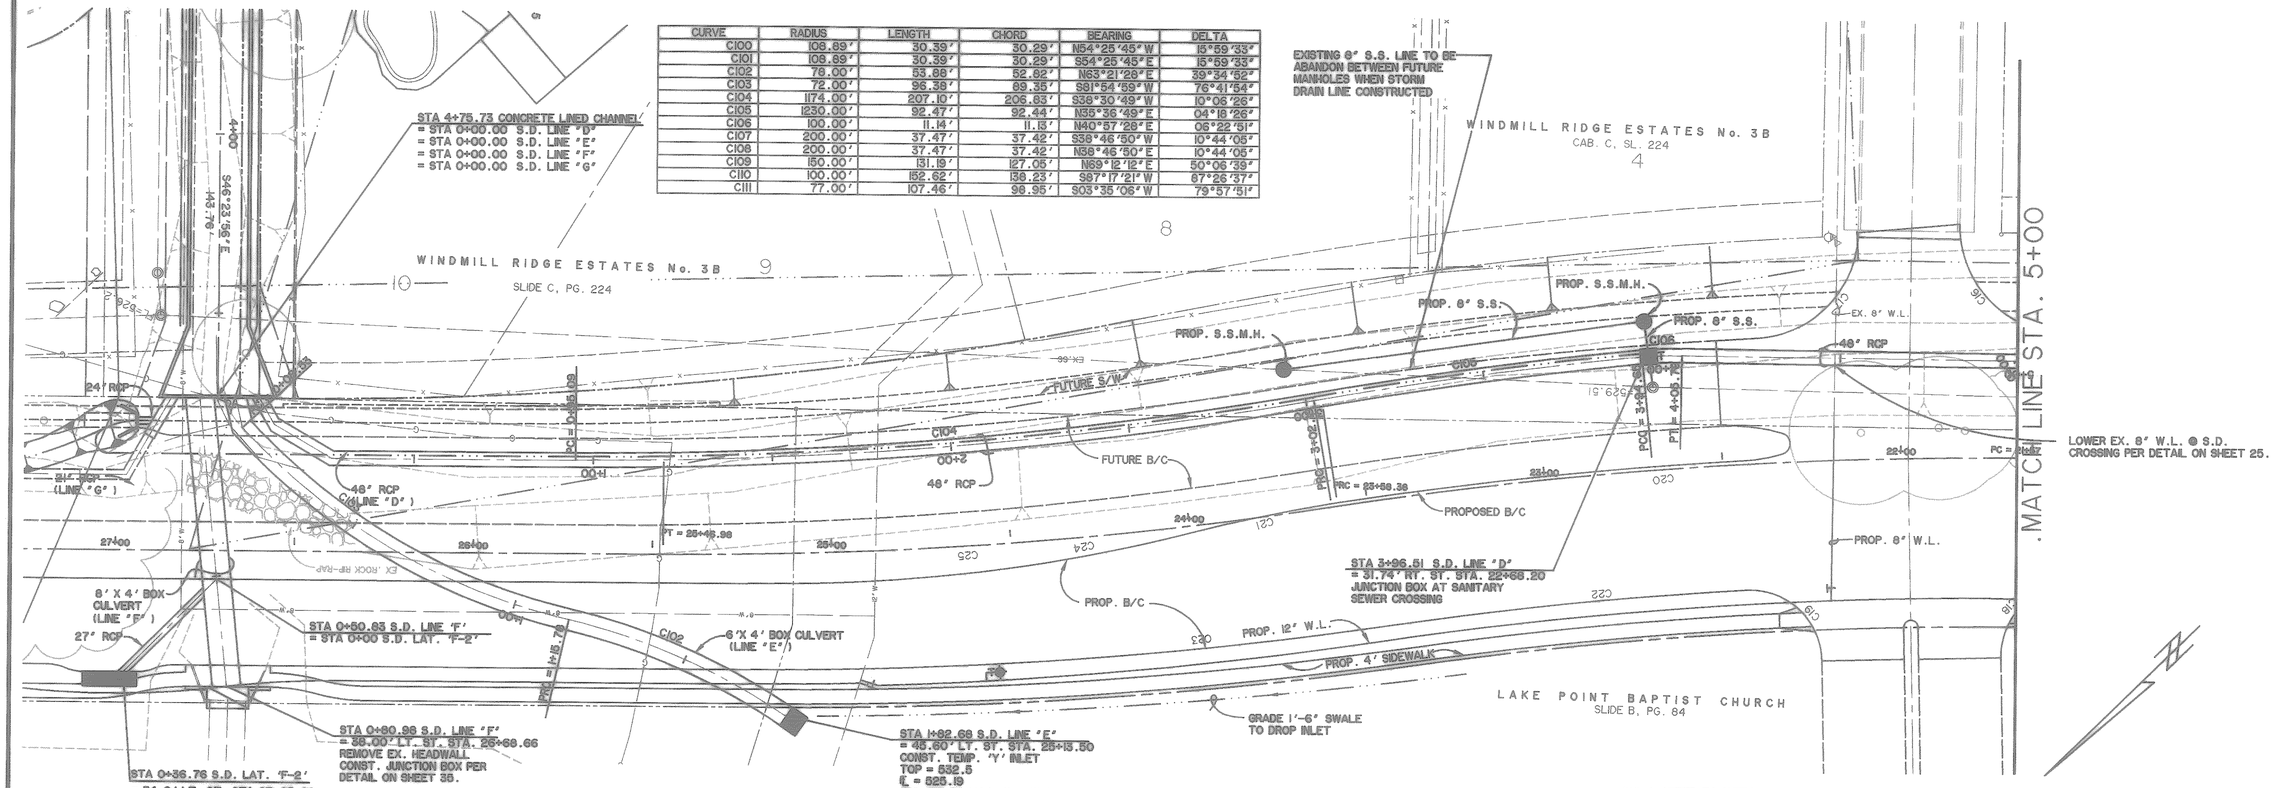

STORM DRAIN LINE "D"

BENCHMARKS

GPS CONTROL MONUMENT 97 AT SOUTHEAST CORNER OF I-30 AND MMS STREET. ELEV. 566.25

BOX CUT IN NW CURB RETURN AT THE INTERSECTION OF WESTWOOD AND ROCKWALL PARKWAY. ELEV. 537.86

BOX CUT IN NW CURB RETURN AT THE INTERSECTION OF WOODCREEK AND ROCKWALL PARKWAY. ELEV. 528.53

CAUTION !!!
UNDERGROUND UTILITIES

EXISTING UTILITIES AND UNDERGROUND FACILITIES INDICATED ON THESE PLANS HAVE BEEN LOCATED FROM REFERENCE INFORMATION SUPPLIED BY VARIOUS OWNERS OF THE FACILITIES. THE ENGINEER DOES NOT ACCEPT THE RESPONSIBILITY FOR THE UTILITY LOCATIONS SHOWN. IT SHALL BE THE RESPONSIBILITY OF THE CONTRACTOR TO VERIFY BOTH HORIZONTALLY AND VERTICALLY THE LOCATION OF ALL EXISTING UTILITIES AND UNDERGROUND FACILITIES PRIOR TO CONSTRUCTION, TO TAKE NECESSARY PRECAUTIONS IN ORDER TO PROTECT ALL FACILITIES ENCOUNTERED, AND TO NOTIFY THE ENGINEER PROMPTLY OF ALL CONFLICTS OF THE WORK WITH EXISTING FACILITIES. THE CONTRACTOR SHALL PRESERVE AND PROTECT ALL EXISTING UTILITIES FROM DAMAGE DURING CONSTRUCTION. ANY DAMAGE BY THE CONTRACTOR TO EXISTING UTILITIES SHALL BE REPAIRED BY THE CONTRACTOR AT HIS EXPENSE. CONTACT ALL POSSIBLE UTILITY AND UNDERGROUND FACILITY OWNERS.

PROFILE
HORIZ. 1" = 20'
VERT. 1" = 5'

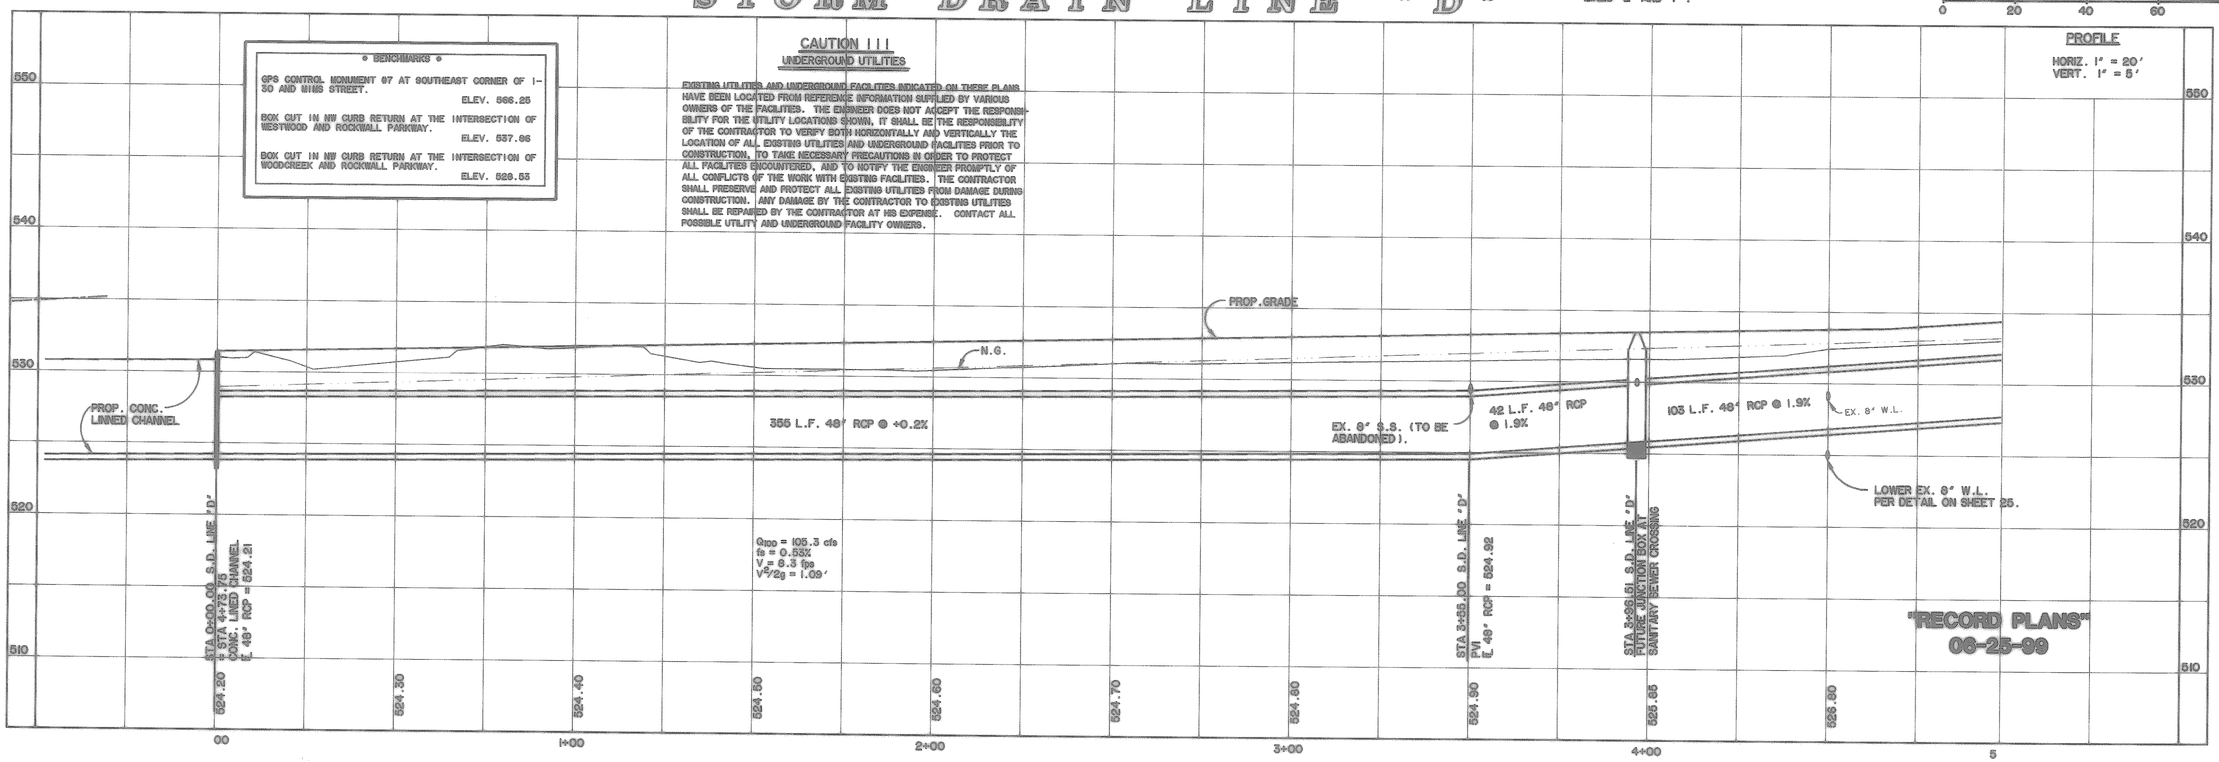

"RECORD PLANS"
06-25-99

NOTE: REFER TO SHEET 20 FOR PROFILES OF STORM DRAIN LINES 'E' AND 'F'.

PREPARED BY:
WEIR & ASSOCIATES, INC.
ENGINEERS SURVEYORS LAND PLANNERS
4300 BELTWAY PLACE, SUITE 130, ARLINGTON, TEXAS 76018 METRO (817)467-7700
4400 ASH CREEK BLVD., SUITE 200, FORT WORTH, TEXAS 76155 METRO (817)358-9457

RALPH HALL PARKWAY
CITY OF ROCKWALL
ROCKWALL COUNTY, TEXAS

STORM DRAIN
LINE "D"
PLAN & PROFILE
STA. 0+00 TO STA. 5+00

STATE OF TEXAS
ULYS LANE III
40384
REGISTERED PROFESSIONAL ENGINEER
6-30-99

COPYRIGHT © WEIR & ASSOCIATES, INC.

LAST SHEET EDIT
DATE 06-27-99
WA# 97057

SHEET NO.
14

TIME: 6:16AM FILE: SDPP1.dwg