CAUTION !!!
UNDERGROUND UTILITIES

EXISTING UTILITIES AND UNDERGROUND FACILITIES INDICATED ON THESE PLANS HAVE BEEN LOCATED FROM REFERENCE INFORMATION SUPPLIED BY VARIOUS OWNERS OF THE FACILITIES. THE ENGINEER DOES NOT ACCEPT THE RESPONSIBILITY FOR THE UTILITY LOCATIONS SHOWN, IT SHALL BE THE RESPONSIBILITY OF THE CONTRACTOR TO VERIFY BOTH HORIZONTALLY AND VERTICALLY THE LOCATION OF ALL EXISTING UTILITIES AND UNDERGROUND FACILITIES PRIOR TO CONSTRUCTION, TO TAKE NECESSARY PRECAUTIONS IN ORDER TO PROTECT ALL FACILITIES ENCOUNTERED, AND TO NOTIFY THE ENGINEER PROMPTLY OF ALL CONFLICTS OF THE WORK WITH EXISTING FACILITIES. THE CONTRACTOR SHALL PRESERVE AND PROTECT ALL EXISTING UTILITIES FROM DAMAGE DURING CONSTRUCTION. ANY DAMAGE BY THE CONTRACTOR TO EXISTING UTILITIES SHALL BE REPAIRED BY THE CONTRACTOR AT HIS EXPENSE.

CURVE TABLE

NO.	RADIUS	DELTA	ARC	TANGENT	CHORD	BEARING
1113	250.00	12°34'41"	54.88	27.55	54.77	S 37°49'01"W
1114	250.00	12°34'41"	54.88	27.55	54.77	N 37°49'01"E

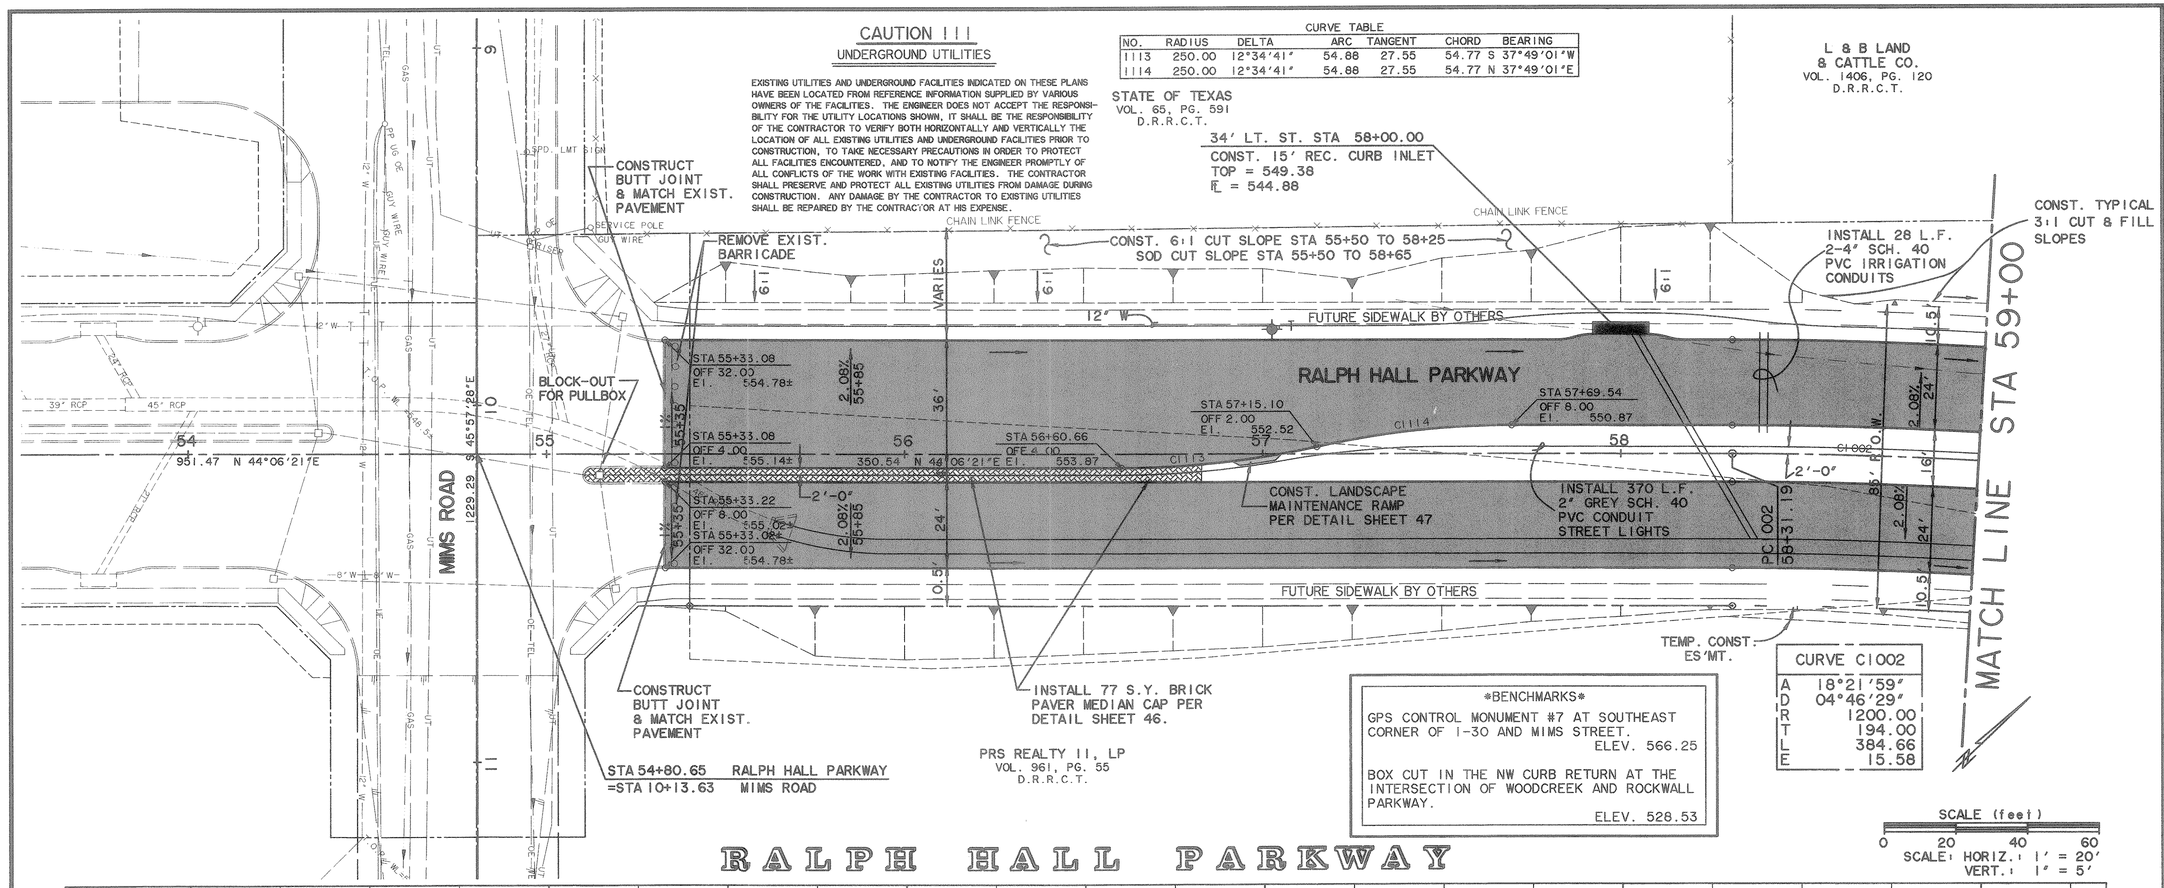

BENCHMARKS

GPS CONTROL MONUMENT #7 AT SOUTHEAST CORNER OF I-30 AND MIMS STREET.
ELEV. 566.25

BOX CUT IN THE NW CURB RETURN AT THE INTERSECTION OF WOODCREEK AND ROCKWALL PARKWAY.
ELEV. 528.53

CURVE C1002

A	18°21'59"
D	04°46'29"
R	1200.00
T	194.00
L	384.66
E	15.58

SCALE (feet)
0 20 40 60
SCALE: HORIZ.: 1' = 20'
VERT.: 1" = 5'

RALPH HALL PARKWAY

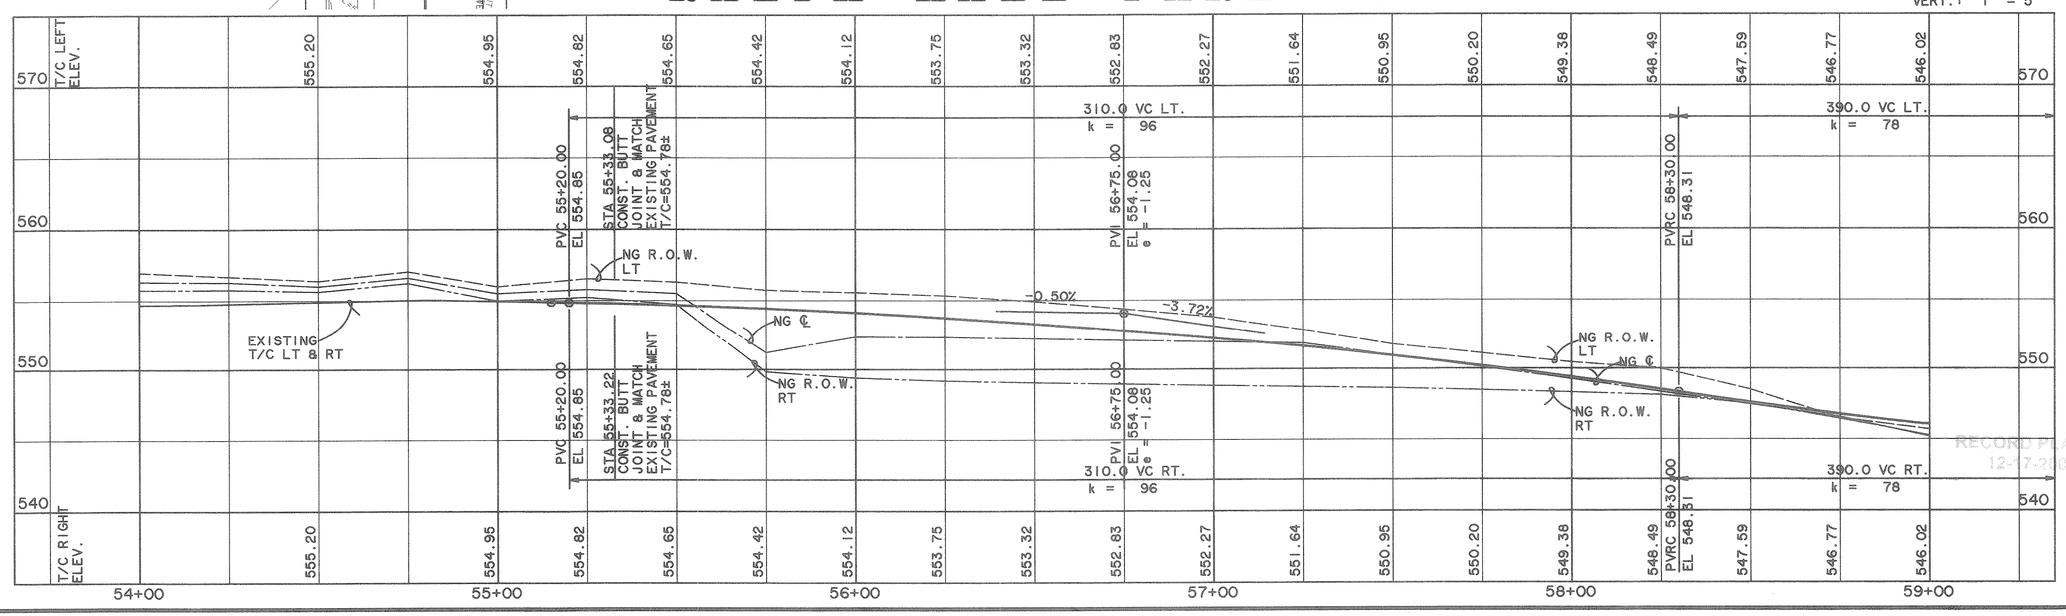

PREPARED BY:
WIER & ASSOCIATES, INC.
ENGINEERS SURVEYORS LAND PLANNERS
4300 BELTWAY PLACE SUITE 130 ARLINGTON, TEXAS 76018 METRO (817)467-7700
4108 AMON CARTER BLVD. SUITE 200 FORT WORTH, TEXAS 76155 METRO (817)355-9457

RALPH HALL PARKWAY
PAVING PLAN & PROFILE
STA 54+00 TO 59+00

STATE OF TEXAS
ULYS LANE III
40864
REGISTERED PROFESSIONAL ENGINEER
2-13-01

RECORD PLANS
12-17-2002

COPYRIGHT © WIER & ASSOCIATES, INC.
LAST SHEET EDIT DATE 02-09-2001
WA# 97057

SHEET NO.
5

FILE: PAVE25.dwg
TIME 16:40