NOTES

1. ALL WATER LINES TO BE CLASS 200
2. NO SERVICES TO CONNECT TO THIS SANITARY SEWER LINE DUE TO THE DEPTH OF 10' AND DEEPER
3. INSTALL GREEN EMS DISKS ON THE SEWER LINE AT EVERY CHANGE IN DIRECTION, MANHOLE, CLEANOUT, SERVICE, AND 200' (IN STRAIGHT LINES).
4. INSTALL BLUE EMS DISKS ON THE WATER LINE AT EVERY CHANGE IN DIRECTION, VALVE, SERVICE, AND EVERY 200' (IN STRAIGHT LINES).
5. CONTRACTOR IS RESPONSIBLE FOR LOCATION OF ALL EXISTING UTILITIES AND FOR ANY RELOCATIONS, DAMAGES, OR REPAIRS OF SAID EXISTING UTILITIES. EXISTING UTILITIES ON PLANS ARE APPROXIMATE.
6. USE CITY OF ROCKWALL STANDARD DETAILS AND NCTCOG DETAILS, AS MODIFIED BY CITY.

1" = 50'

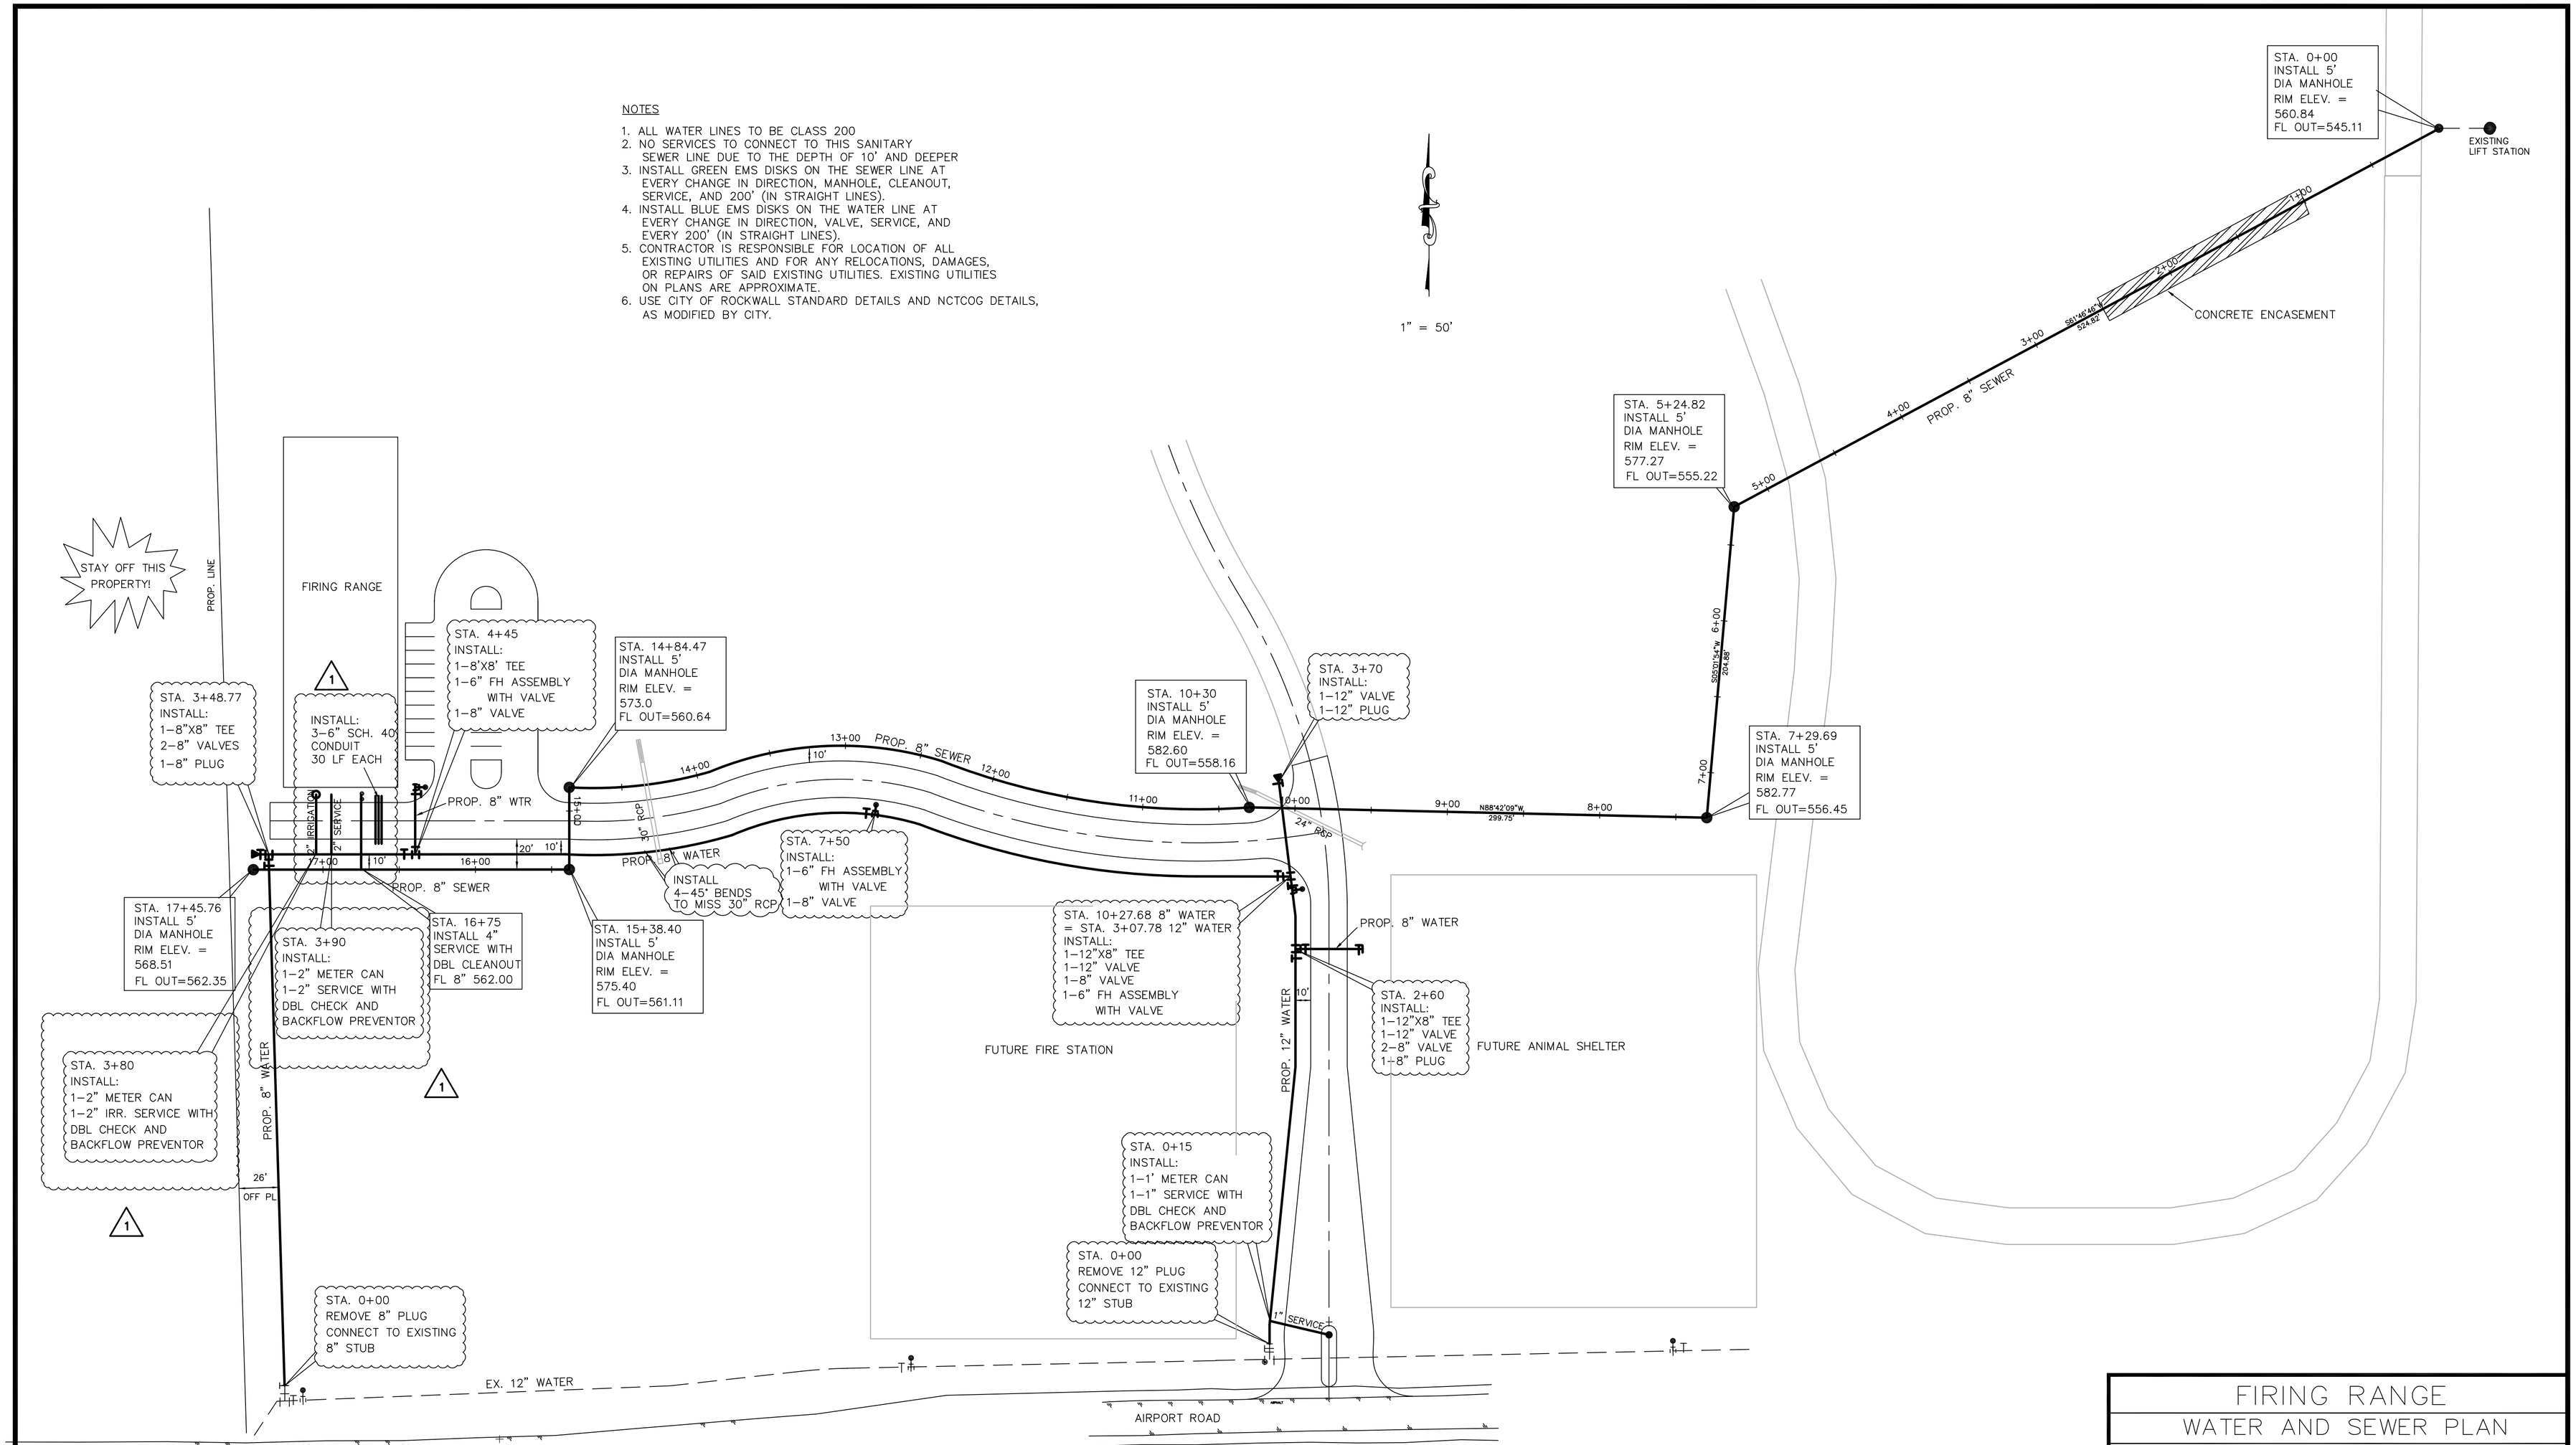

AS-BUILTS

REVISION NO.	REMARKS	DATE
1	CHGD. SERVICES AND ADDED CONDUIT	7/31/06

FIRING RANGE

WATER AND SEWER PLAN

ROCKWALL, TEXAS

CITY OF ROCKWALL

"THE NEW HORIZON"

DESIGNED: A.J.W.	THE SEAL APPEARING ON THIS DOCUMENT WAS AUTHORIZED BY CHARLES A. TODD TEXAS P.E. NO. 55647 ON	
DRAWN: ACAD		
JOB NO.	DATE: 7/06	SHEET NO.

STATE OF TEXAS
CHARLES A. TODD
55647
REGISTERED
PROFESSIONAL ENGINEER