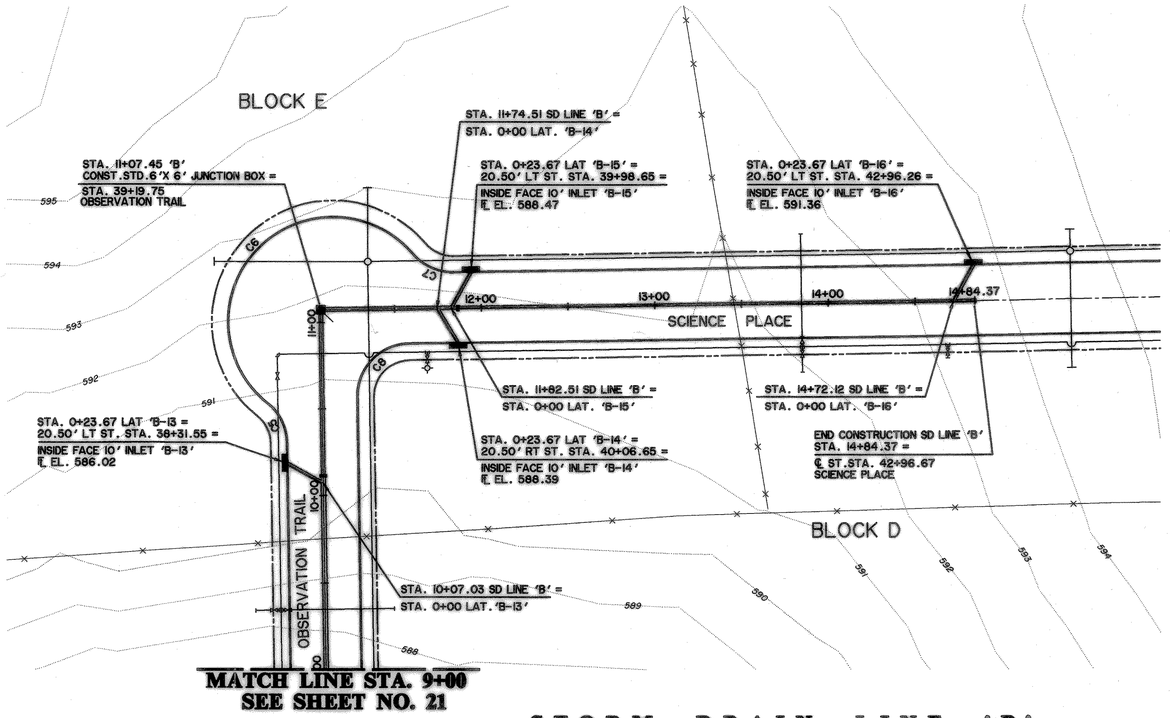

BENCHMARKS:

CITY MON. NO. 2
LOCATED ON THE NORTHWEST CORNER OF THE BRIDGE @ I-30 AND F.M. 549
ELEVATION 609.56

"□" CUT IN THE CENTER OF A 4 FOOT HEADWALL LOCATED AT THE NORTHEAST CORNER OF F.M. 549 AND STATE HIGHWAY 276
ELEVATION 592.75

STORM DRAIN LINE 'B'

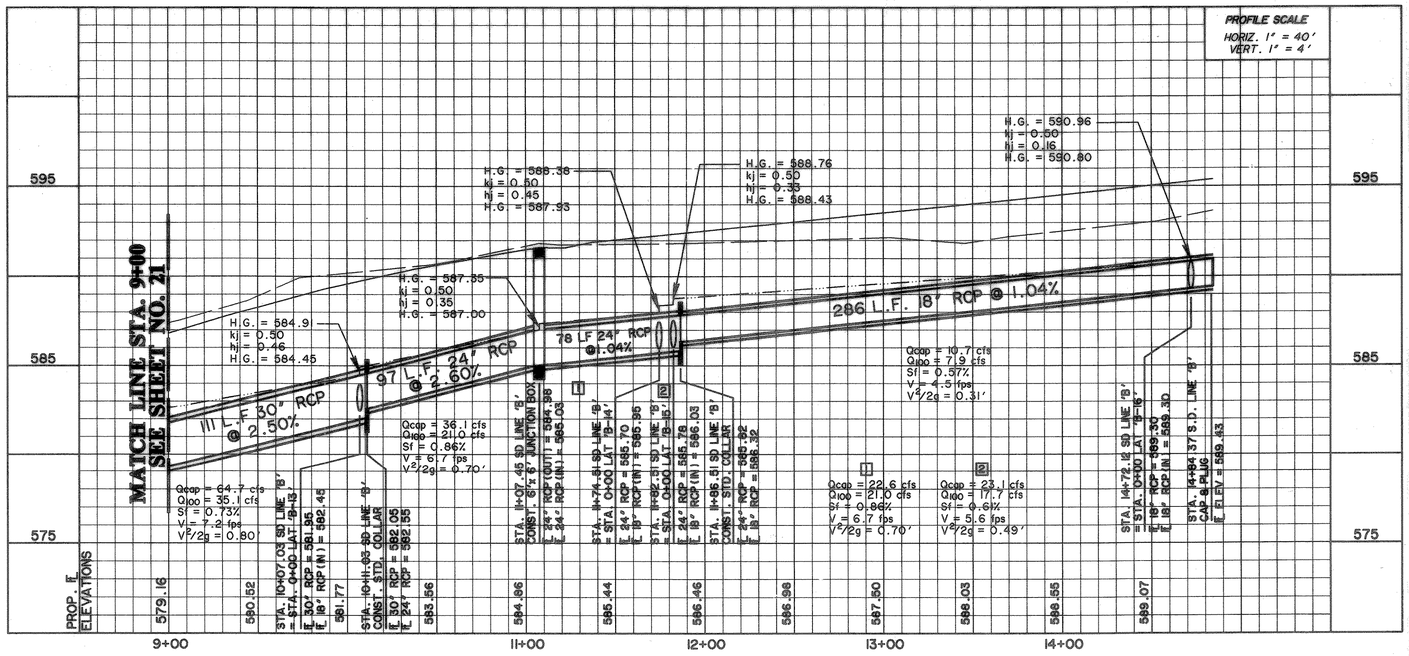

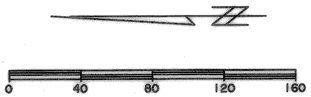

RECORD DRAWINGS

These as-built or record drawings (or corrected specifications) have been prepared, in part, on the basis of information compiled and furnished by others. The Engineer will not be responsible for any errors or omissions which have been incorporated into this document as a result.

PREPARED BY:
WIER & ASSOCIATES, INC.
ENGINEERS SURVEYORS LAND PLANNERS
4300 BELTWAY PLACE, SUITE 130, ARLINGTON, TEXAS 76018 METRO (817)467-7700
4106 MON CARTER BLVD. SUITE 200 FORT WORTH, TEXAS 76155 METRO (817)355-4637

ROCKWALL TECHNOLOGY PARK

STORM DRAIN LINE B
PLAN & PROFILE
STA. 9+00 TO STA. 14+84.37

STATE OF TEXAS
RONALD RAMIREZ
81821
REGISTERED
PROFESSIONAL ENGINEER
3/10/99

COPYRIGHT © WIER & ASSOCIATES, INC.
LAST SHEET EDIT
DATE 03-10-99
WA# 98041
SHEET NO. 22

ISSUED FOR CONSTRUCTION 4-15-99

TIME: 11:38 FILE: SDBPP2.dwg