



TIME: 17.16 FILE: waterA2.dwg

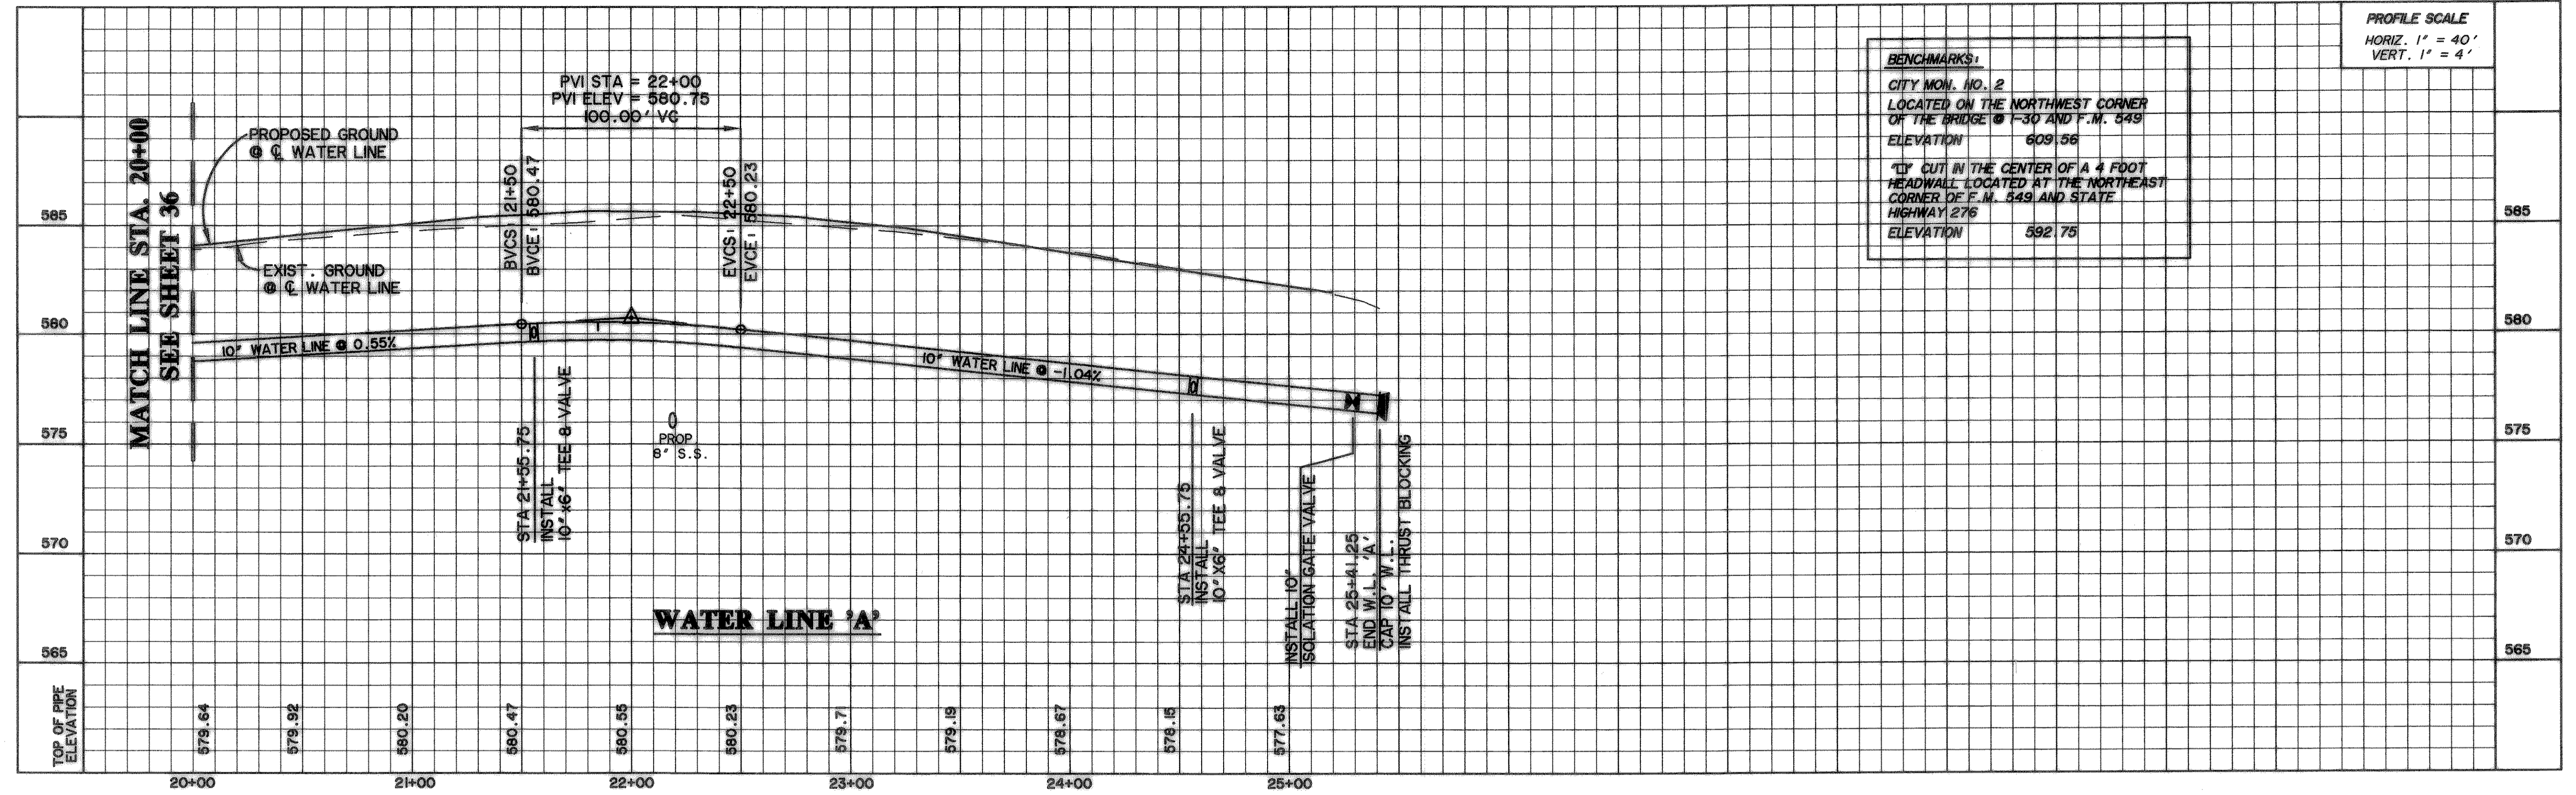

BENCHMARKS:
CITY MON. NO. 2
LOCATED ON THE NORTHWEST CORNER
ELEVATION 609.56
"D" CUT IN THE CENTER OF A 4 FOOT
HEADWALL LOCATED AT THE NORTHEAST
HIGHWAY 276
ELEVATION 592.75


PROFILE SCALE
HORIZ. 1" = 40'
VERT. 1" = 4'

WATER LINES 'A' & 'D'

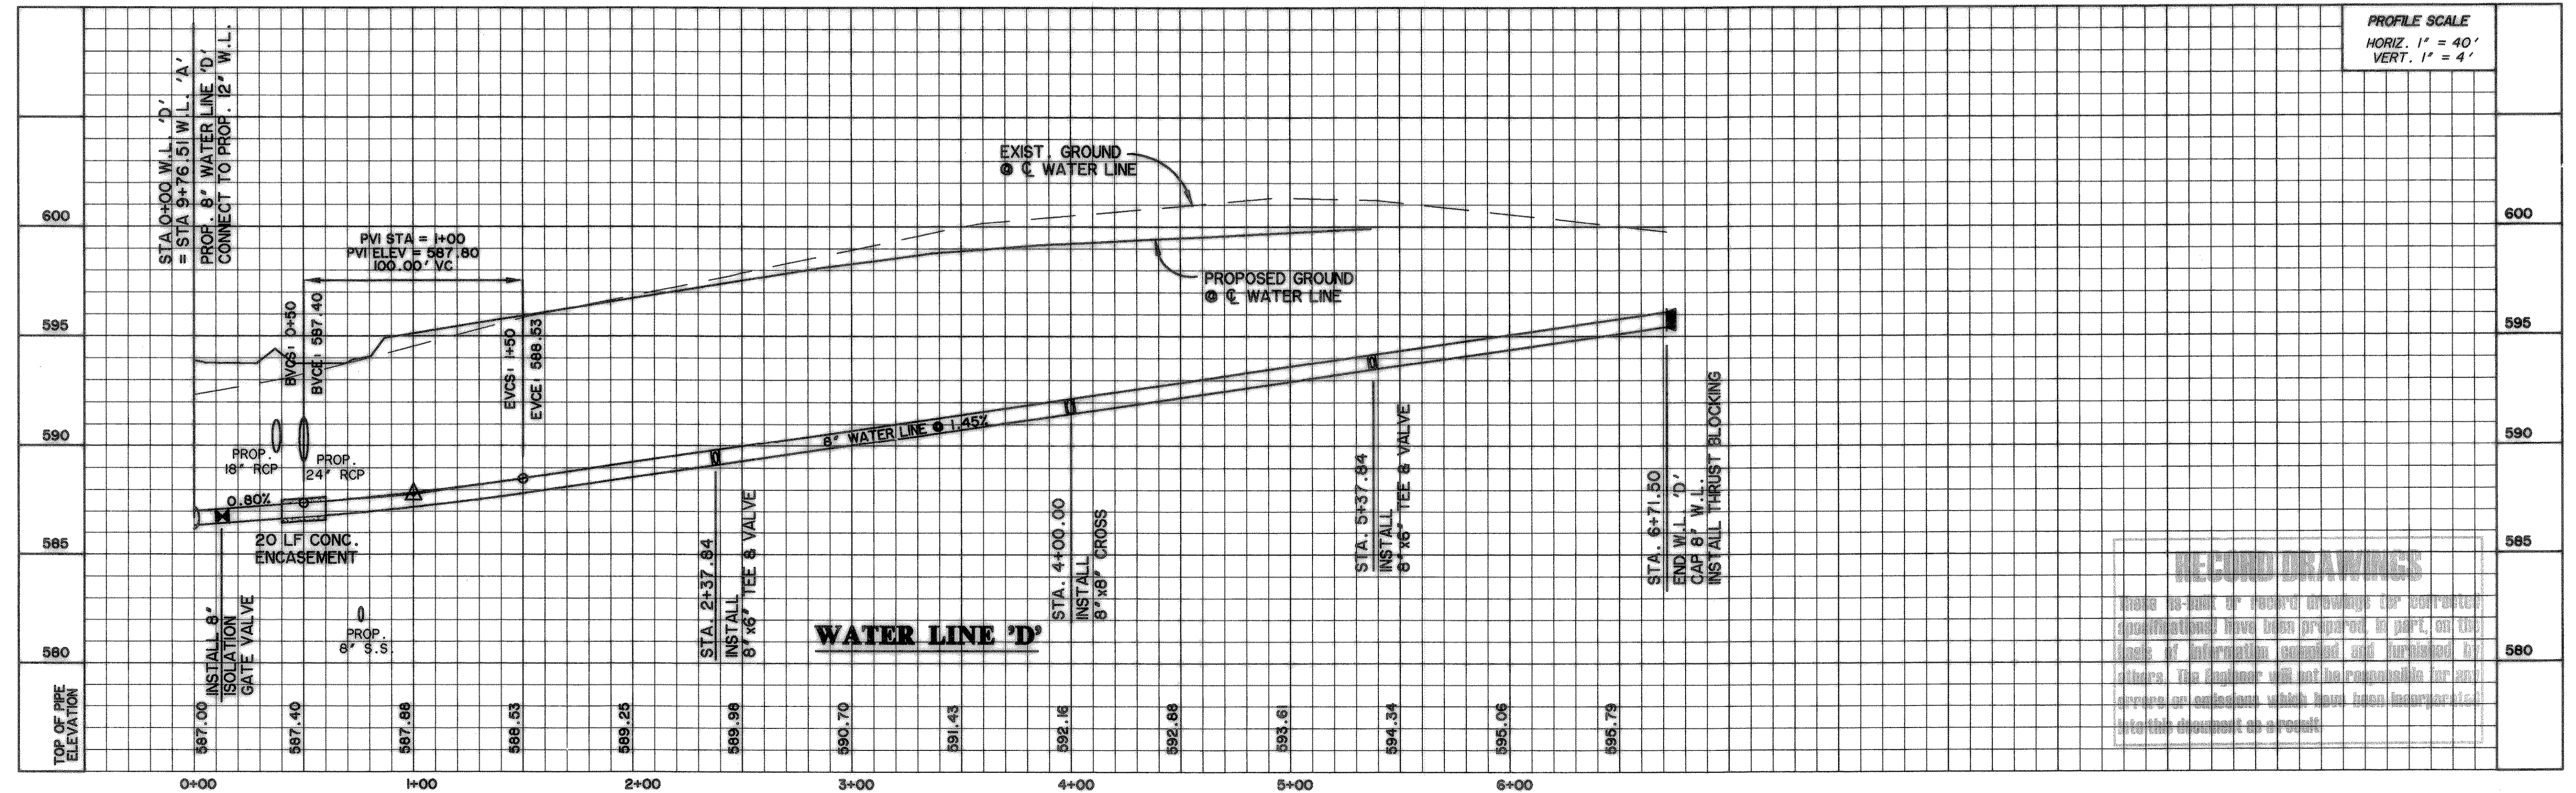



PREPARED BY:
WIER & ASSOCIATES, INC.
ENGINEERS SURVEYORS LAND PLANNERS
4300 BELWAY PLACE SUITE 130 ARLINGTON, TEXAS 76010 METRO (817)467-7700
4108 AMN CREEK BLVD. SUITE 200 FORT WORTH, TEXAS 76155 METRO (817)355-4437

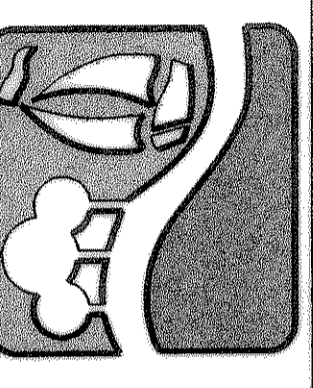

ROCKWALL TECHNOLOGY PARK

WATER LINE PROFILES
STA. 20+00 TO STA. 25+41.24
STA. 0+00 TO STA. 6+71.50

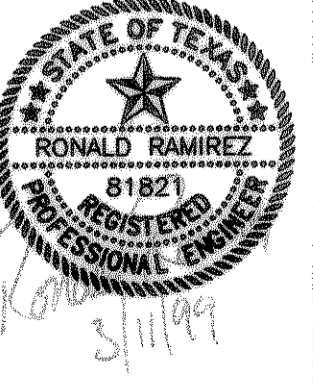

COPYRIGHT ©
WIER & ASSOCIATES, INC.
LAST SHEET EDIT
DATE: 05-10-99
WA# 98041
SHEET NO. 37