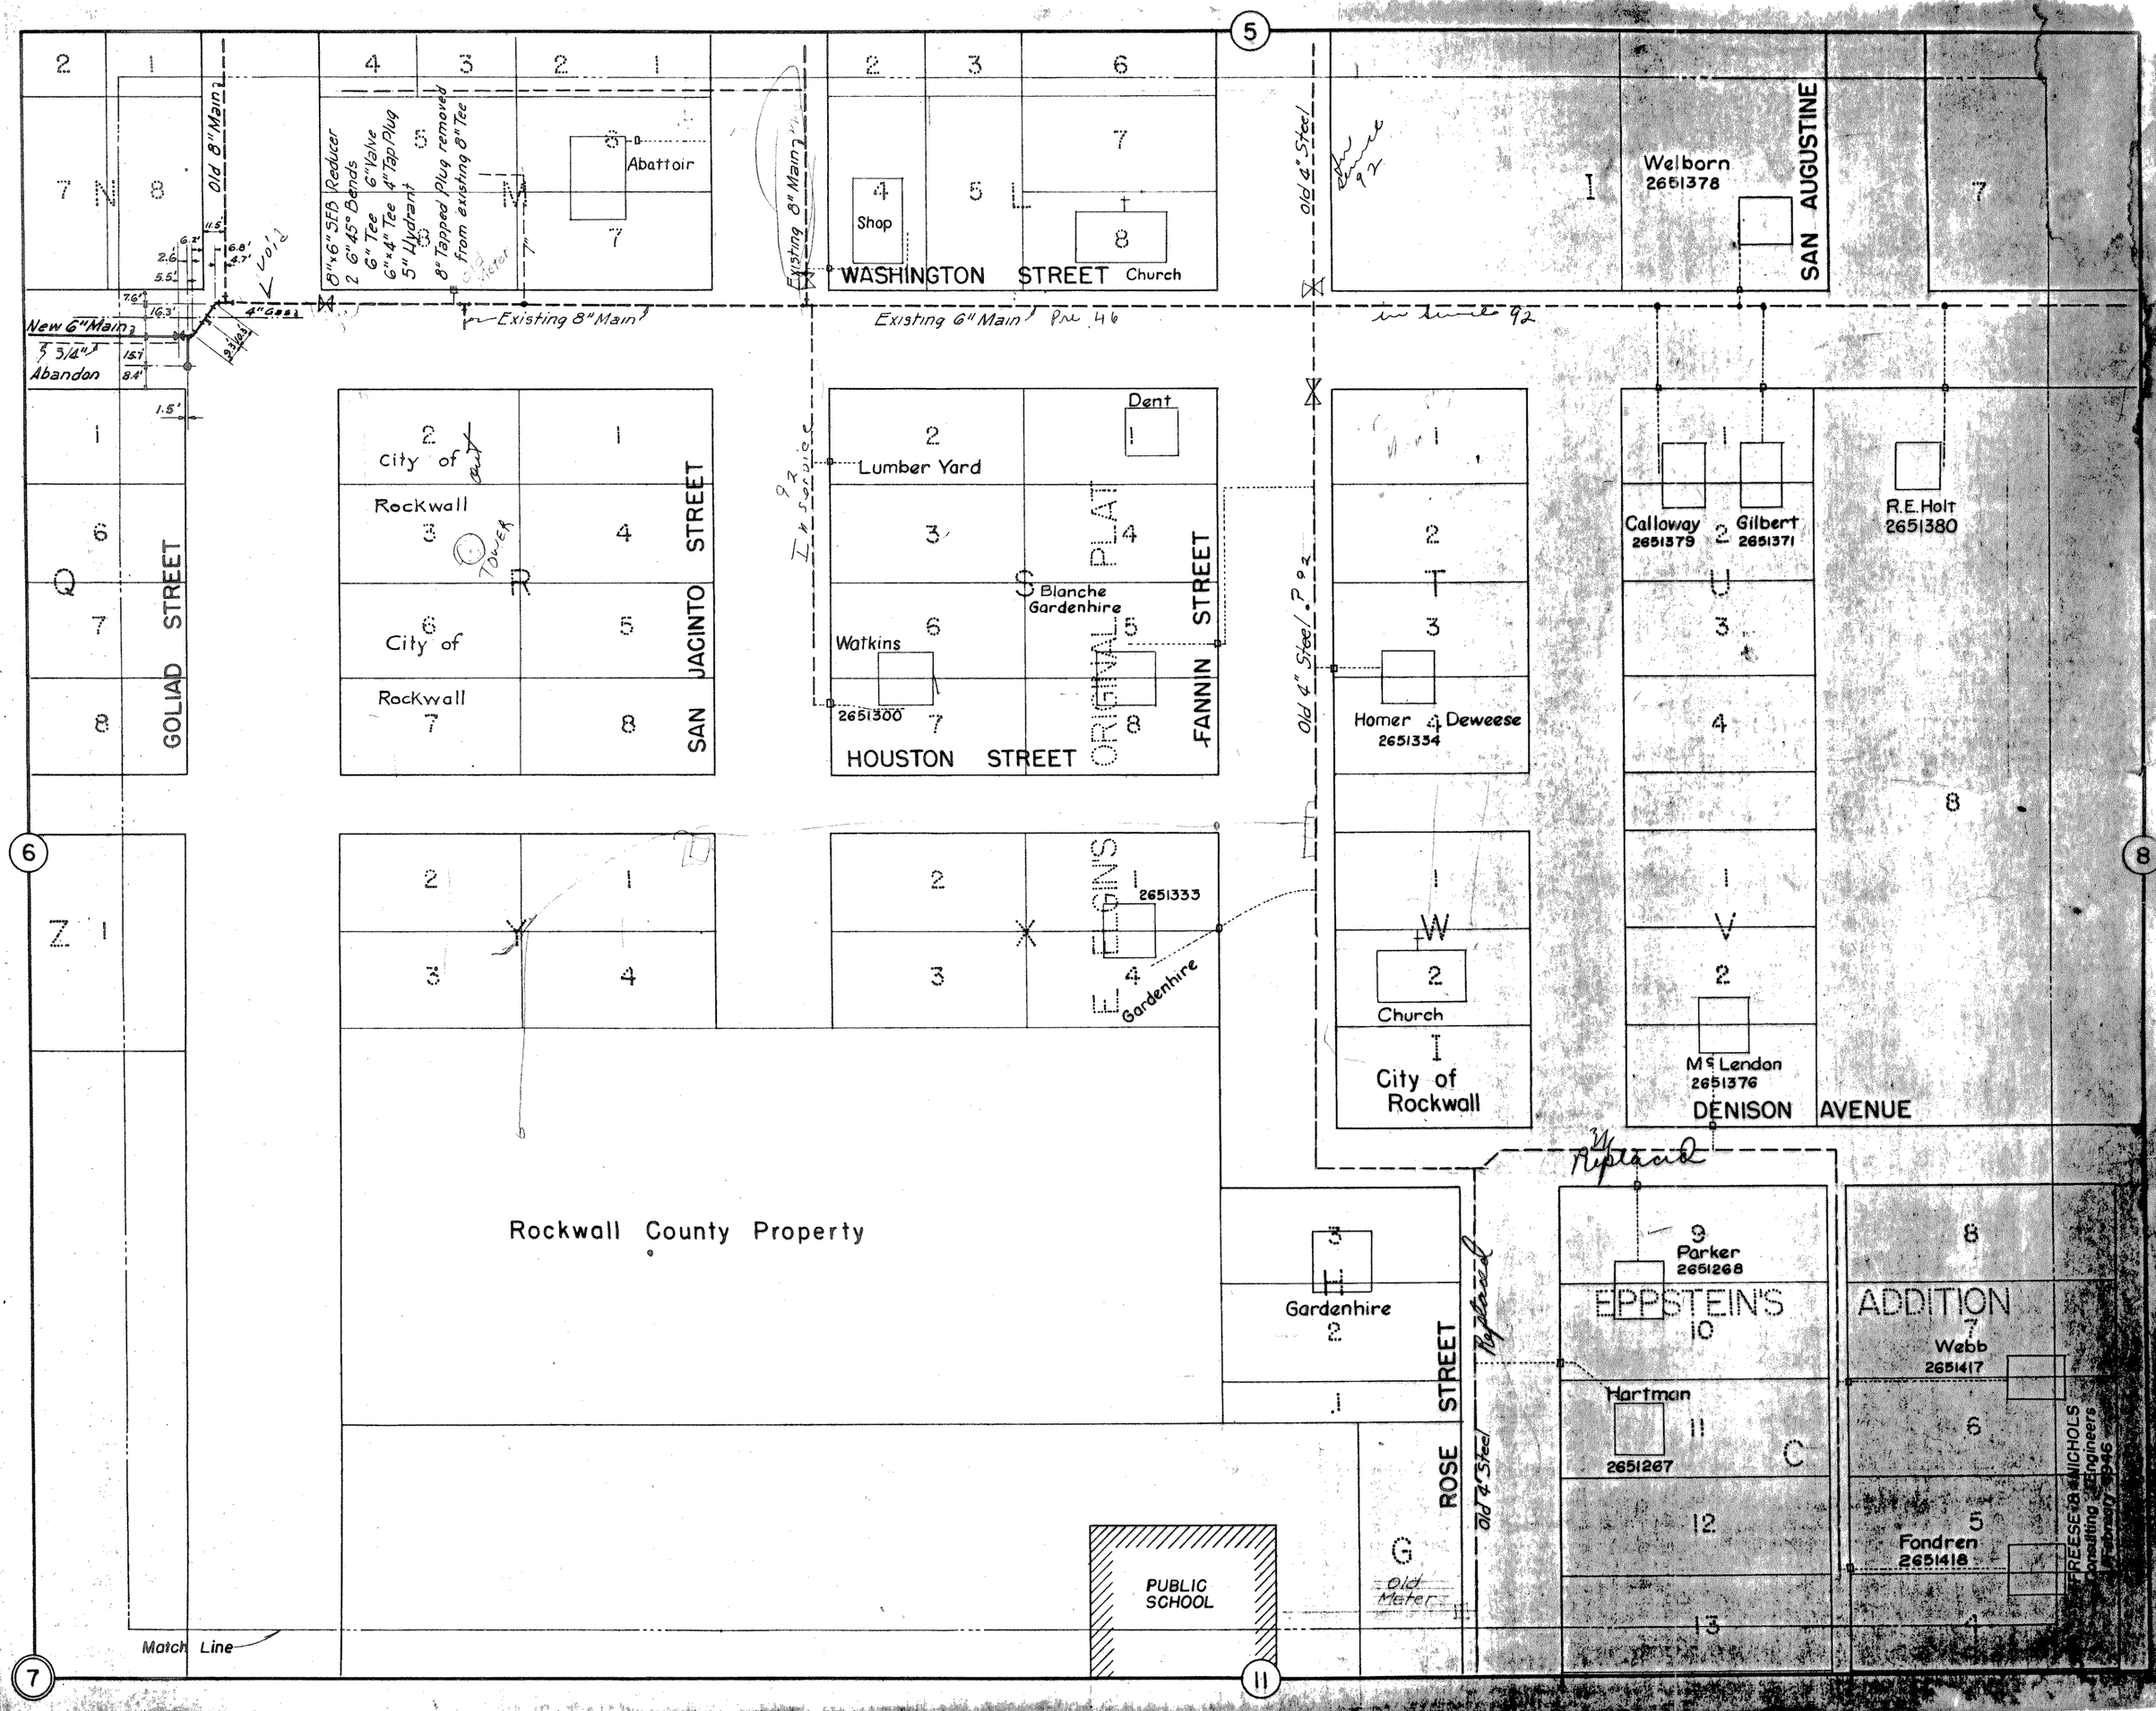

5
6
7
8
11
Old 8" Main
8"x6" SFB Reducer
2 6" 45° Bends
6" Tee
6"x4" Tee
5" Hydrant
6" Valve
4" Tap Plug
8" Tapped Plug removed from existing 8" Tee
Abattoir
Existing 8" Main
Existing 8" Main
Shop
WASHINGTON STREET
Church
Old 4" Steel
Welborn
2651378
SAN AUGUSTINE
New 6" Main
3/4" Abandon
4" Gas
Existing 6" Main
Pre 46
in service 92
City of Rockwall
Tower
SAN JACINTO STREET
Lumber Yard
Dent
Blanche Gardenhire
Watkins
2651300
HOUSTON STREET
ORIGINAL PLAT
FANNIN STREET
Old 4" Steel
Homer Deweese
2651334
Calloway
2651379
Gilbert
2651371
R.E. Holt
2651380
GOLIAD STREET
ELGIN'S
2651333
Gardenhire
Church
City of Rockwall
McLendon
2651376
DENISON AVENUE
Rockwall County Property
Gardenhire
ROSE STREET
Old 4" Steel
Replaced
Parker
2651268
EPPSTEIN'S
ADDITION
Webb
2651417
Hartman
2651267
Fondren
2651418
PUBLIC SCHOOL
Old Meter
Match Line
FREESE & NICHOLS
Consulting Engineers
February 1946