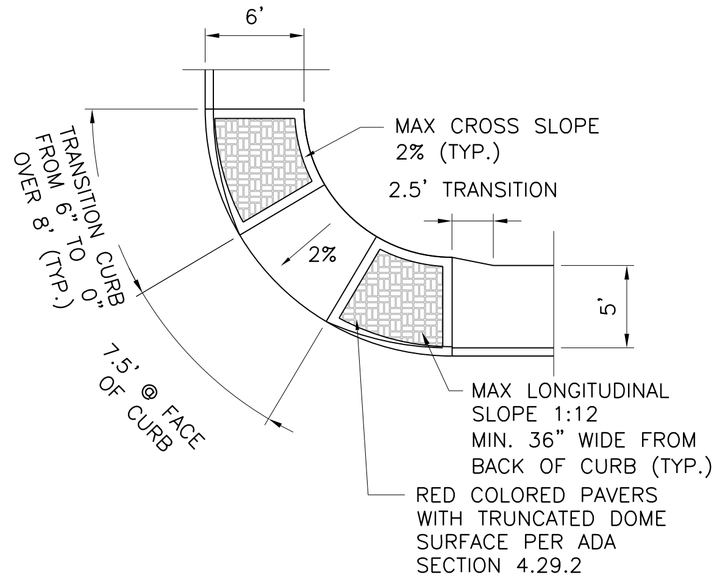

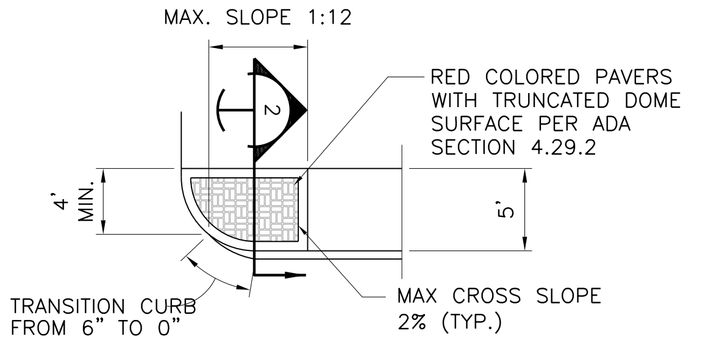

NOTE:
CONCRETE PAVER UNITS SHALL MEET ALL REQUIREMENTS OF ASTM C-936 AND C-33.

1 HANDICAP RAMP DEAILS
NOT TO SCALE

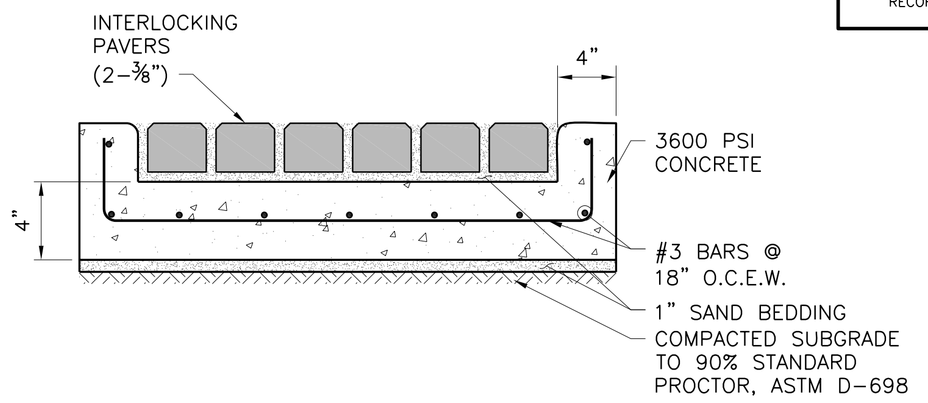

2 BARRIER FREE RAMP SECTION
NOT TO SCALE

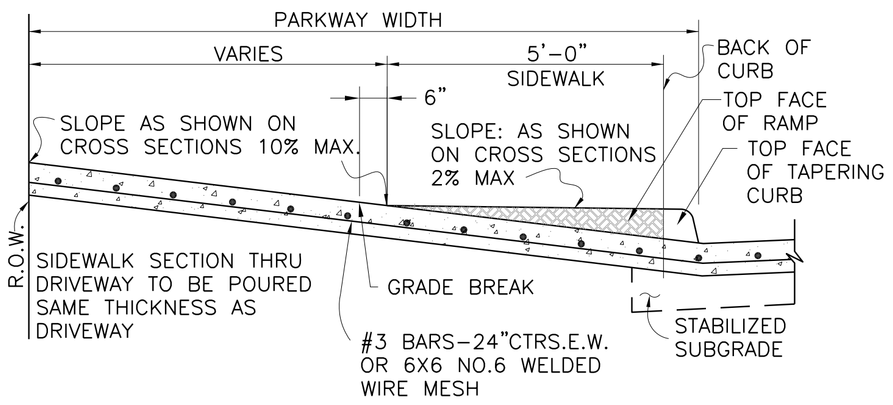

SECTION (A-A)

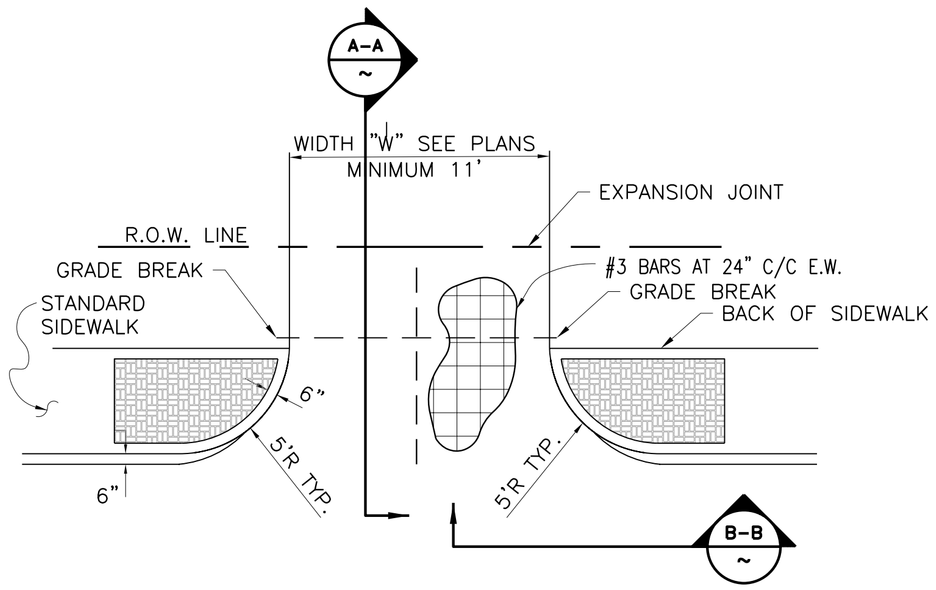

PLAN VIEW

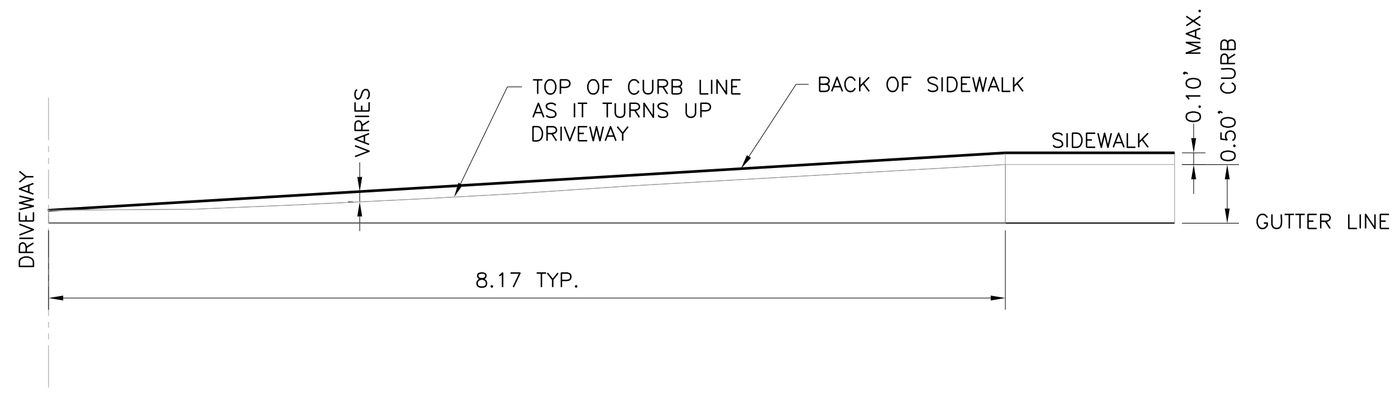

SECTION (B-B)

3 DRIVEWAY LAYOUT
NOT TO SCALE

This Record Drawing is a combination of the sealed engineering contract drawings for this project, modified by information furnished by the contractor reflecting changes in the Project made during construction. The original sealed drawings are on file at the offices of
FREESE AND NICHOLS, INC.
4055 INTERNATIONAL PLAZA, SUITE 200
FORT WORTH, TEXAS 76109-4895
(817) 735-7300
RECORD DRAWINGS PREPARED ON:
7/13/2007

THE SEAL THAT ORIGINALLY APPEARED ON THIS DOCUMENT WAS AUTHORIZED BY TED B. SKIPPER, P.E. 82977 ON 6/23/2006. IT IS A VIOLATION OF THE DEFILED DOCUMENT WITHOUT PROPER ALTERATION OF THE DEFILED DOCUMENT WITHOUT PROPER NOTIFICATION OF THE ENGINEER. ANY ALTERATION IS AN OFFENSE UNDER THE TEXAS ENGINEERING PRACTICE ACT

Freese and Nichols
1701 N. Market Street, Suite 500, LB 51
Dallas, Texas 75202-2011
Phone - (214) 920-2500
Fax - (214) 920-2565

CITY OF ROCKWALL, TEXAS
ROSS STREET REHABILITATION
AND DRAINAGE IMPROVEMENTS
CIVIL

ACCESSIBILITY DETAILS

F&N JOB NO.	ROK05274
DATE	3/01/2006
DESIGNED	RAW
DRAWN	LMW
REVISED	NO
CHECKED	RAW
FILE NAME	CV-ROK-DT-REV01.dwg

NO.	ISSUE	BY	DATE
1	ADA REVISIONS	TBS	6/23/06

VERIFY SCALE Bar is one inch on original drawing. If not one inch on this sheet, adjust scale.
0 1"

SHEET
DT-4.1
SEQ.

ACAD Rel 16.2s (LMS Tech) User: LMW
[ROK05274][DALSRV2]N:\IF\DRAWINGS\CV-ROK-DT-REV01.DWG LAYOUT: Layout1
Last Saved: 6/23/2006 3:33:23 PM XREFS: 0 PSLTS: 1
REFERENCE FILE: ..\..\STANDARD\34BORDER