ACAD Rel 16.2s (LMS Tech) User: RRC
[ROK05274][AUSTIN2]N:\IF\DRAWINGS\CV-ROK-PL-PHAS01.DWG LAYOUT: Layout1
DEC 21, 2005 5:16:48 P.M. LTS: 1.00 PSLTS: 1 TWIST: 359.2, 359.2
3 REFERENCE FILES: N:\IF\BASE\CV-ROK-PL-BASE, N:\IF\BASE\CV-ROK-PL-TOPO and N:\STANDARD\34BORDER

Date: Jul 16, 2007 - 3:59pm User: afm File: N:\Record\IF\CV-ROK-PL-PHAS01.dwg

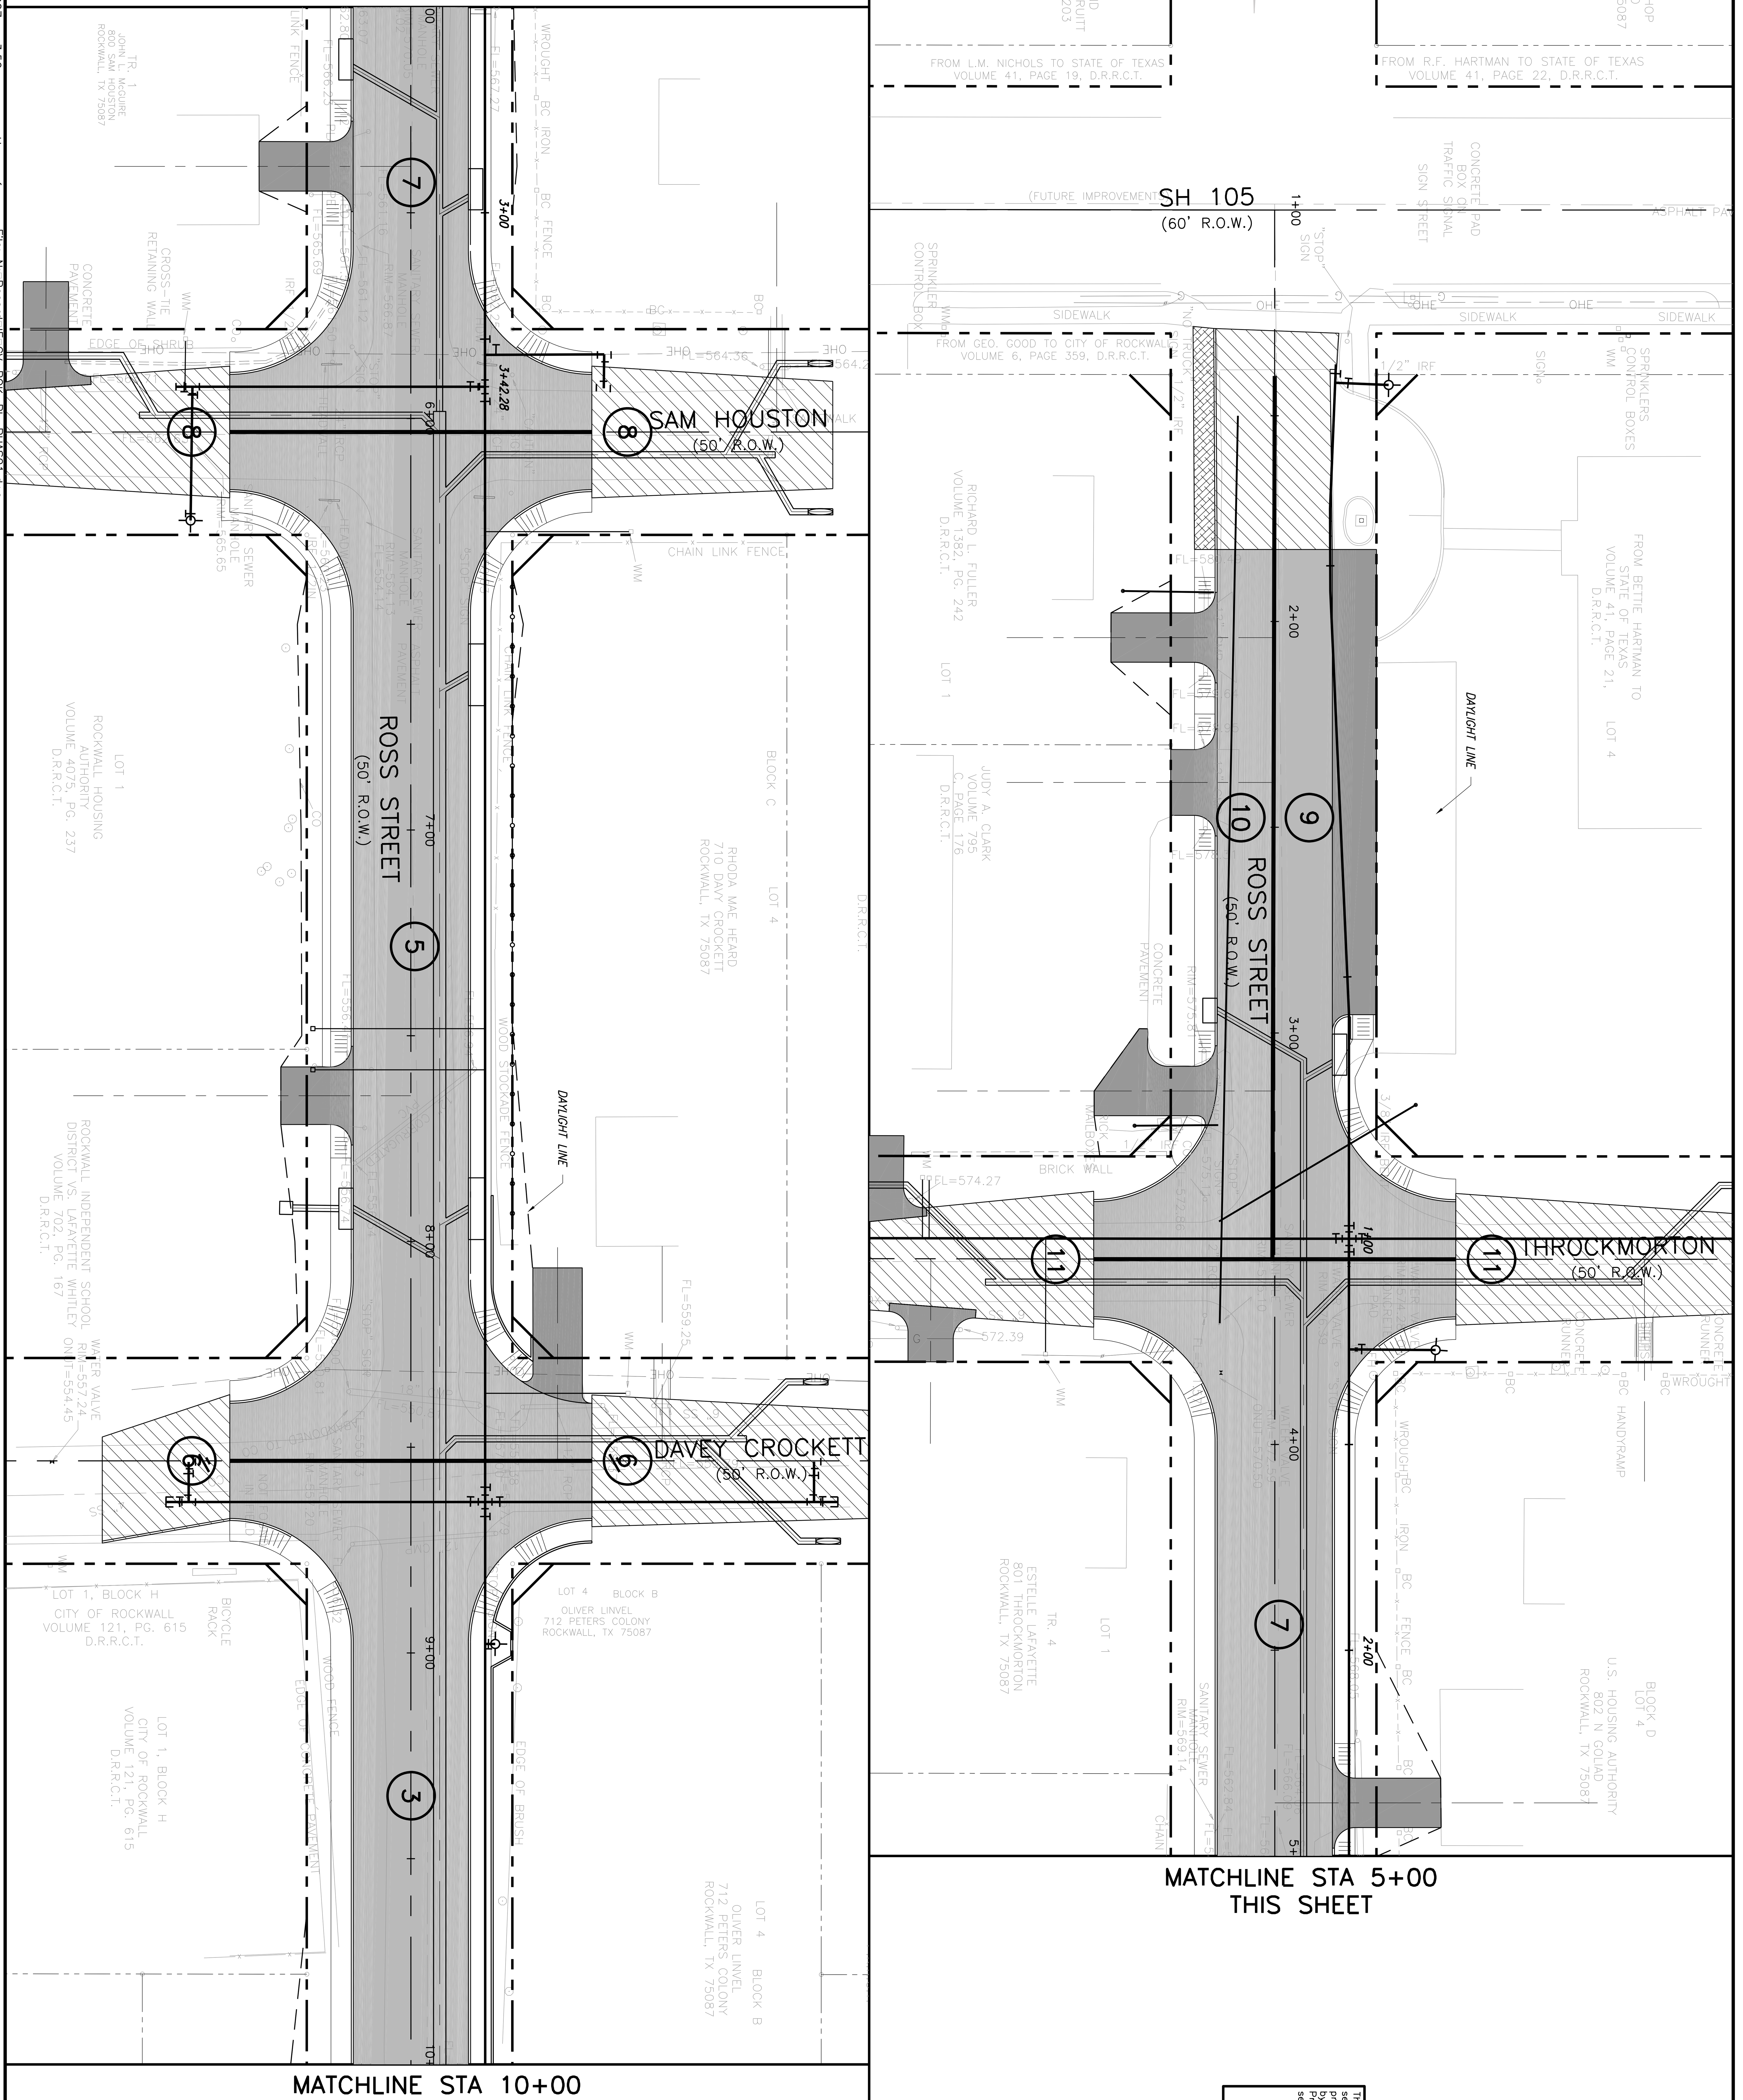

LEGEND

(#) PHASE NUMBER

This Record Drawing is a combination of the sealed engineering contract drawings for this project, modified by information furnished by the contractor reflecting changes in the Project made during construction. The original sealed drawings are on file at the offices of
FREESE AND NICHOLS, INC.
4055 INTERNATIONAL PLAZA, SUITE 200
FORT WORTH, TEXAS 76109-4895
(817) 735-7300
RECORD DRAWINGS PREPARED ON:
7/13/2007

SEE NOTES SHEET PH-2

SCALE IN FEET: 0 — 50' — 100'

N

SEQ.	SHEET	NO.	ISSUE	BY	DATE
	PH-1	1	PHASING REVISION	TBS	6/23/06

VERIFY SCALE 0 — 1. Bar is one inch on original drawing. If not one inch on this sheet, adjust scale.

F&N JOB NO. ROK05274
DATE 3/01/2006
DESIGNED TBS
DRAWN CLL
REVISED
CHECKED
FILE NAME CV-ROK-PL-PHAS01.dwg

CITY OF ROCKWALL, TEXAS
ROSS STREET REHABILITATION AND DRAINAGE IMPROVEMENTS
CIVIL
PROPOSED CONSTRUCTION PHASING PLAN

Freese and Nichols
1701 N. Market Street, Suite 500, LB 51
Dallas, Texas 75202-2001
Phone - (214) 920-2500
Fax - (214) 920-2565

THE SEAL THAT ORIGINALLY APPEARED ON THIS DOCUMENT WAS AUTHORIZED BY TED B. SUGG P.E., TEXAS NO: 82775 ON 7/13/2007. ALTERATION OF A SEALED DOCUMENT WITHOUT PROPER NOTIFICATION OF THE RESPONSIBLE ENGINEER IS AN OFFENSE UNDER THE TEXAS ENGINEERING PRACTICE ACT.