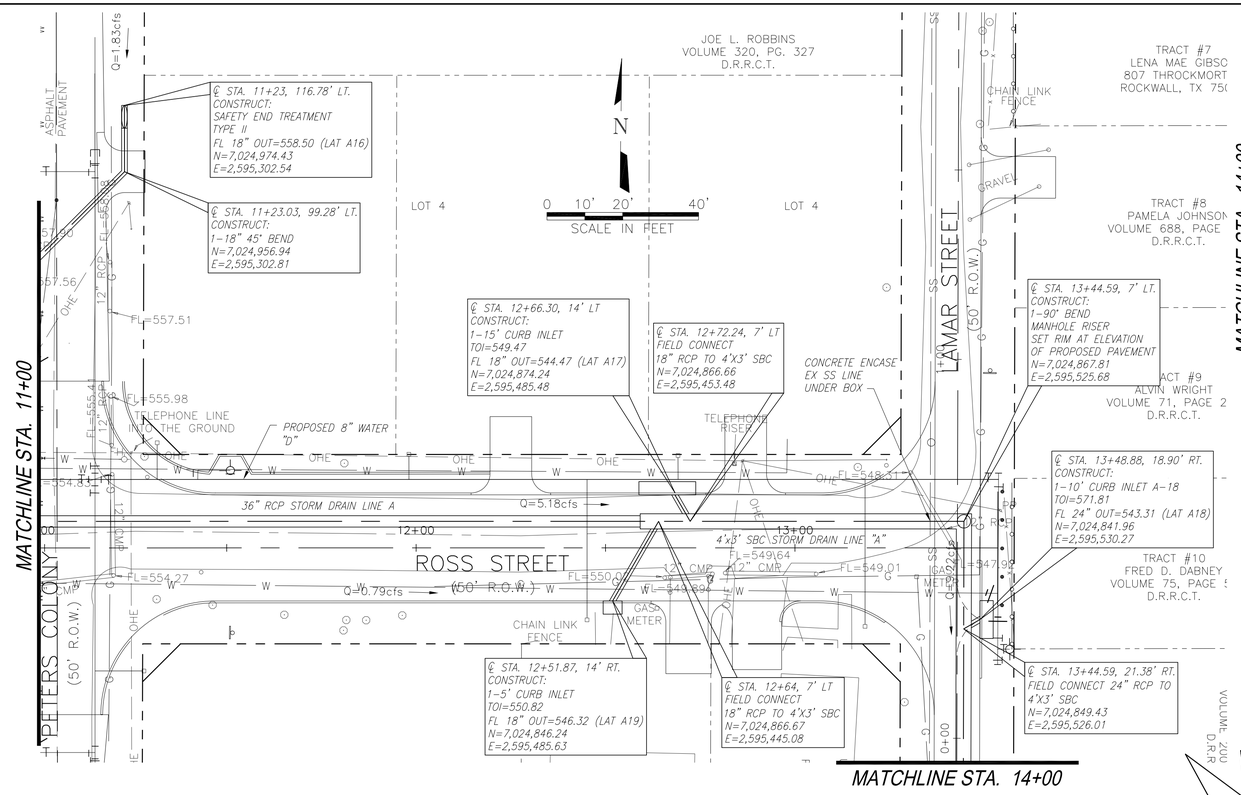

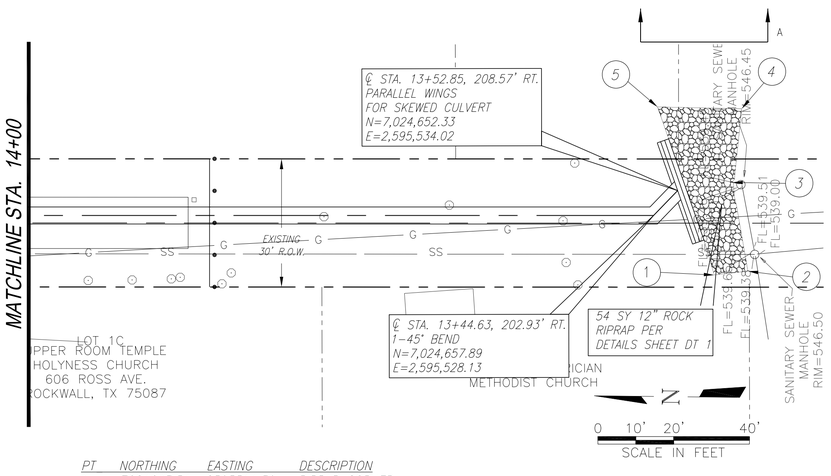

PT	NORTHING	EASTING	DESCRIPTION
1	7024643.54	2595514.39	RIPRAP CORNER
2	7024635.67	2595515.37	RIPRAP CORNER
3	7024639.56	2595536.11	RIPRAP CORNER
4	7024637.58	2595553.34	RIPRAP CORNER
5	7024657.28	2595553.54	RIPRAP CORNER

This Record Drawing is a combination of the sealed engineering contract drawings for this project, modified by information furnished by the contractor reflecting changes in the Project made during construction. The original sealed drawings are on file at the offices of

FREESE AND NICHOLS, INC.
4055 INTERNATIONAL PLAZA, SUITE 200
FORT WORTH, TEXAS 76109-4895
(817) 735-7300
RECORD DRAWINGS PREPARED ON:
7/13/2007

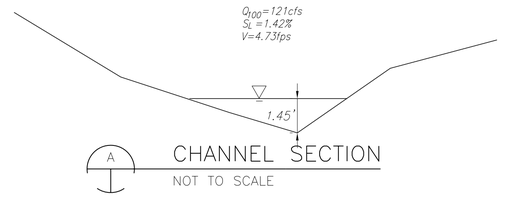

BENCHMARKS:

BM #1 CHISELED BOX CUT ON NORTHEAST CORNER OF 3'x6' CONCRETE SLAB FOR MAILBOXES LOCATED AT THE SOUTHWEST CORNER OF THE INTERSECTION OF ROSS AND THROCHMORTON, 30' SOUTH OF ROSS. ELEV=577.28

BM #2 RAILROAD SPIKE IN WEST SIDE OF POWER POLE, APPROX. 1 FOOT ABOVE NATURAL GROUND, LOCATED AT THE NORTH EAST CORNER OF THE INTERSECTION OF ROSS AND PETERS COLONY, APPROX. 25' EAST OF PETERS COLONY AND 25' NORTH OF ROSS STREET. ELEV=558.27

BM #3 CHISELED BOX CUT IN CENTER OF 12' CURB INLET LOCATED ON THE NORTH SIDE OF BOURN, APPROX. 200' EAST OF PETERS COLONY AND 25' NORTH OF THE CENTERLINE OF BOURN. ELEV=547.30

BM #4 CHISELED BOX CUT ON SOUTHEAST CORNER OF A 4'x4' DROP INLET LOCATED ON THE WEST SIDE OF THROCKMORTON, APPROX. 50' NORTH OF BOURN. 575.30

CAUTION!!!
EXISTING GAS MAIN, FIBER OPTIC LINES AND OVERHEAD ELECTRIC LINES IN AREA CONTRUCTOR TO LOCATE PRIOR TO CONSTRUCTION AND COODINATE ANY REQUIRED RELOCATION

NOTE:

1. CONTRACTOR SHALL REFER TO TXDOT STANDARD PW FOR PARALLEL WINGS AT CULVERT OUTFALL.
2. CONTRACTOR SHALL REFER TO TXDOT STANDARD SET P-CD FOR SAFETY END TREATMENT DETAIL.

SCALE:
HORIZ: 1"=20'
VERT: 1"=4'

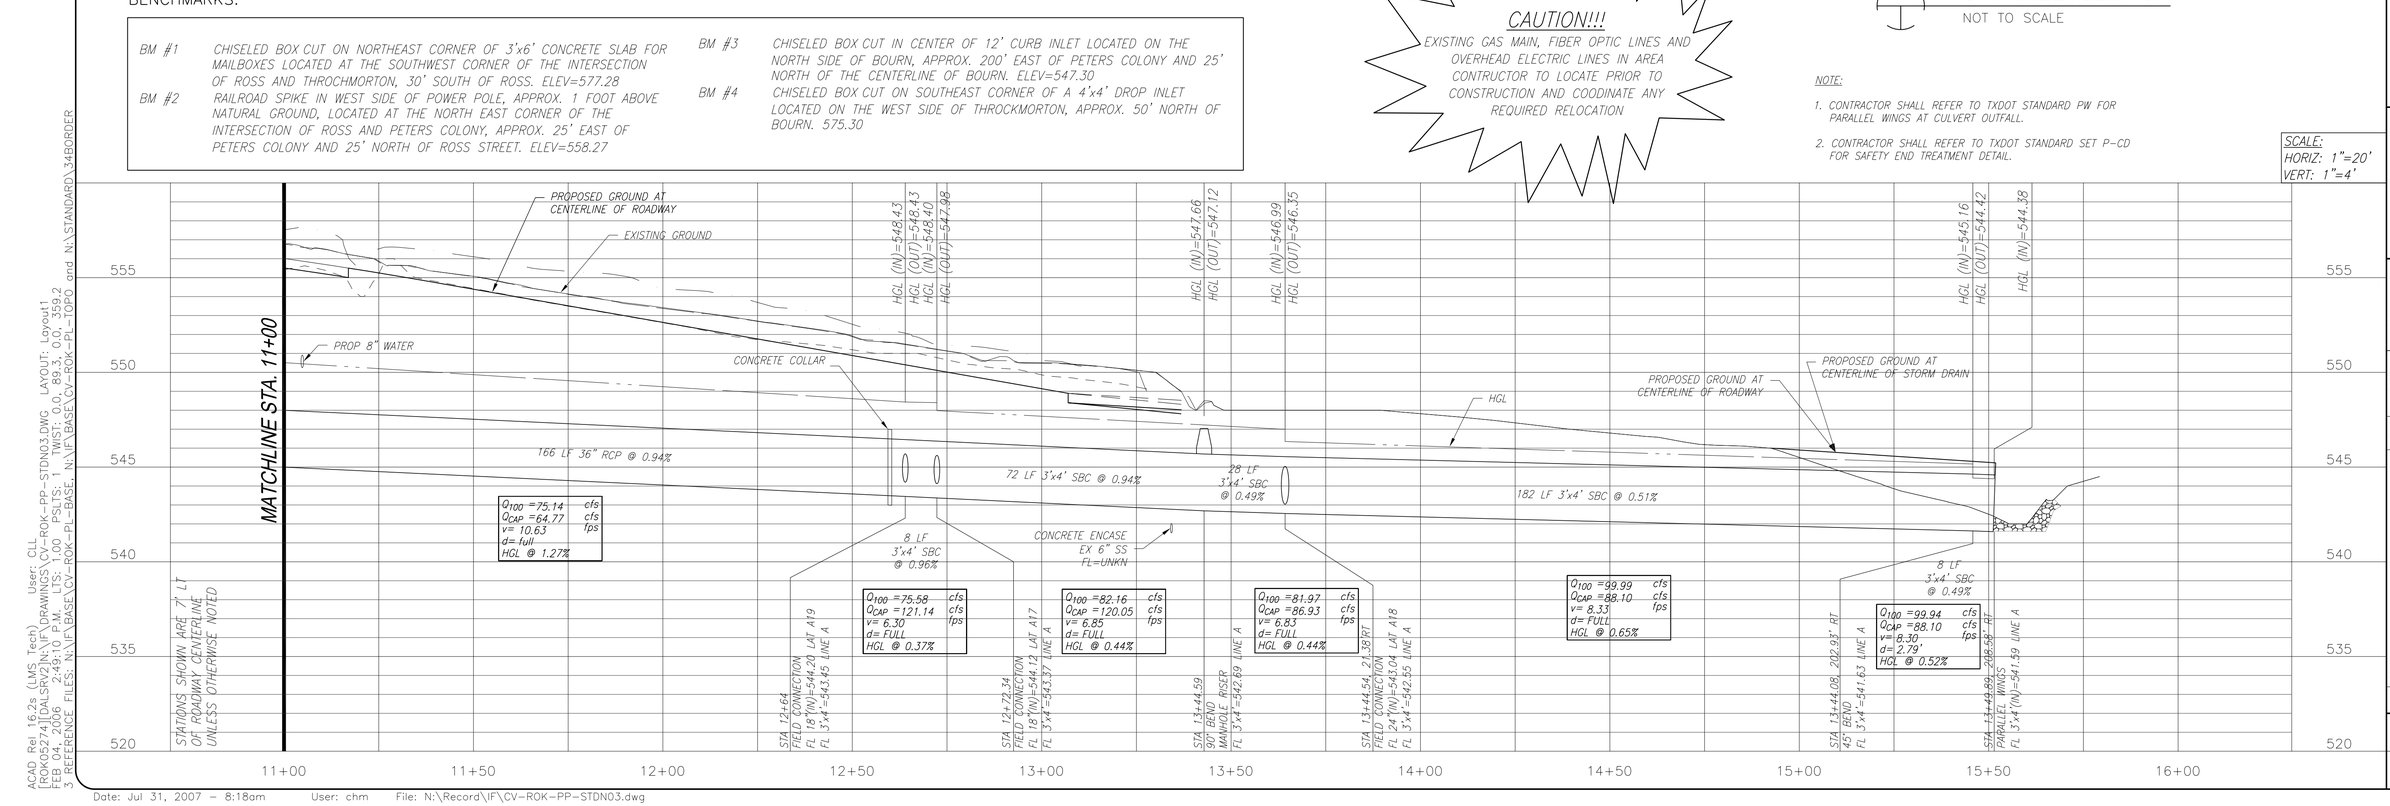

THE SEAL THAT APPEARED ON THIS DOCUMENT WAS AUTHORIZED BY JEE B. SCOTT, P.E. 43077 ON 7/13/2007
ALTERATION OF A SEALED DOCUMENT WITHOUT PROPER AUTHORITY IS PROHIBITED BY LAW AND ANY ALTERATION OFFENSE UNDER THE TEXAS ENGINEERING PRACTICE ACT

Freese and Nichols
1701 N. Market Street, Suite 500, LB 51
Dallas, Texas 75202-2011
Phone - (214) 920-2500
Fax - (214) 920-2565

CITY OF ROCKWALL, TEXAS

ROSS STREET REHABILITATION AND DRAINAGE IMPROVEMENTS

ROSS STREET STORM DRAIN STA. 9+00 TO END

F&N JOB NO. ROK05274
DATE 3/01/2006
DESIGNED RAW
DRAWN NO/EAM
REVISED NO
CHECKED RAW
FILE NAME CV-ROK-PP-STDN03.dwg

NO. ISSUE BY DATE

VERIFY SCALE Bar is one inch on original drawing. If not one inch on this sheet, adjust scale.
0 1"

SHEET C-9
SEQ.

ACAD Rel 16.2s (LMS Tech) User: CLL
[ROK05274]D:\DALSRV2]N:\IF\DRAWINGS\CV-ROK-PP-STDN03.DWG LAYOUT: Layout1
[ROK05274]Jul 31, 2006 - 2:49:11pm XREFS: 0 PSLTS: 1 WIDTH: 0.0, 89.3, 0.0, 359.2
REFERENCE FILES: N:\IF\BASE\CV-ROK-PLL-BASE; N:\IF\BASE\CV-ROK-PTL-TOPO and N:\STANDARD\34BORDER

Date: Jul 31, 2007 - 8:18am User: chm File: N:\Record\IF\CV-ROK-PP-STDN03.dwg