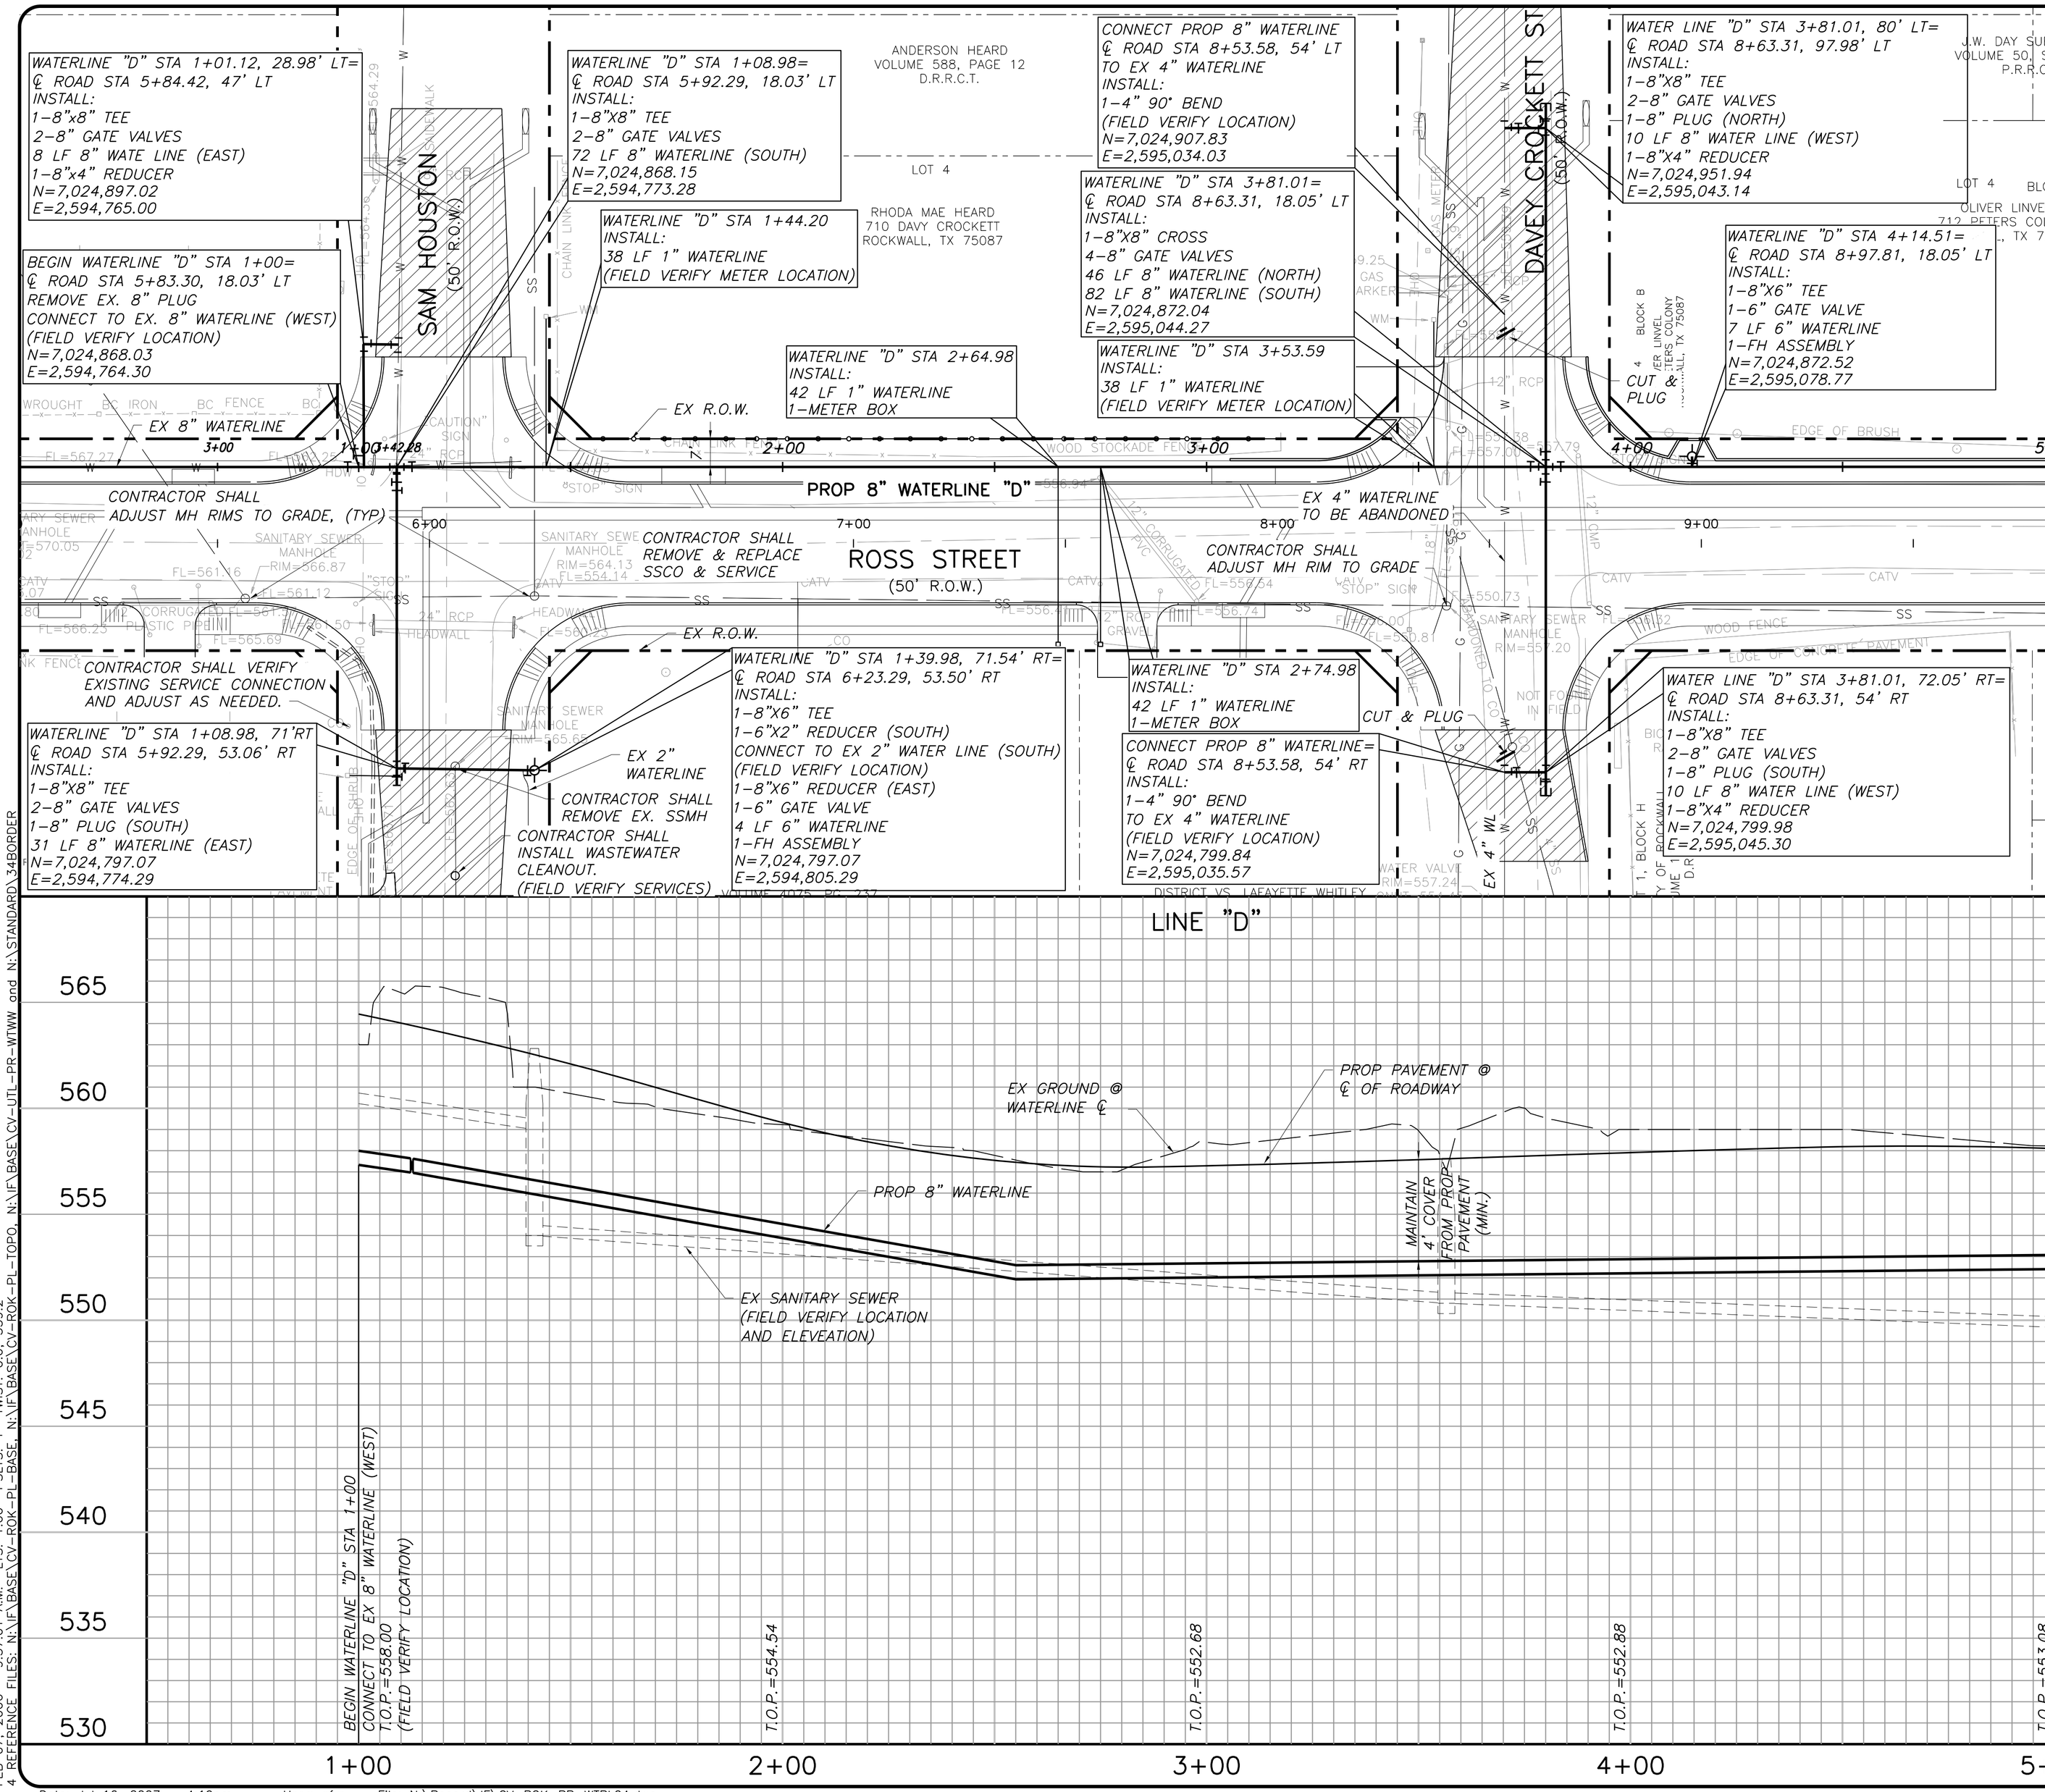

MATCHLINE STA 5+00
SEE SHEET WT-5

CAUTION!!!
EXISTING OVERHEAD AND UNDERGROUND UTILITIES IN AREA
CONTACT UTILITY 48 HOURS PRIOR TO CONSTRUCTION AT 1-800-344-8377 FOR LOCATION

N

0 10' 20' 40'
SCALE IN FEET

This Record Drawing is a combination of the sealed engineering contract drawings for this project, modified by information furnished by the contractor reflecting changes in the Project made during construction. The original sealed drawings are on file at the offices of
FREESE AND NICHOLS, INC.
4055 INTERNATIONAL PLAZA, SUITE 200
FORT WORTH, TEXAS 76109-4895
(817) 735-7300
RECORD DRAWINGS PREPARED ON:
7/13/2007

NOTE:

1. CONTRACTOR TO FIELD VERIFY ALL CONNECTIONS TO EXISTING WATER LINES.
2. CONTRACTOR SHALL PROVIDE A WATER SERVICE AND METER BOX FOR ALL LOTS ON THROCKMORTON ROSS ST, AND LAMAR FOR THE PROJECT LIMITS. CONTRACTOR SHALL FIELD VERIFY EXISTING SERVICE LOCATIONS FOR CORNER LOTS, THOSE WHICH GET SERVICE FROM BOURN OR BOYDSTON ARE NOT INCLUDED AS PART OF THIS PROJECT.
3. CONTRACTOR SHALL PROVIDE FUTURE SEWER SERVICE CONNECTIONS AND SET A CLEANOUT AT THE ROW LINE FOR ALL VACANT LOTS ON THROCKMORTON AND ROSS ST.
4. ALL WATER LINE CONNECTIONS SHALL BE RESTRAINED.
5. CONTRACTOR SHALL DEFLECT PROPOSED WATER AT 75% MAX MANUFACTURES DEFLECTION RECOMMENDATIONS TO AVOID PROPOSED INLETS.

BENCHMARKS:

BM #1 CHISELED BOX CUT ON NORTHEAST CORNER OF 3'x6' CONCRETE SLAB FOR MAILBOXES LOCATED AT THE SOUTHWEST CORNER OF THE INTERSECTION OF ROSS AND THROCHMORTON, 30' SOUTH OF ROSS. ELEV=577.28

BM #2 RAILROAD SPIKE IN WEST SIDE OF POWER POLE, APPROX. 1 FOOT ABOVE NATURAL GROUND, LOCATED AT THE NORTH EAST CORNER OF THE INTERSECTION OF ROSS AND PETERS COLONY, APPROX. 25' EAST OF PETERS COLONY AND 25' NORTH OF ROSS STREET. ELEV=558.27

BM #3 CHISELED BOX CUT IN CENTER OF 12' CURB INLET LOCATED ON THE NORTH SIDE OF OURN, APPROX. 200' EAST OF PETERS COLONY AND 25' NORTH OF THE CENTERLINE OF BOURN. ELEV=547.30

BM #4 CHISELED BOX CUT ON SOUTHEAST CORNER OF A 4'x4' DROP INLET LOCATED ON THE WEST SIDE OF THROCKMORTON, APPROX. 50' NORTH OF BOURN. ELEV=575.30

THE SEAL THAT ORIGINALLY APPEARED ON THIS DOCUMENT WAS AUTHORIZED BY REID B. SOPER, P.E. 65207. ALTERATION OF A SEALED DOCUMENT WITHOUT PROPER AUTHORIZATION IS A VIOLATION OF THE TEXAS BOARD OF PROFESSIONAL ENGINEERS OFFENSE UNDER THE TEXAS ENGINEERING PRACTICE ACT

Freese and Nichols
1701 N. Market Street, Suite 500, LB 51
Dallas, Texas 75202-2011
Phone - (214) 920-2500
Fax - (214) 920-2565

CITY OF ROCKWALL, TEXAS
ROSS STREET REHABILITATION
AND DRAINAGE IMPROVEMENTS
CIVIL
PROPOSED WATER LINE "D"
PLAN & PROFILE STA 1+00 TO 5+00

F&N JOB NO.	ROK05274
DATE	3/01/2006
DESIGNED	TBC
DRAWN	CLL
REVISED	
CHECKED	
FILE NAME	CV-ROK-PP-WTRL04.dwg

NO.	ISSUE	BY	DATE

VERIFY SCALE Bar is one inch on original drawing. If not one inch on this sheet, adjust scale.
0 1

SHEET WT-4
SEQ.

ACAD Rel 16.2s (LMS Tech) User: CLL
[ROK05274][DALSRV2]N:\IF\DRAWINGS\CV-ROK-PP-WTRL04.DWG LAYOUT: Layout1
Feb 2006 9:57:01 A.M. LTS: 00 PCPS: 1 TWIST: 0 339.2
4 REFERENCE FILES: N:\IF\BASE\CV-ROK-PL-BASE, N:\IF\BASE\CV-ROK-PL-TOPO, N:\IF\BASE\CV-UTL-PR-WTWW and N:\STANDARD\34BORDER
Date: Jul 16, 2007 - 4:19pm User: afm File: N:\Record\IF\CV-ROK-PP-WTRL04.dwg