ACAD Rel 16.2s (LMS Tech) User: CLL
[ROK05274][DALSRV2]N:\IF\DRAWINGS\CV-ROK-XS-SECT04.DWG LAYOUT: Layout1
FEB 13, 2006 5:51:39 P.M. LTS: 1 PSLTS: 1 TWIST: 0
3 REFERENCE FILES: N:\IF\BASE\CV-RDS-XS-ALLY, N:\IF\BASE\CV-ROK-PL-TOPO and N:\STANDARD\34BORDER

Date: Jul 16, 2007 - 4:28pm User: afm File: N:\Record\IF\CV-ROK-XS-SECT04.dwg

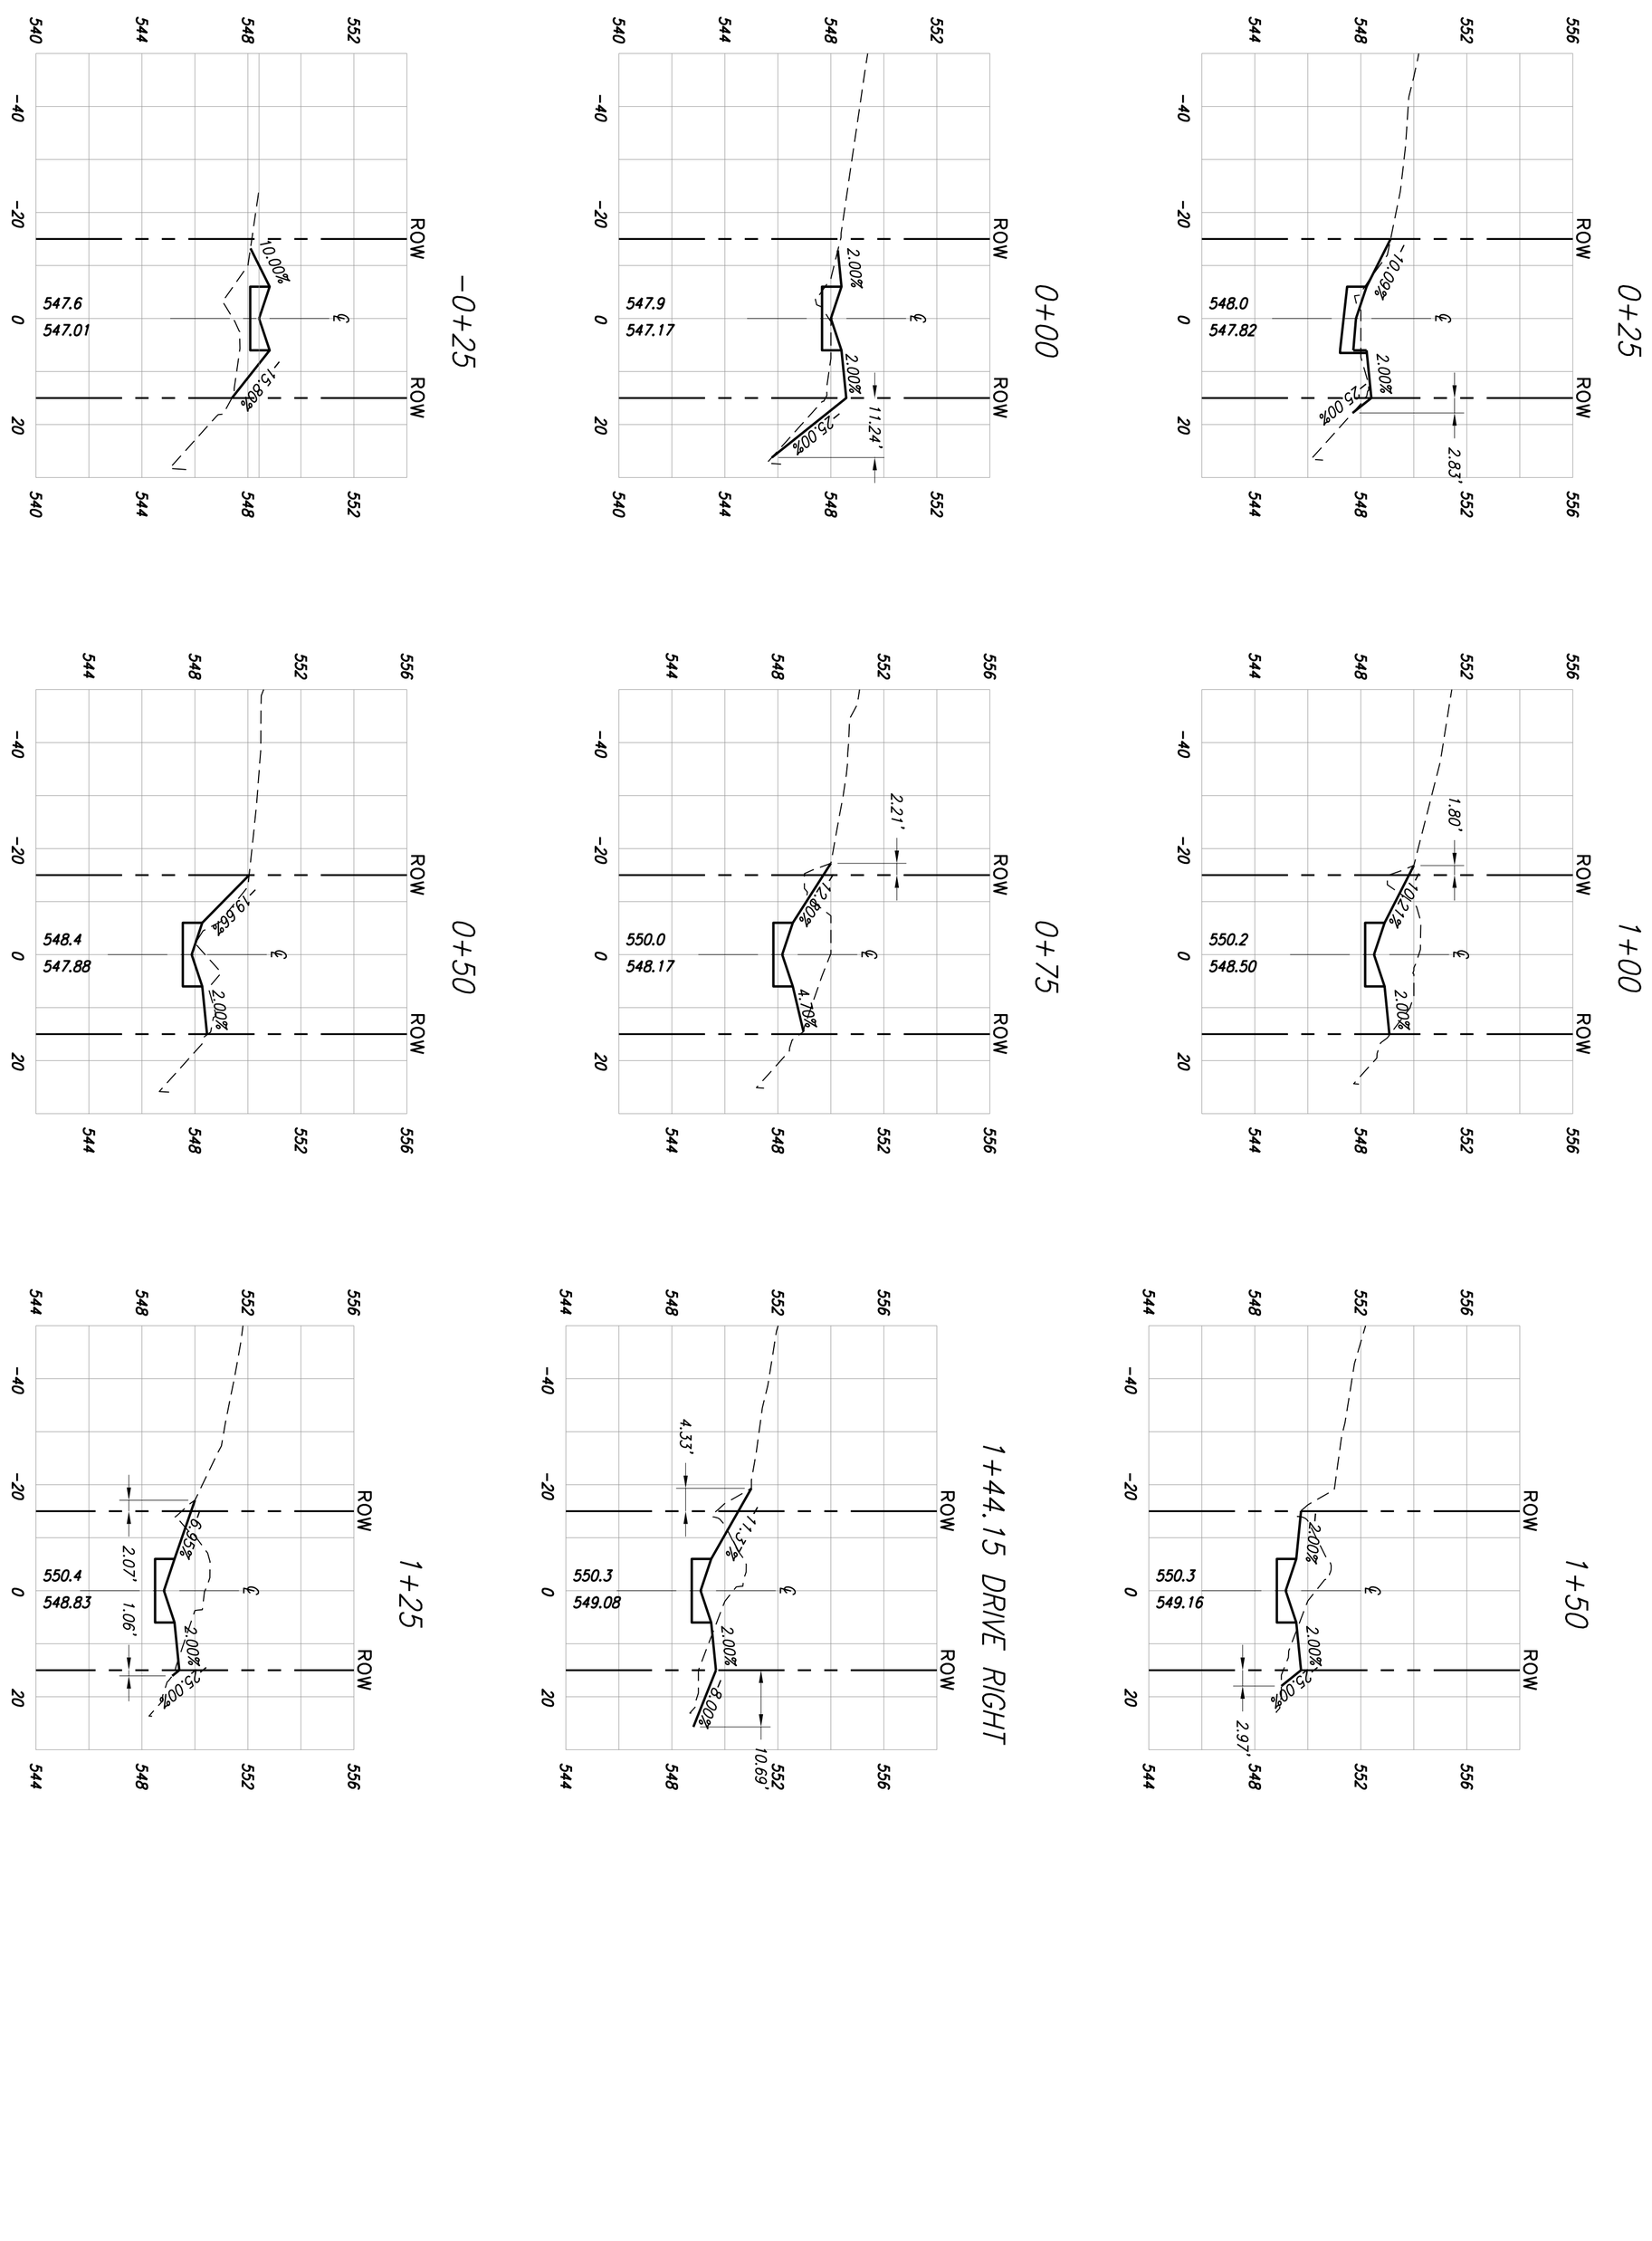


SCALE:
HORIZ: 1"=20'
VERT: 1"=4'

This Record Drawing is a combination of the sealed engineering contract drawings for this project, modified by information furnished by the contractor reflecting changes in the Project made during construction. The original sealed drawings are on file at the offices of

FREESE AND NICHOLS, INC.
4055 INTERNATIONAL PLAZA, SUITE 200
FORT WORTH, TEXAS 76109-4895
(817) 735-7300

RECORD DRAWINGS PREPARED ON:
7/13/2007

SHEET XS-4
SEQ.

| NO. | ISSUE | BY | DATE |
|---|---|---|---|
| | | | |
| | | | |
| | | | |
| | | | |
| | | | |

VERIFY SCALE 0 1 Bar is one inch on original drawing. If not one inch on this sheet, adjust scale.

FILE NAME CV-ROK-XS-SECT04.dwg

F&N JOB NO. ROK05274
DATE 3/01/2006
DESIGNED RAW
DRAWN NO/EAM
REVISED NO
CHECKED RAW

CITY OF ROCKWALL, TEXAS

# ROSS STREET REHABILITATION AND DRAINAGE IMPROVEMENTS

## LAMAR STREET (ALLEY) CROSS SECTIONS

Freese and Nichols
1701 N. Market Street, Suite 500, LB 51
Dallas, Texas 75202-2001
Phone - (214) 920-2500
Fax - (214) 920-2565

THE SEAL THAT ORIGINALLY APPEARED ON THIS DOCUMENT WAS AUTHORIZED BY TED B. SUGG P.E. .
TEXAS NO: 82775 ON 7/13/2007 .
ALTERATION OF A SEALED DOCUMENT WITHOUT PROPER NOTIFICATION OF THE RESPONSIBLE ENGINEER IS AN OFFENSE UNDER THE TEXAS ENGINEERING PRACTICE ACT.